

Adapted from Caltrans, 2009a, Caltrans ARS Online, [http://dap3.dot.ca.gov/shake\\_stable/](http://dap3.dot.ca.gov/shake_stable/)


The information on this graphic representation has been compiled from a variety of sources and is subject to change without notice. Kleinfelder makes no representations or warranties, express or implied, as to accuracy, completeness, timeliness or rights to the use of such information. This document is not intended for use as a land survey product nor is it designed or intended as a construction design document. The use or misuse of the information contained on this representation is at the sole risk of the party using or misusing the information.



PROJECT NO.	106226
DRAWN:	12-15-10
DRAWN BY:	ASW
CHECKED BY:	SGL
FILE NAME:	ARSFLMAP

<b>REGIONAL FAULT MAP (CALTRANS ARS ONLINE)</b>
PALO COMADO CANYON ROAD INTERCHANGE CITY OF AGOURA HILLS, CALIFORNIA

PLATE  
**3**

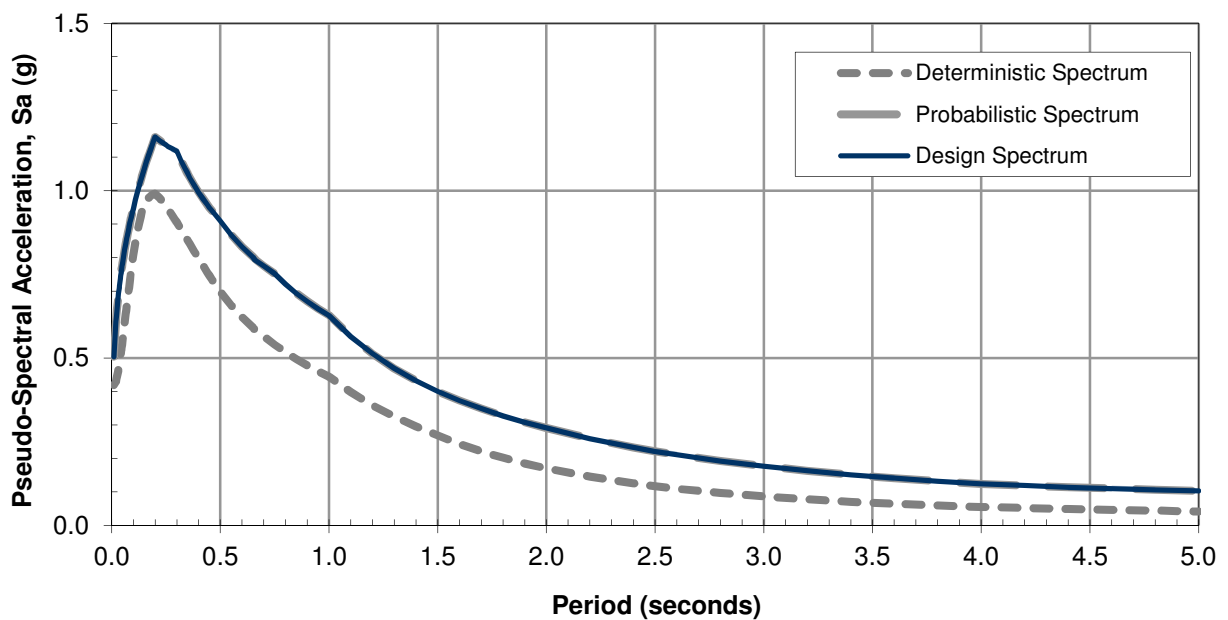

**SITE DATA**

Latitude (degrees):	34.1431	Shear Wave Velocity, $V_{s30}$ :	440 m/s
Longitude (degrees):	-118.7381	Depth to $V_s = 1.0$ km/s, $Z_{1.0}$ :	168 m
		Depth to $V_s = 2.5$ km/s, $Z_{2.5}$ :	2 km



PROJECT NO	106226
DRAWN:	2/8/11
DRAWN BY:	SGL
CHECKED BY:	EZ
FILE NAME:	KA_US101 Palo Comado

**PRELIMINARY DESIGN  
2009 CALTRANS ARS CURVES**

US101 Palo Comado Canyon Road OC  
Bridge No. 53-1678  
City of Agoura Hills, CA

PLATE

**4a**

**DESIGN ARS CURVE ORDINATES**

Period (s)	Sa (g)	Period (s)	Sa (g)
0.010	0.504	0.360	1.038
0.020	0.609	0.380	1.016
0.022	0.625	0.400	0.995
0.025	0.648	0.420	0.976
0.029	0.674	0.440	0.958
0.030	0.681	0.450	0.949
0.032	0.693	0.460	0.941
0.035	0.710	0.480	0.925
0.036	0.715	0.500	0.910
0.040	0.736	0.550	0.868
0.042	0.746	0.600	0.832
0.044	0.756	0.650	0.802
0.045	0.760	0.667	0.792
0.046	0.765	0.700	0.775
0.048	0.774	0.750	0.752
0.050	0.783	0.800	0.721
0.055	0.803	0.850	0.693
0.060	0.823	0.900	0.669
0.065	0.841	0.950	0.647
0.067	0.848	1.000	0.627
0.070	0.858	1.100	0.564
0.075	0.874	1.200	0.513
0.080	0.890	1.300	0.469
0.085	0.905	1.400	0.432
0.090	0.919	1.500	0.400
0.095	0.933	1.600	0.373
0.100	0.946	1.700	0.349
0.110	0.973	1.800	0.327
0.120	0.998	1.900	0.308
0.130	1.022	2.000	0.291
0.133	1.028	2.200	0.259
0.140	1.044	2.400	0.233
0.150	1.066	2.500	0.221
0.160	1.086	2.600	0.211
0.170	1.105	2.800	0.192
0.180	1.124	3.000	0.177
0.190	1.142	3.200	0.163
0.200	1.160	3.400	0.151
0.220	1.150	3.500	0.146
0.240	1.140	3.600	0.141
0.250	1.136	3.800	0.132
0.260	1.132	4.000	0.124
0.280	1.125	4.200	0.119
0.290	1.121	4.400	0.114
0.300	1.117	4.600	0.110
0.320	1.089	4.800	0.106
0.340	1.063	5.000	0.103



PROJECT NO: 106226  
 DRAWN: 2/8/11  
 DRAWN BY: SGL  
 CHECKED BY: EZ  
 FILE NAME: KA\_US101 Palo Comado

**PRELIMINARY DESIGN  
 2009 CALTRANS ARS CURVES**

US101 Palo Comado Canyon Road OC  
 Bridge No. 53-1678  
 City of Agoura Hills, CA

PLATE

**4b**



**APPENDIX A**

**ADVANCED PLANNING STUDY DRAWING AND  
PROPOSED BUILD EXHIBITS**

DIST	COUNTY	ROUTE	POST MILES TOTAL PROJECT
07	LA	101	33.69

City of Agoura Hills  
30001 Ladyface Court  
Agoura Hills, CA 91301  
(818) 597-7300

**Kimley-Horn and Associates, Inc.**  
© 2011 KIMLEY-HORN AND ASSOCIATES, INC.

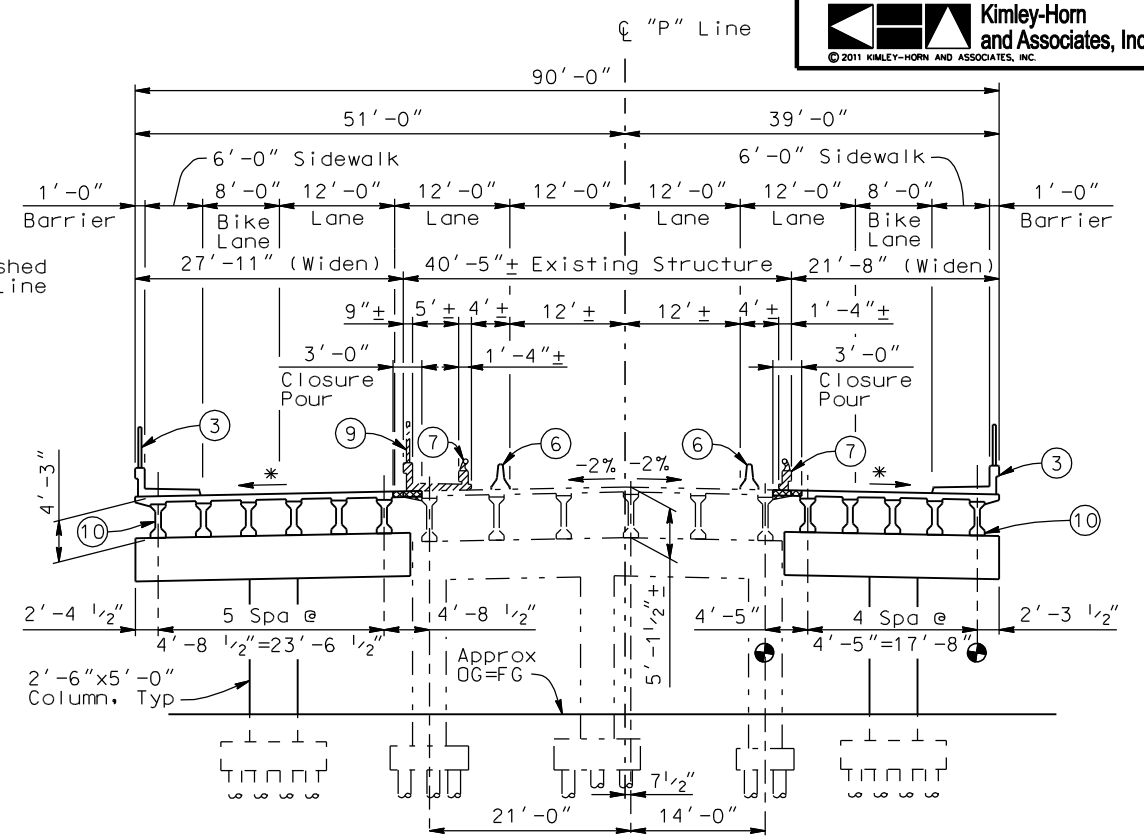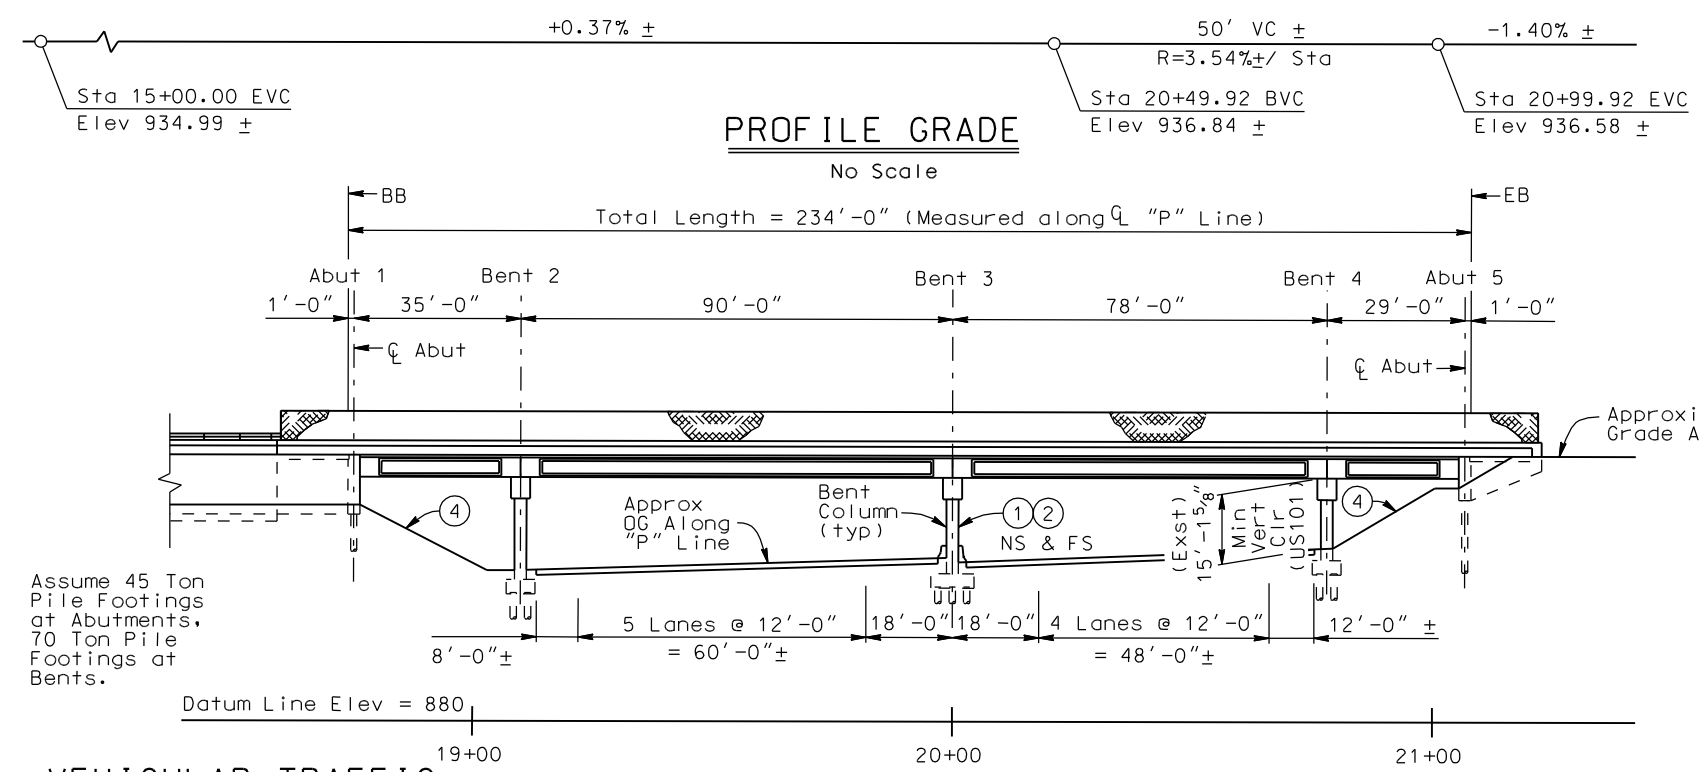


- LEGEND:**
- Indicates Point of Minimum Vertical Clearance
  - ETW Existing: 15.14' EP Existing: 14.75'
  - ETW Proposed: 15.53' EP Proposed: 15.14'
  - ▨ Indicates Removal Structure
  - ▩ Indicates Closure Pour

- NOTES:**
- Paint "Br No. 53-1678"
  - Paint "Palo Comado Canyon Road OC"
  - Concrete Barrier Type 26 (Mod) w/Chain Link Railing Type 7
  - Concrete Slope Paving
  - Structure Approach Slab Type N(30S)
  - Temporary Railing Type K
  - Remove and Salvage Existing Type 1 Barrier Railing
  - Structure Approach Type R(30D)
  - Remove and Salvage Existing Pipe Railing
  - Precast P/S Concrete I Girder (42")
  - Relocate Existing Bridge Mounted Signs.

Date of Estimate	= 1/6/11
Bridge Removal	=
Structure Depth	= 4'-3"
Length	= 234'-0"
Width (Widened)	= 49'-7"
Area (Widened)	= 11,603 SF
Cost/Sf Including 10% Mobilization & 25% Contingency	= \$266
<b>Total Cost</b>	<b>= \$3,080,000</b>

- VEHICULAR TRAFFIC**
- New Alignment. No traffic at the site.
  - Traffic will be detoured away from site.
  - Traffic will be carried on the structure.
  - Traffic will pass under the Structure on US 101
- A. X No falsework required over traffic  
B. Falsework openings required

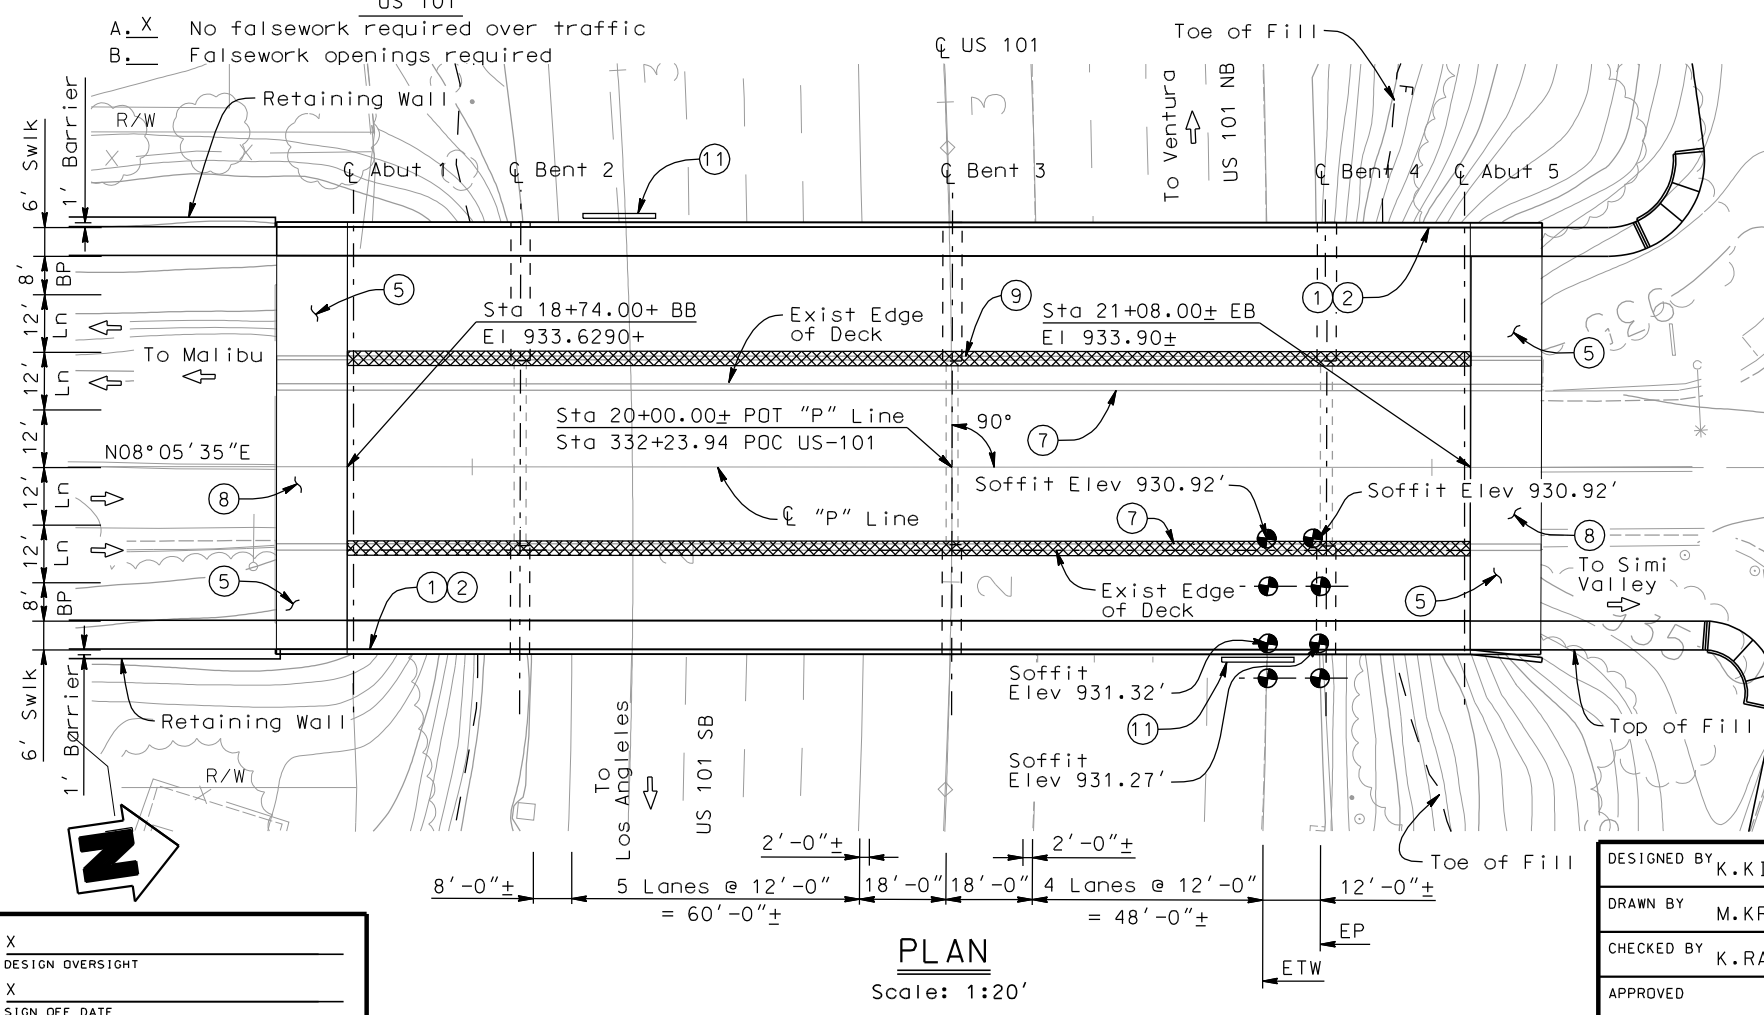



DESIGNED BY	K. KIMM	DATE	01/11
DRAWN BY	M. KRZYZEWSKI	DATE	01/11
CHECKED BY	K. RAMANATHAN	DATE	01/11
APPROVED		DATE	


X  
PROJECT ENGINEER

<b>ALTERNATIVE 2</b>	
<b>GENERAL PLAN</b>	
<b>PALO COMADO CANYON RD OC (WIDEN)</b>	
BRIDGE NO. 53-1678	UNIT: X
SCALE: AS NOTED	PROJECT NUMBER & PHASE: EA: 25720

DIST	COUNTY	ROUTE	POST MILES TOTAL PROJECT
07	LA	101	33.69


**City of Agoura Hills**  
 30001 Ladyface Court  
 Agoura Hills, CA 91301  
 (818) 597-7300



**Kimley-Horn and Associates, Inc.**  
 © 2011 KIMLEY-HORN AND ASSOCIATES, INC.

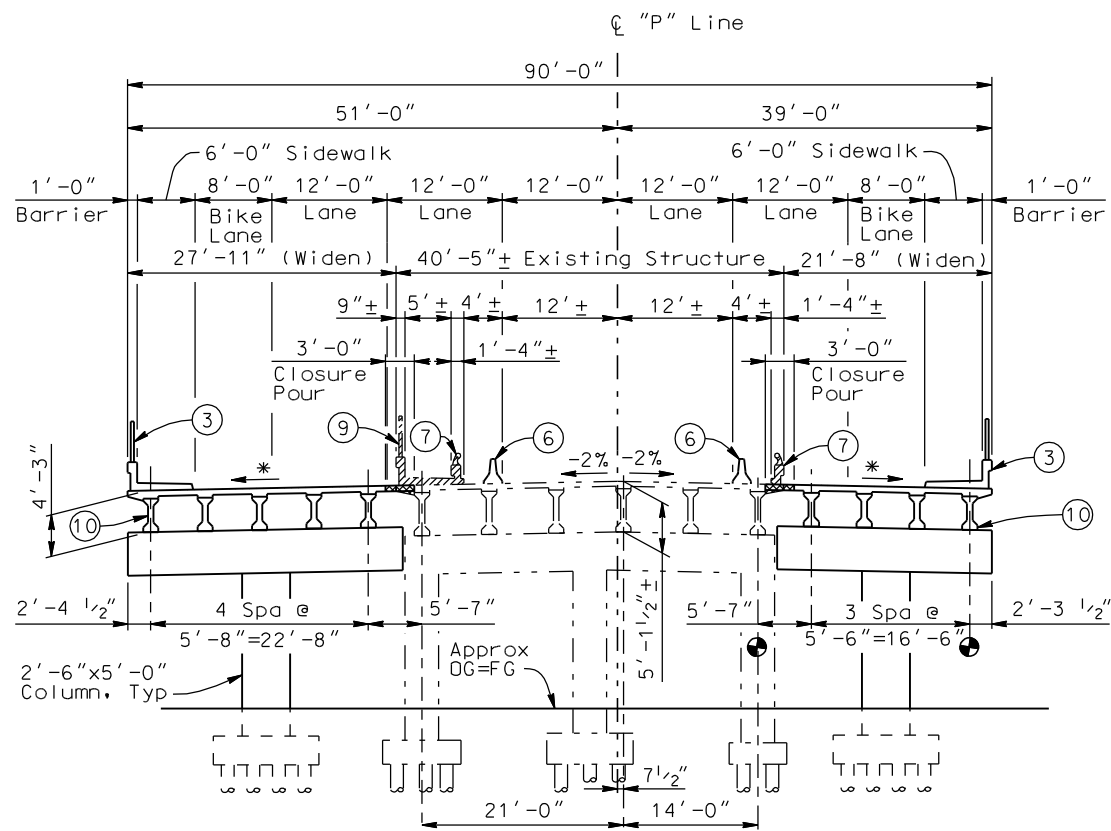

**TYPICAL SECTION - SPANS 1, 3 AND 4**

Scale: 1:10'

\* Match Exist Slope

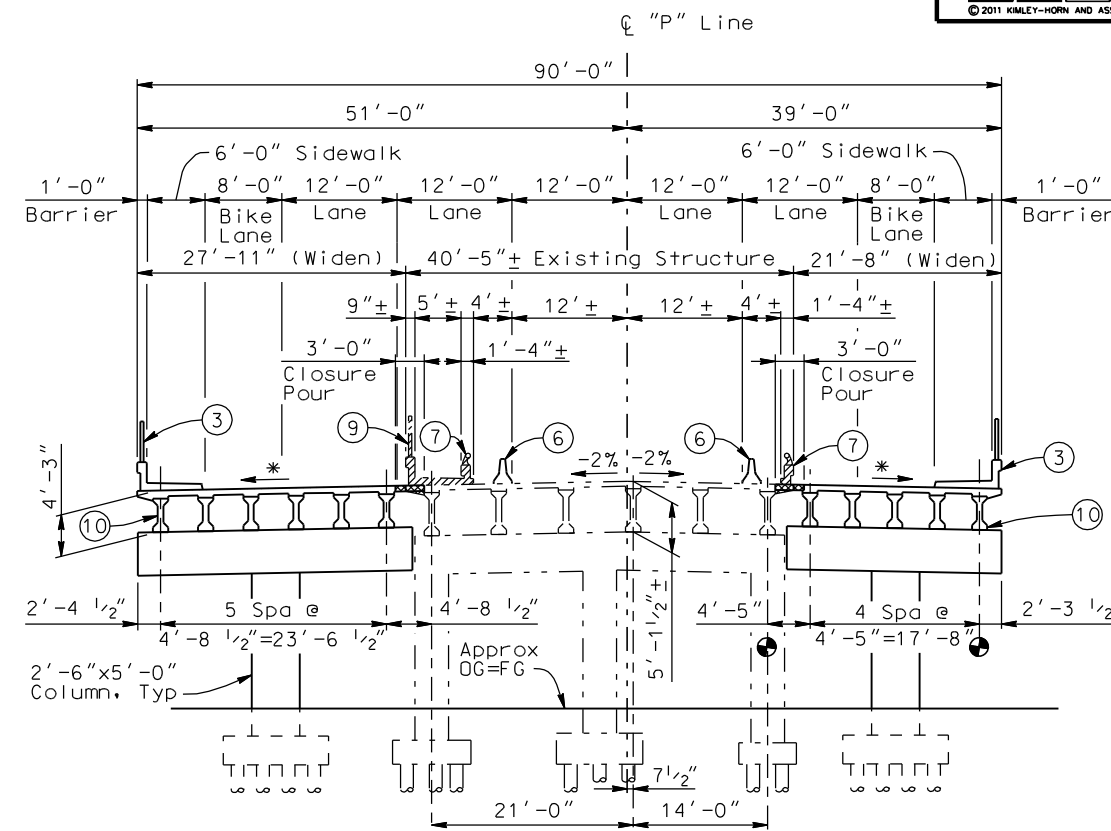

**TYPICAL SECTION - SPAN 2**

Scale: 1:10'

\* Match Exist Slope

**GENERAL NOTES:**

1. General Plan & Elevation for Alternative 2A similar to Alternative 2.

**NOTES:**

- 1 Paint "Br No. 53-1678"
- 2 Paint "Palo Comado Canyon Road OC"
- 3 Concrete Barrier Type 26 (Mod) w/Chain Link Railing Type 7
- 6 Temporary Railing Type K
- 7 Remove and Salvage Existing Type 1 Barrier Railing
- 9 Remove and Salvage Existing Pipe Railing
- 10 Precast P/S Concrete I Girder (42")



Date of Estimate	= 1/6/11
Bridge Removal	=
Structure Depth	= 4'-3"
Length	= 234'-0"
Width (Widened)	= 49'-7"
Area (Widened)	= 11,603 SF
Cost/Sf Including 10% Mobilization & 25% Contingency	= \$255
Total Cost	= \$2,950,000

X	DESIGN OVERSIGHT
X	SIGN OFF DATE

DESIGNED BY	K. KIMM	DATE	01/11
DRAWN BY	M. KRZYZEWSKI	DATE	01/11
CHECKED BY	K. RAMANATHAN	DATE	01/11
APPROVED		DATE	


X
PROJECT ENGINEER

<b>ALTERNATIVE 2A</b>	
<b>TYPICAL SECTIONS</b>	
<b>PLANNING STUDY</b>	
<b>PALO COMADO CANYON RD OC (WIDEN)</b>	
BRIDGE NO. 53-1678	UNIT: X
SCALE: AS NOTED	PROJECT NUMBER & PHASE: EA: 25720

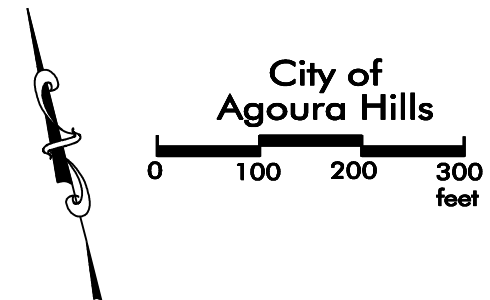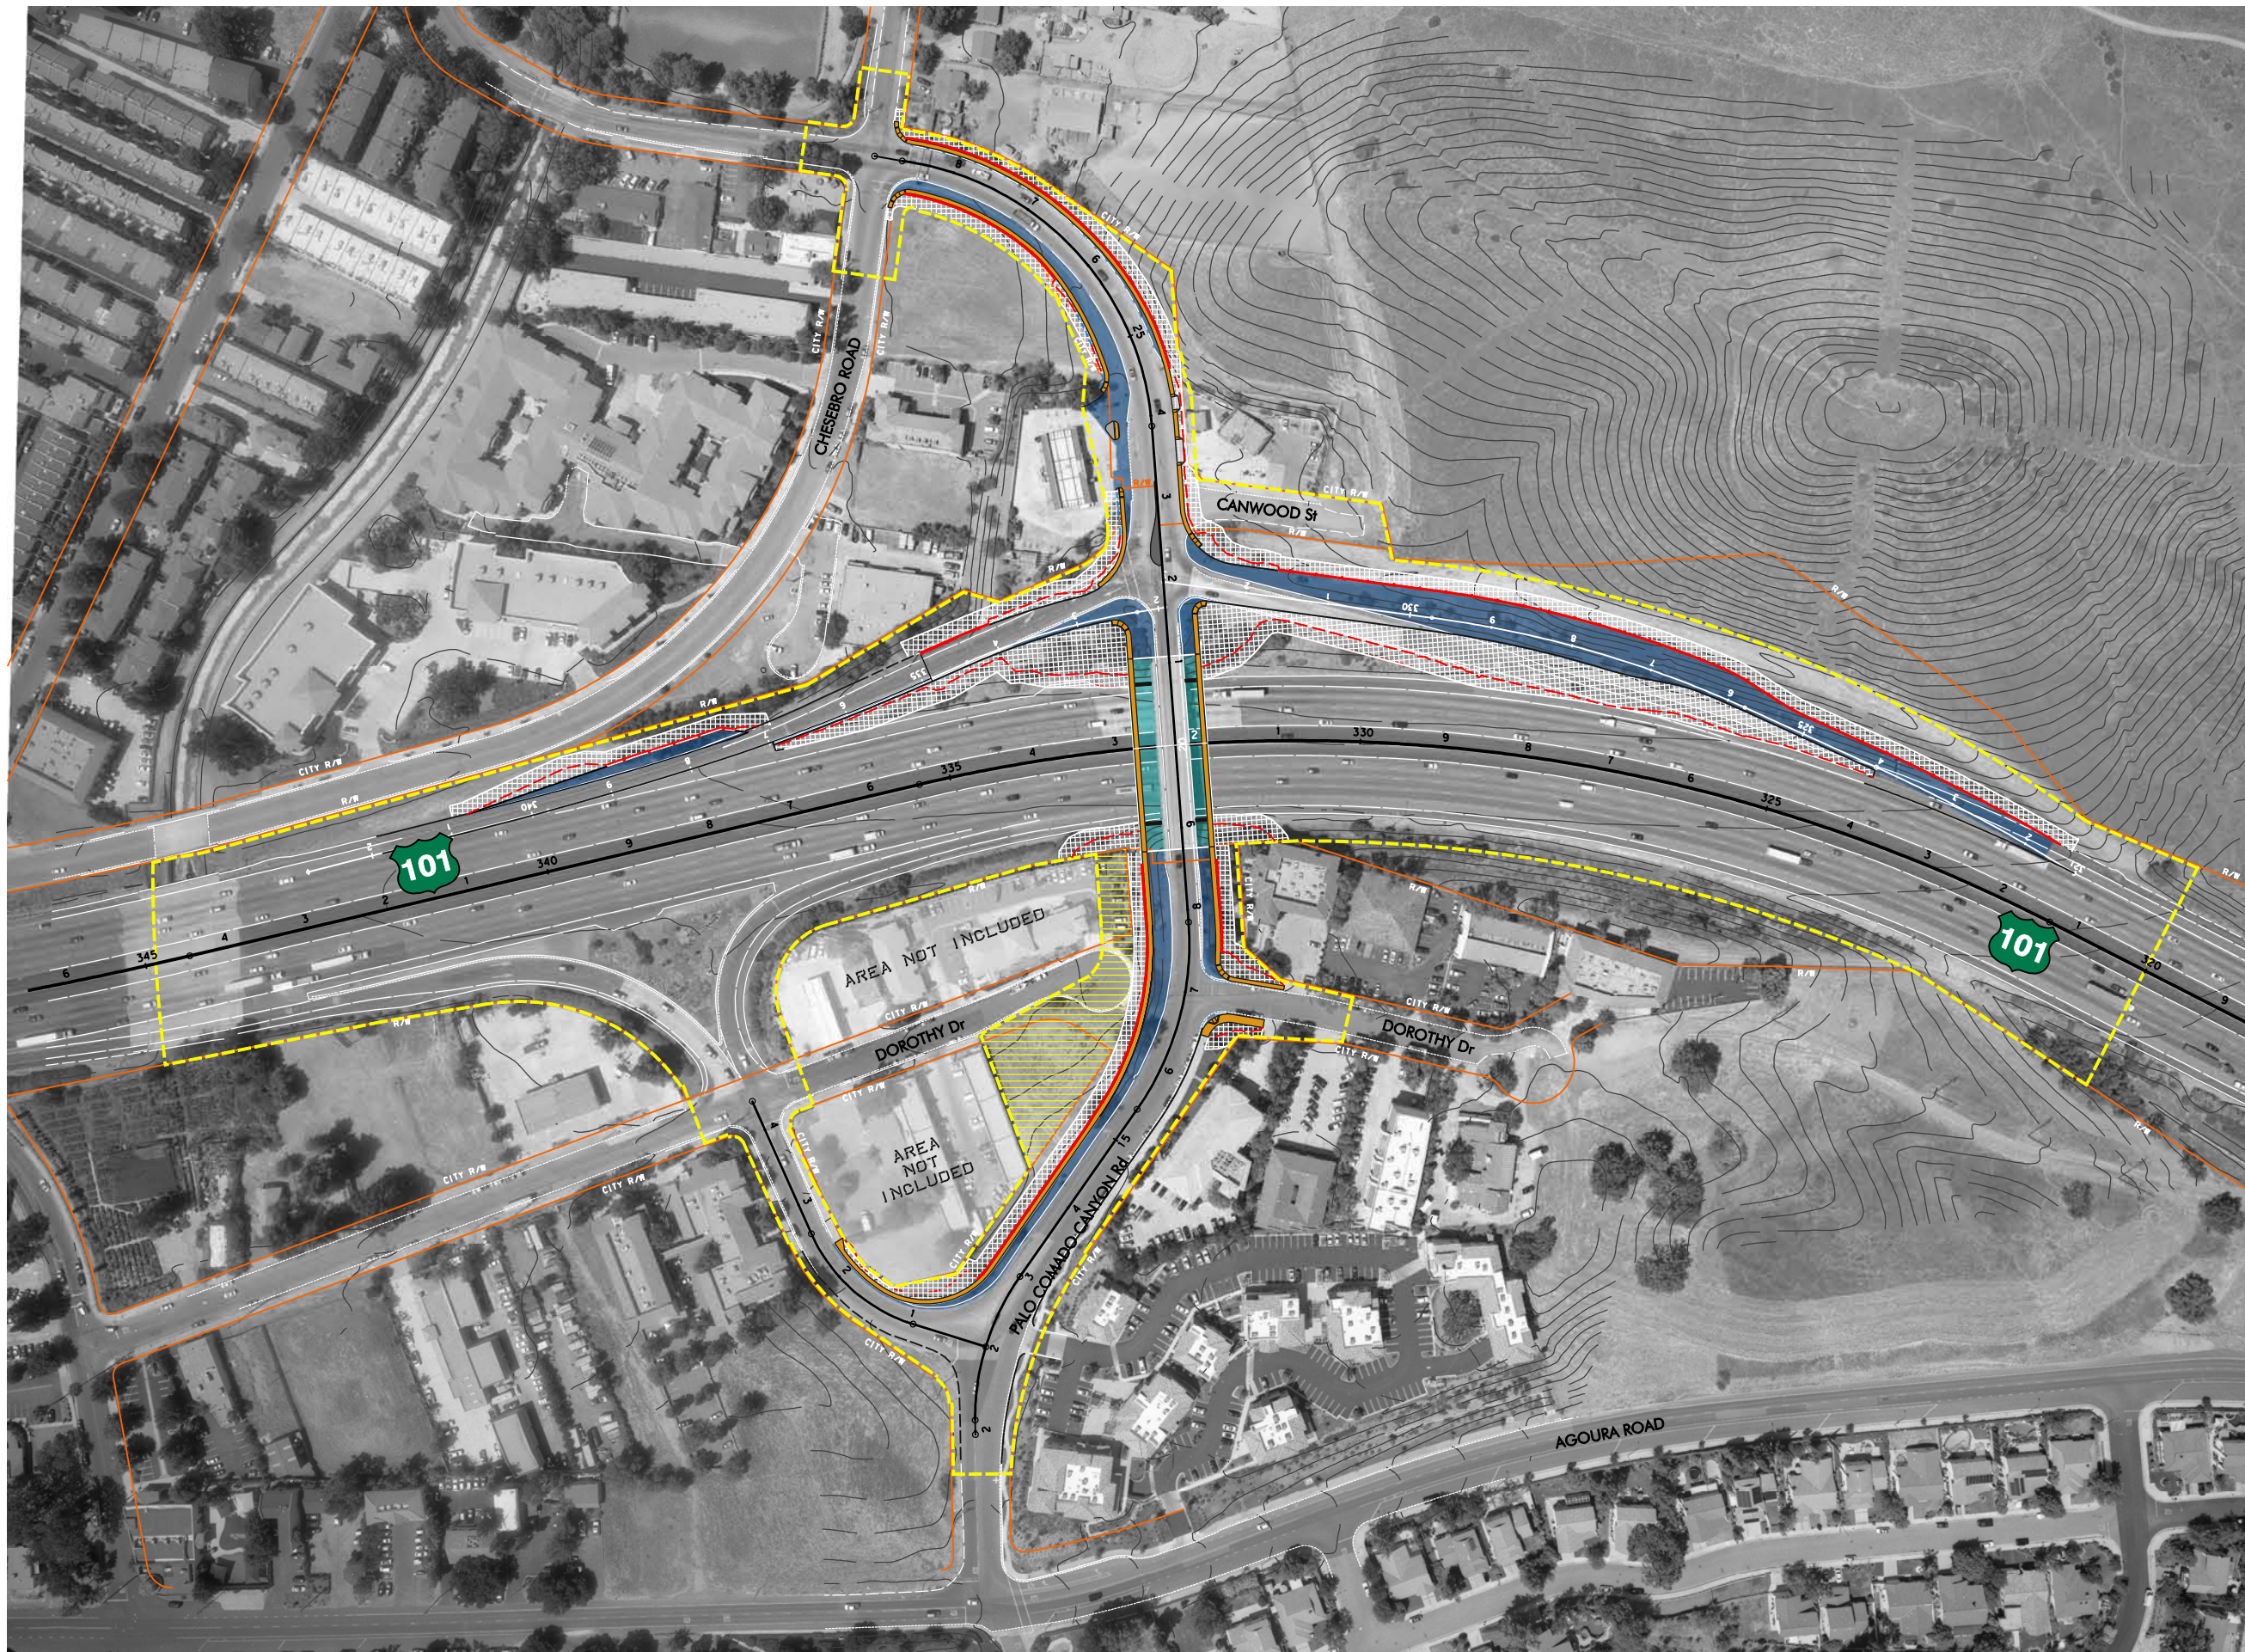

- Legend:**
- New Pavement Section
  - Widened Bridge Section
  - Widened Bridge Bent
  - Possible Limits of Disturbance
  - Possible Staging Area
  - Grading Limits
  - Cut & Fill Line
  - Retaining Wall
  - New Sidewalk

Proposed  
Build Alternative

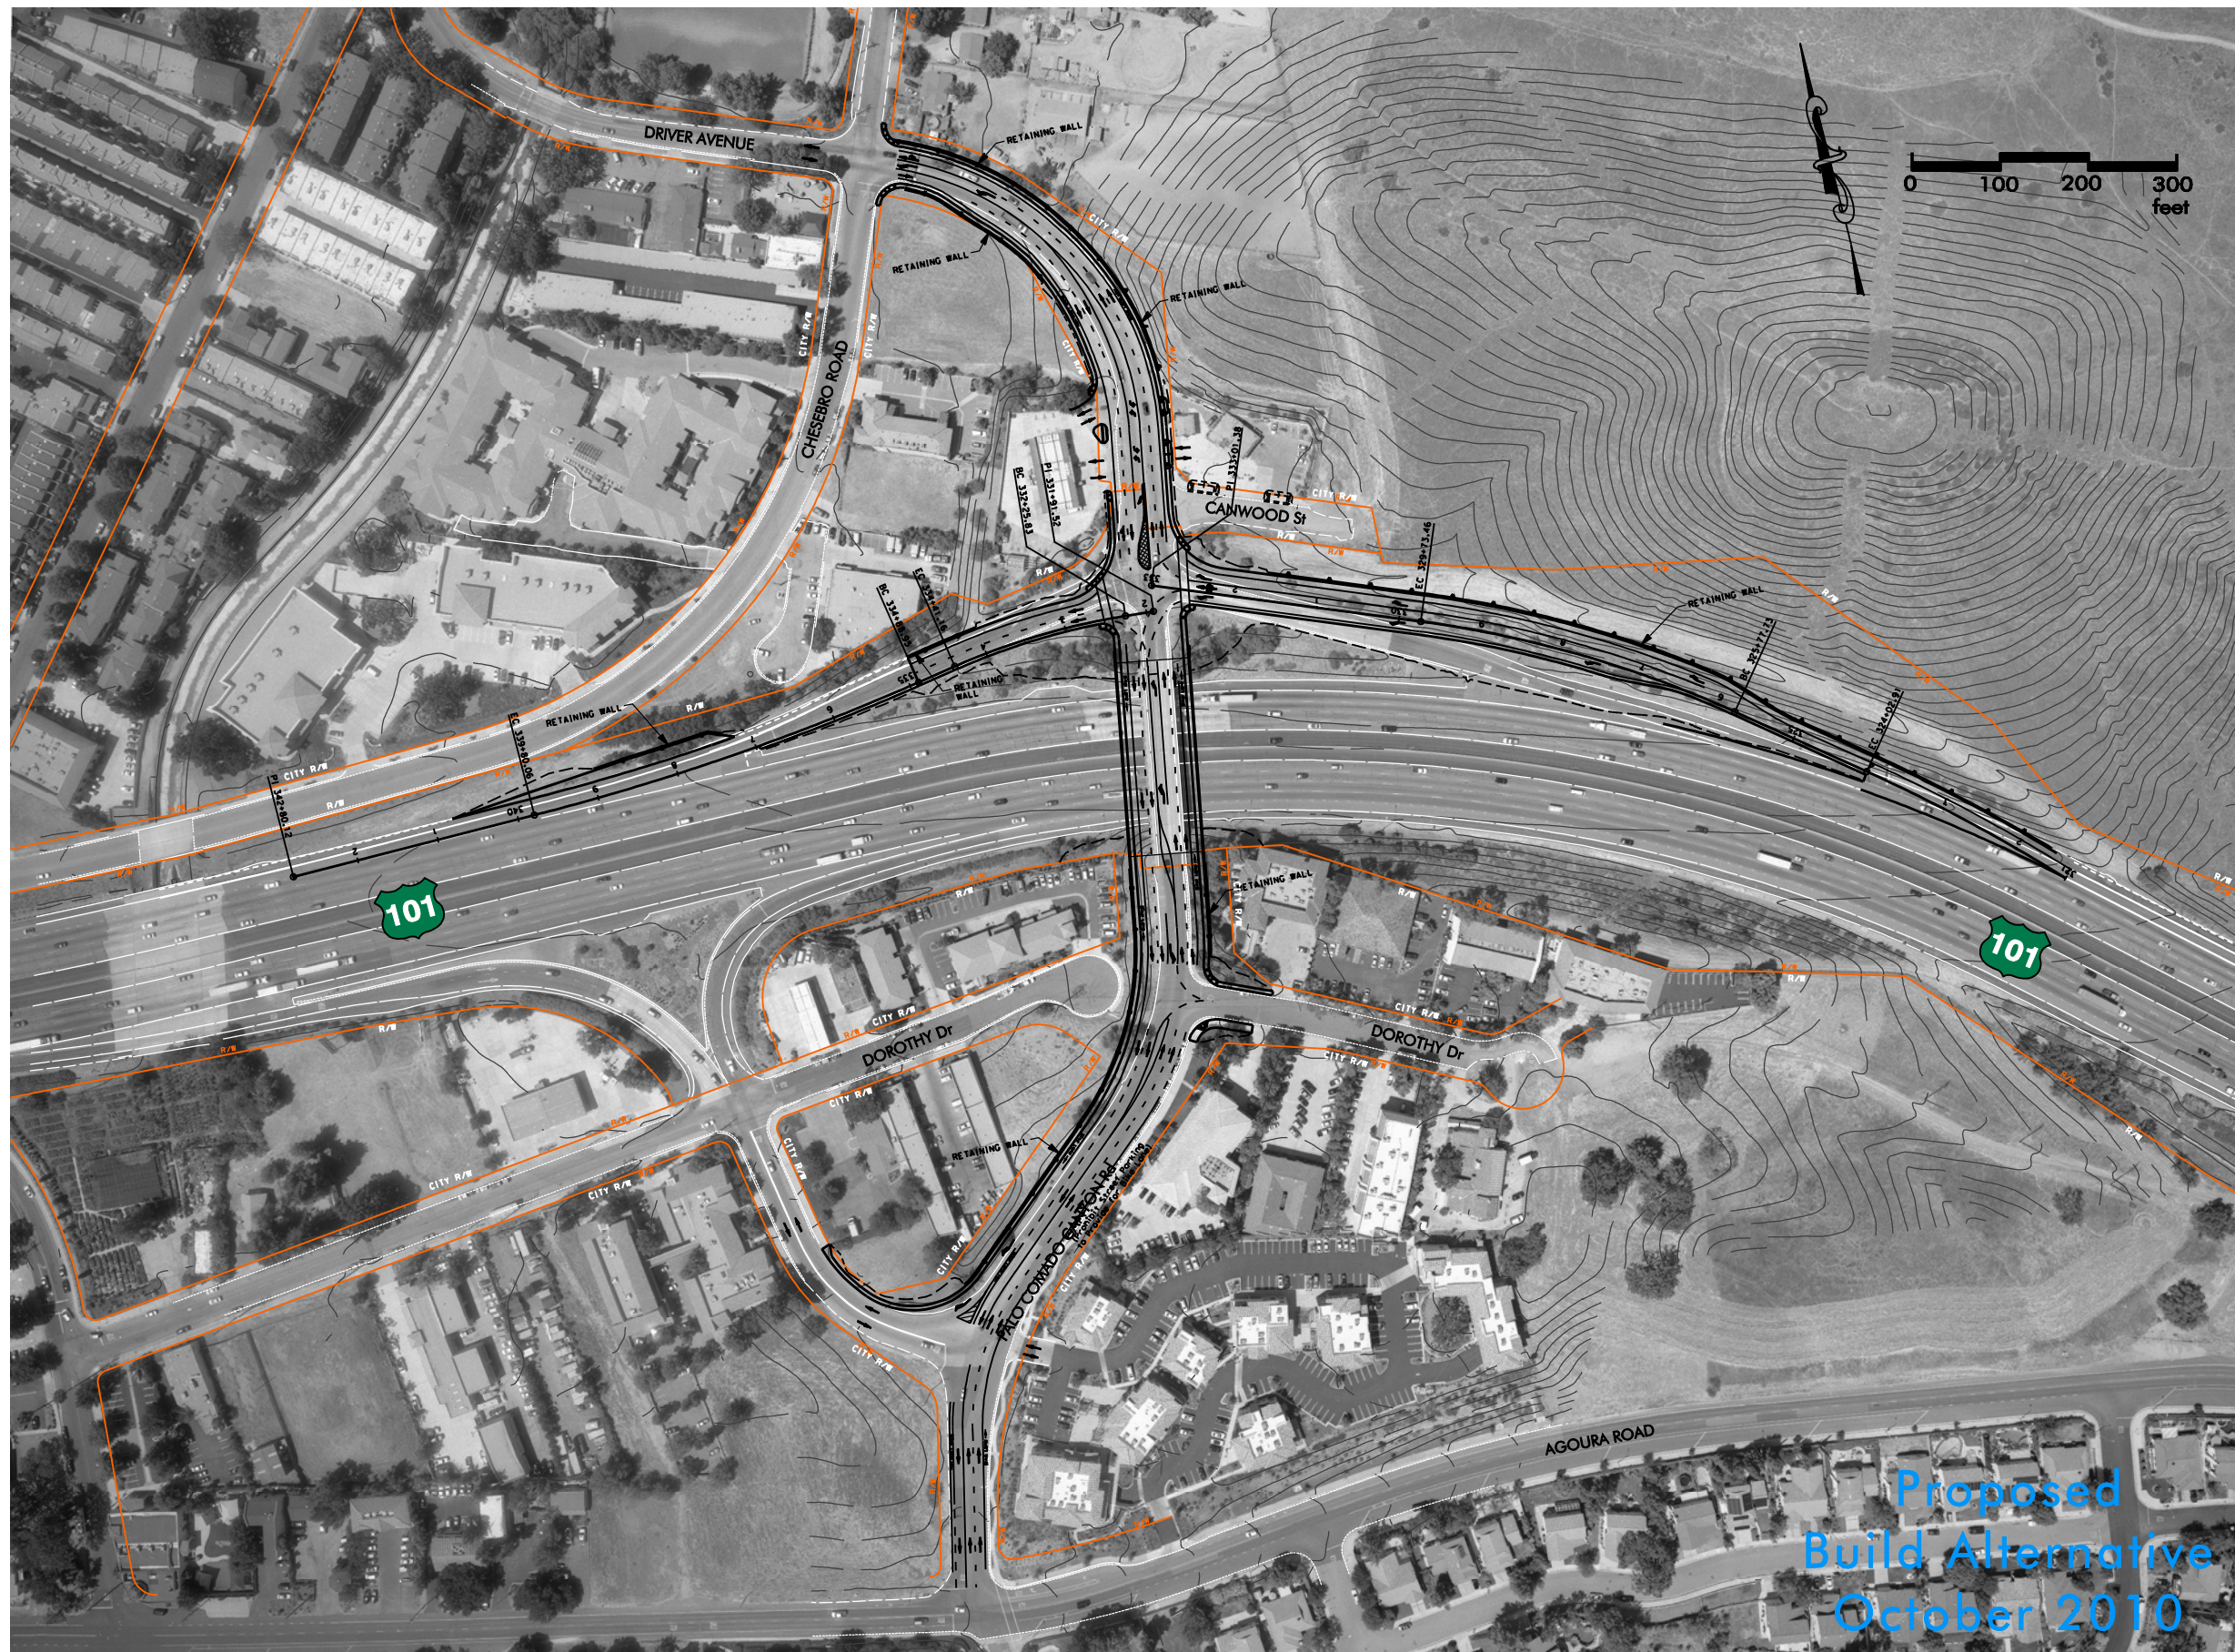

Proposed  
Build Alternative  
October 2010



Palo Comado Canyon Road  Interchange






**APPENDIX B**

**AS-BUILT PLANS FOR CHESEBRO ROAD OC  
BRIDGE NO 53-1678**

FED. ROAD DIST. NO.	STATE	PROJ. NO.	SHEET NO.	TOTAL SHEETS
7	CALIF.		57	151

DIST.	COUNTY	ROUTE	SECTION	POST MILE	TOTAL MILES
VII	LA	5		101	15


101  
 DATE APPROVED: 12/22/63  
 ENGINEER: [Signature]  
 CHECKED: [Signature]

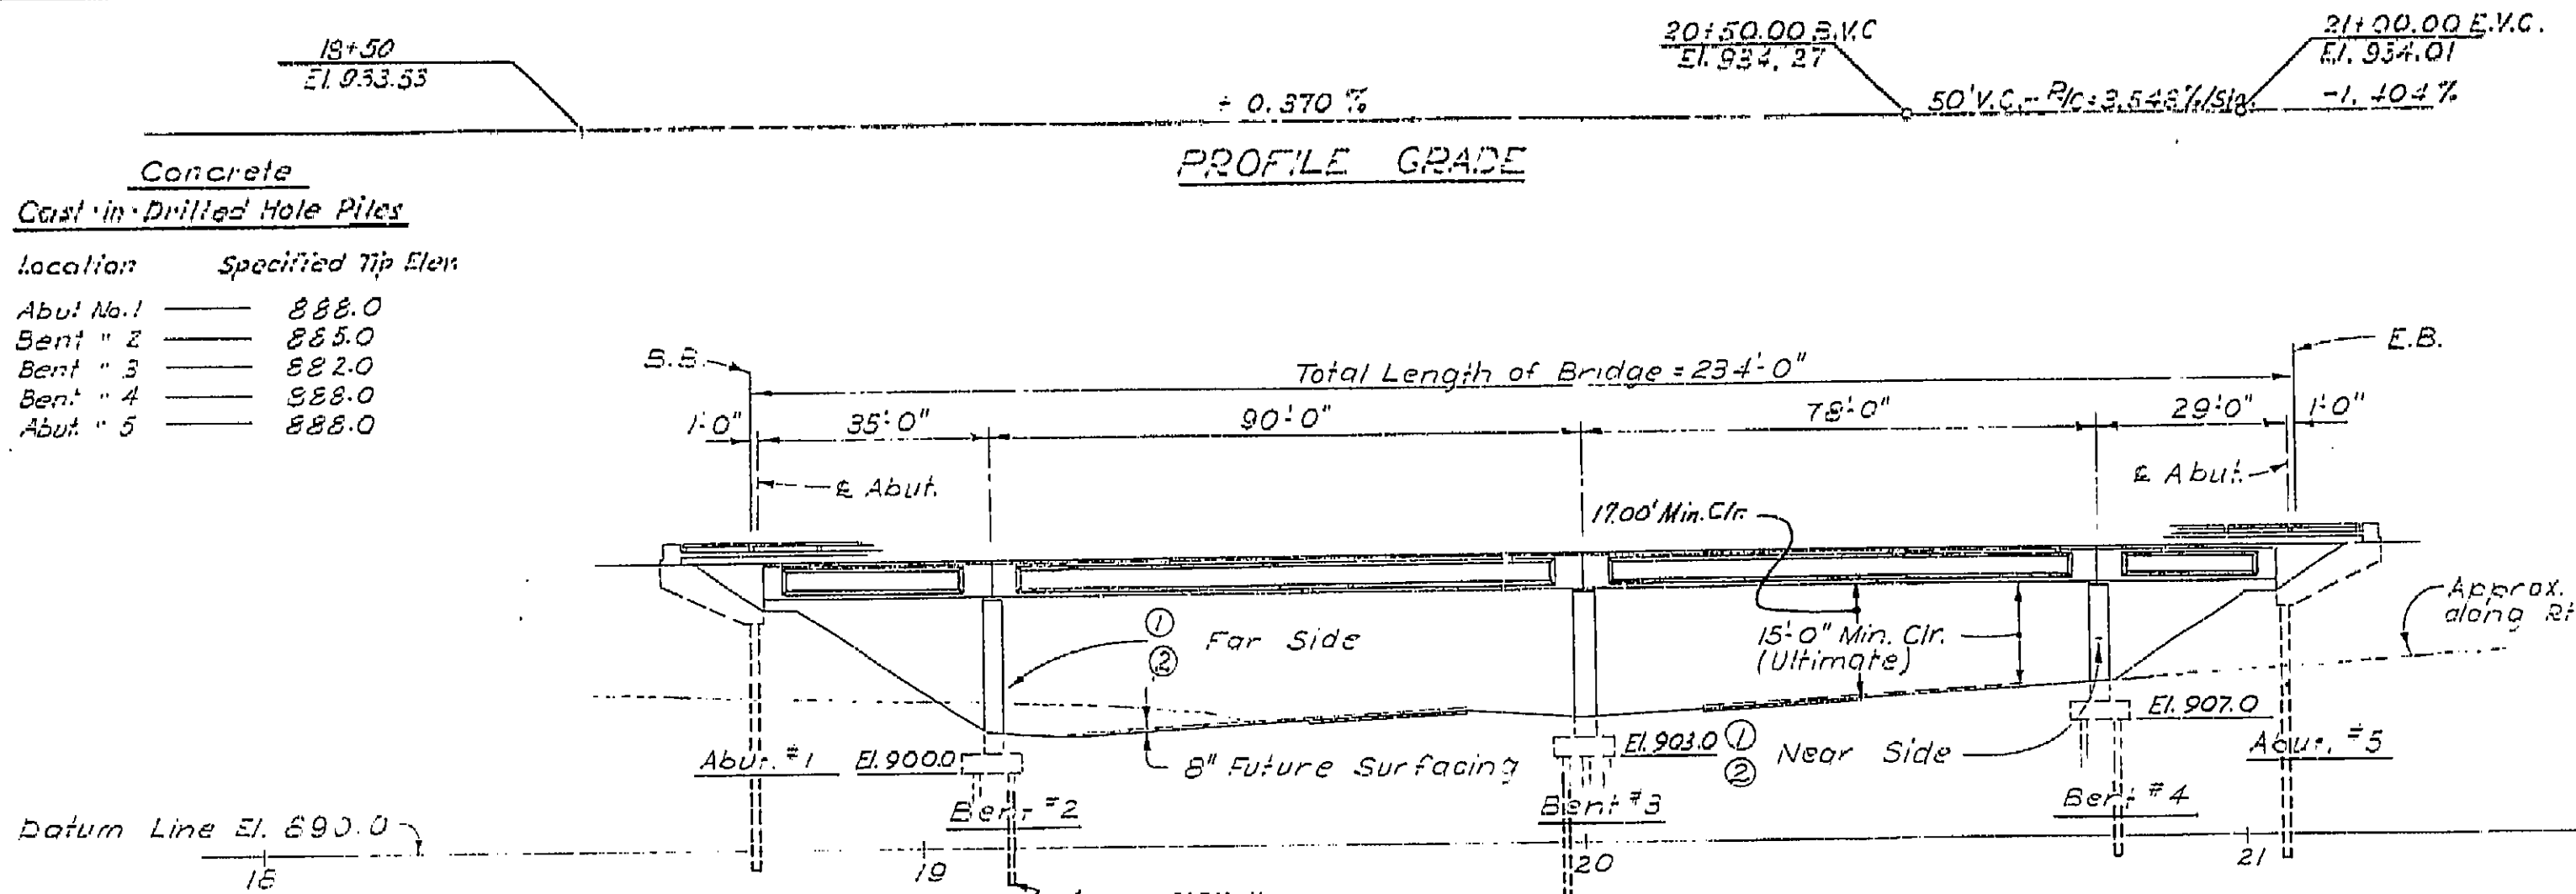


**Concrete Cast-in-Drilled Hole Piles**  
 location Specified Tip Elev.  
 Abut. #1 888.0  
 Bent #2 885.0  
 Bent #3 882.0  
 Bent #4 888.0  
 Abut. #5 888.0

**ELEVATION**  
 Scale: 1" = 20'-0"

① = Point Bridge No. & Date  
 ② = Point Chesebro Rd. O.C.  
 ⊙ Indicates point of minimum vertical clearance.

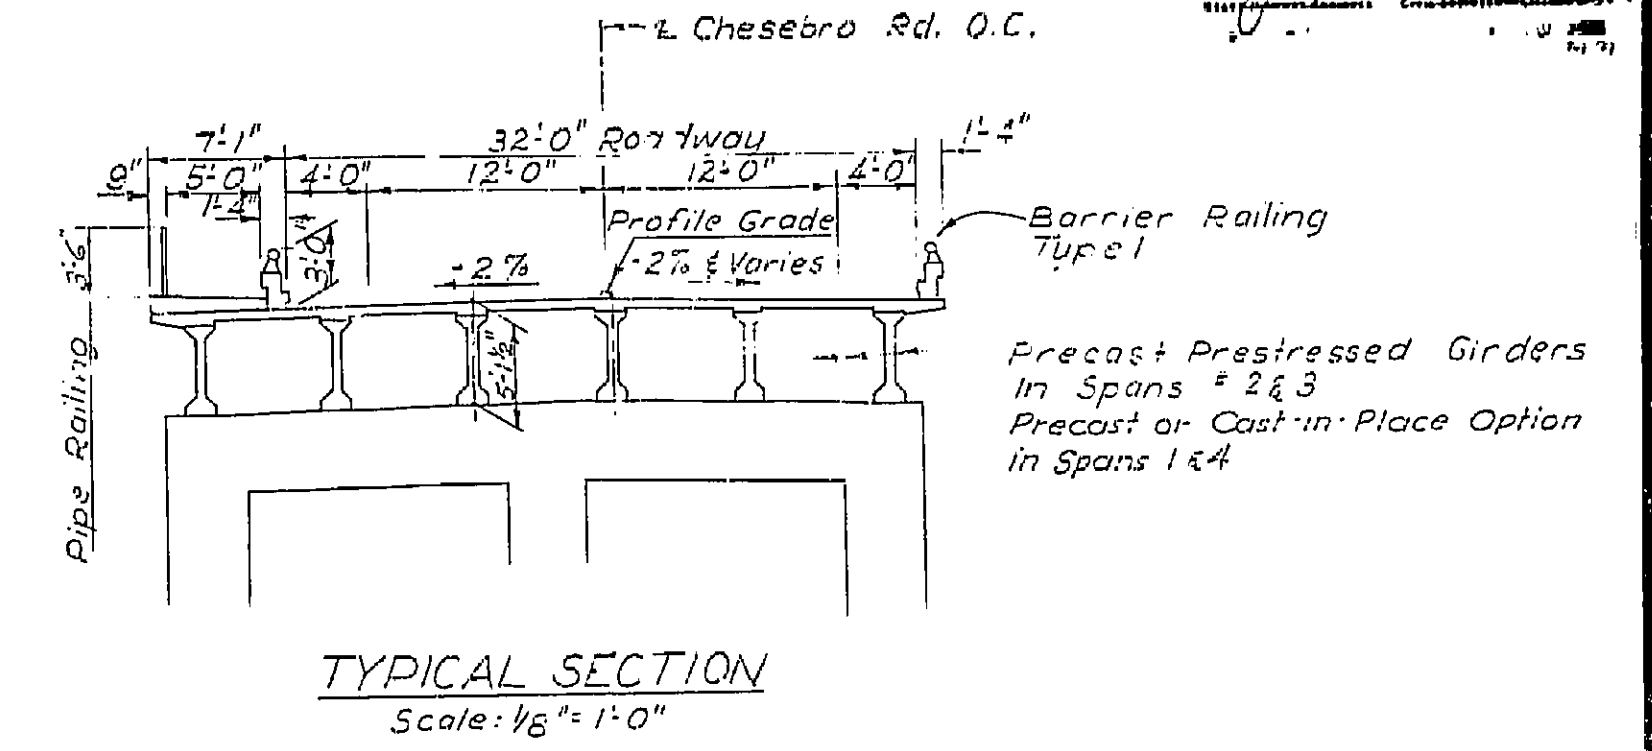

**TYPICAL SECTION**  
 Scale: 1/8" = 1'-0"

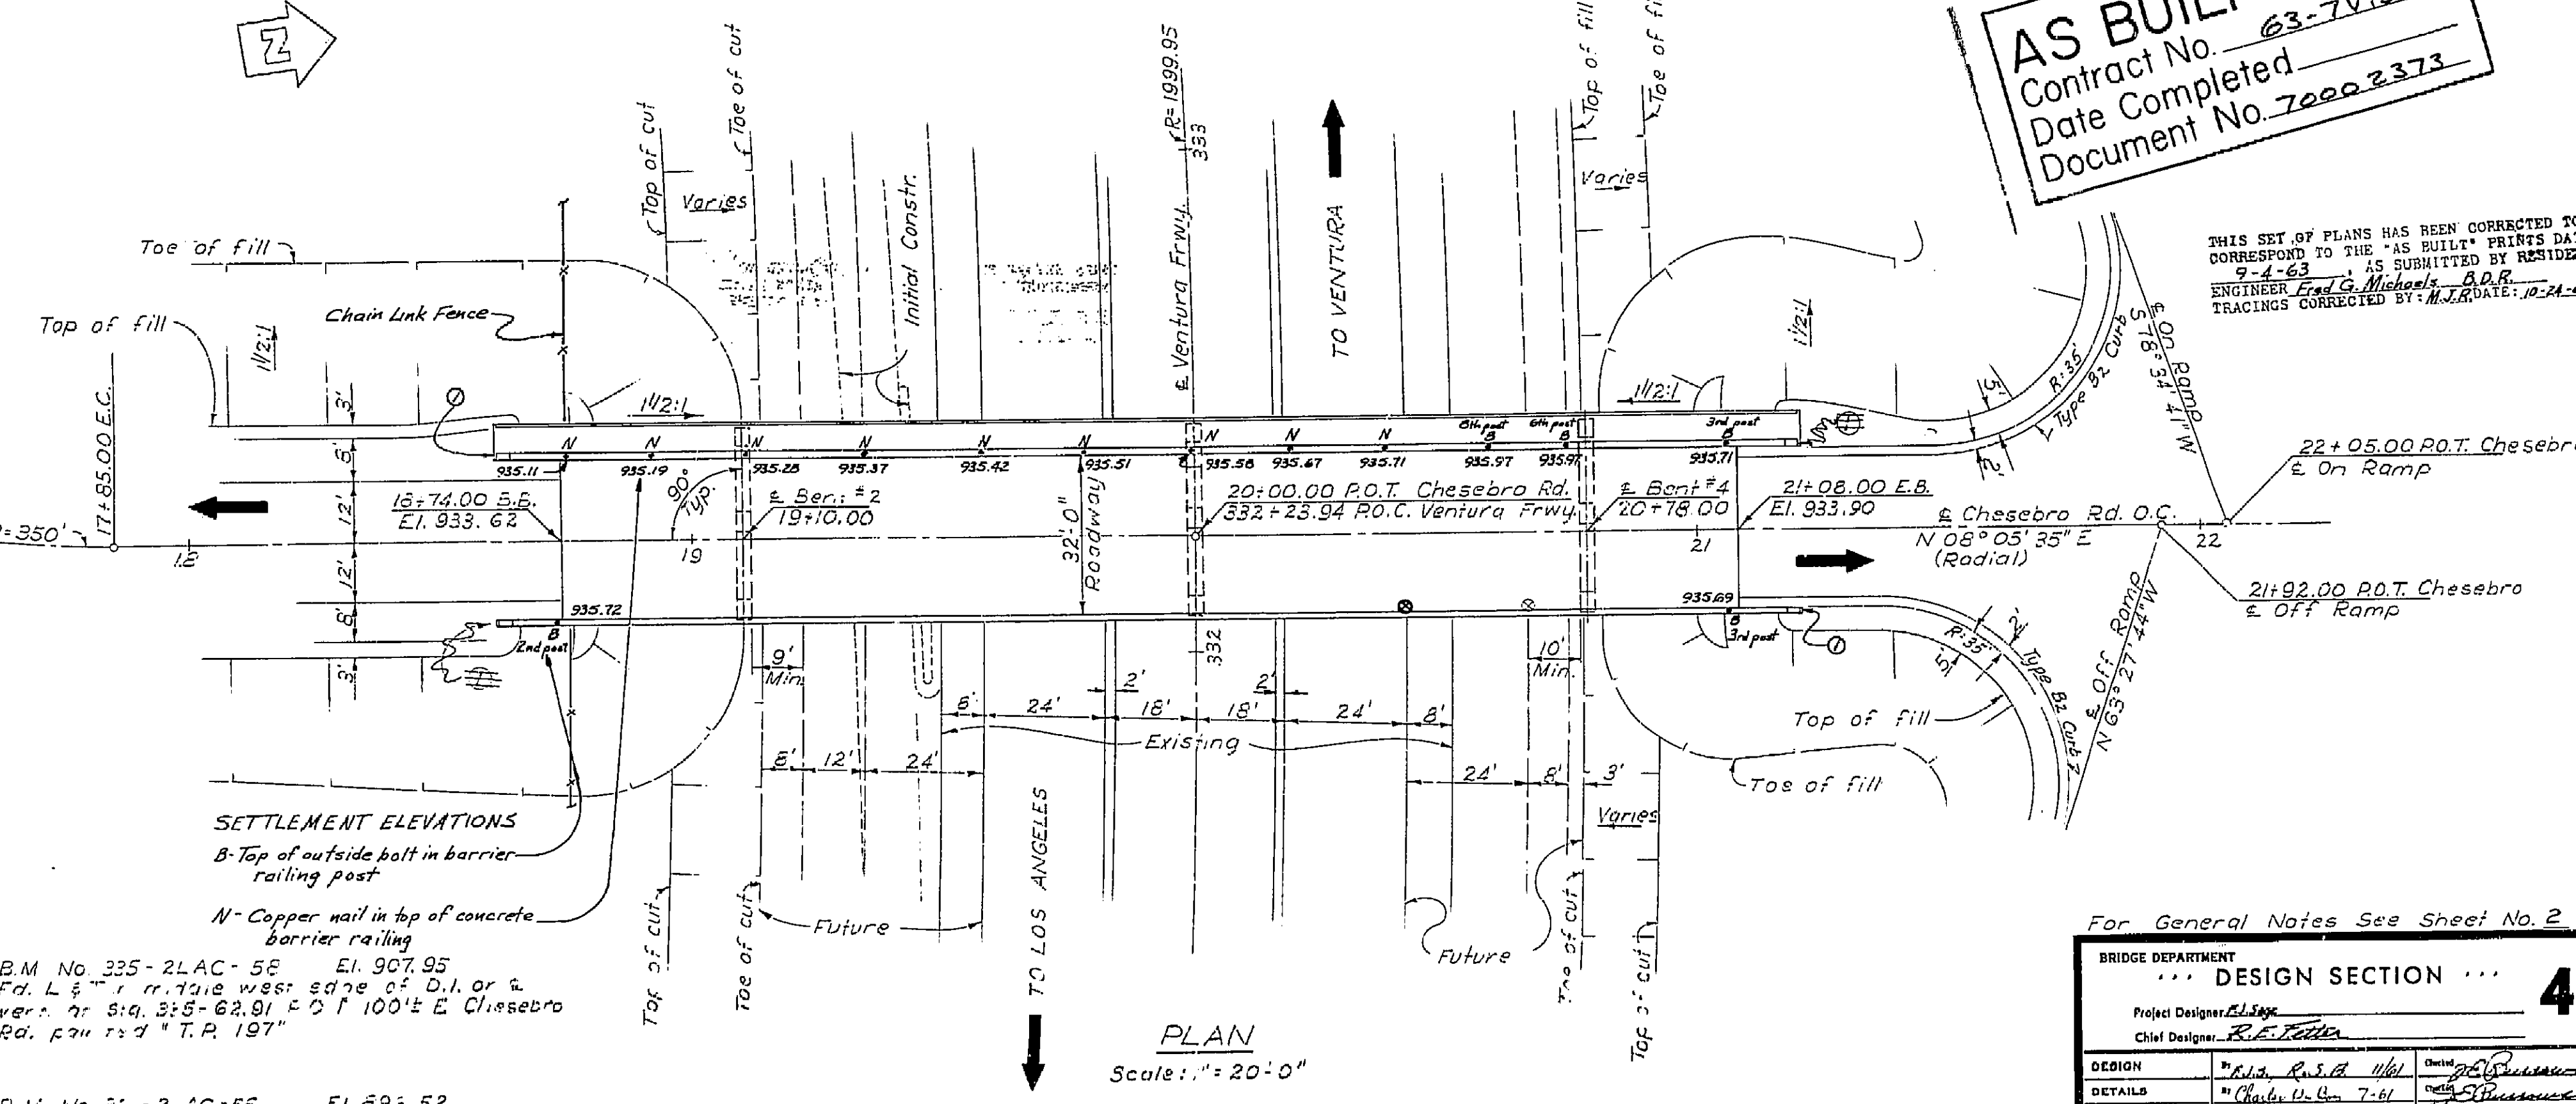

**PLAN**  
 Scale: 1" = 20'-0"

**AS BUILT PLANS**  
 Contract No. 63-7V13C58  
 Date Completed  
 Document No. 7000 2373

**INDEX TO PLANS**

Sheet No.	Title
1	General Plan
2	Grid Grades
3	Foundation Plan
4	Abutment Details
5	Bent Details
6	Typical Sections
7	Girder Layout
8	Girder Details Spans 1 & 4 - Precast Alternative
9	Girder Details Spans 1 & 4 - Cast-in-Place Alternative
10	Girder Details Spans 2 & 3
11	Diaphragm Details
12	Barrier Railing Sheet 1
13	Barrier Railing Sheet 2
14	Pipe Railing
15	Log of Test Borings

**APPROXIMATE QUANTITIES**

*STRUCTURE EXCAVATION (BRIDGE)	310 C.Y.
*STRUCTURE BACKFILL (BRIDGE)	180 C.Y.
16" C.I.D.H. CONCRETE PILING	1,210 L.F.
FURNISHING PC/PS CONCRETE GIRDERS (90'-0")	6 EA.
FURNISHING PC/PS CONCRETE GIRDERS (78'-0")	6 EA.
ERECTING PC/PS CONCRETE GIRDERS	12 EA.
*CLASS "A" CONCRETE (BRIDGE)	540 C.Y.
RUBBER WATERSTOPS	128 L.F.
JOINT SEALER	128 L.F.
*BAR REINFORCING STEEL (BRIDGE)	109,000 LBS.
MISCELLANEOUS METAL (BRIDGE)	400 LBS.
BARRIER RAILING (TYPE 1)	528 L.F.
PIPE BRIDGE RAILING (3'-6")	262 L.F.

\*FINAL QUANTITIES  
 Contract # 63-7V13C58  
 Note: Route Change (VII-LA-5)

For General Notes See Sheet No. 2

BRIDGE DEPARTMENT		DESIGN SECTION		4	
Project Designer: [Signature]					
Chief Designer: [Signature]					
DESIGN	[Signature]	DATE	[Signature]	DATE	[Signature]
DETAILS	[Signature]	DATE	[Signature]	DATE	[Signature]
QUANTITIES	[Signature]	DATE	[Signature]	DATE	[Signature]
SPECIFICATIONS	[Signature]	DATE	[Signature]	DATE	[Signature]
Approval Recommended by: [Signature]					

**VENTURA FREEWAY**

STATE OF CALIFORNIA  
 DEPARTMENT OF PUBLIC WORKS  
 DIVISION OF HIGHWAYS

**CHESEBRO ROAD OVERCROSSING**  
 LOCATED ABOUT 400 FEET EAST OF THE INTERSECTION OF  
 EXISTING CHESEBRO RD. AND VENTURA FRWY IN  
 LOS ANGELES COUNTY

**GENERAL PLAN**

SCALE AS NOTED BRIDGE 53-1878 FILE DRAWING C-531678-1

PREL. DRAWING NO. P-531678-1

I HEREBY CERTIFY THAT THIS IS A TRUE AND ACCURATE COPY OF THE ABOVE DOCUMENT TAKEN UNDER MY DIRECTION AND CONTROL ON THIS DATE IN SACRAMENTO, CALIFORNIA PURSUANT TO AUTHORIZATION BY THE DIRECTOR OF PUBLIC WORKS.


DATE: 11/22 SIGNATURE: [Signature] TITLE: [Title]



FED. ROAD DIST. NO.	STATE	F. & PROJECT NO.	SHEET NO.	TOTAL SHEETS
7	CALIF.		53	91

VII LA 5

*J. J. Johnston*  
 DATE APPROVED: Dec 18, 1952

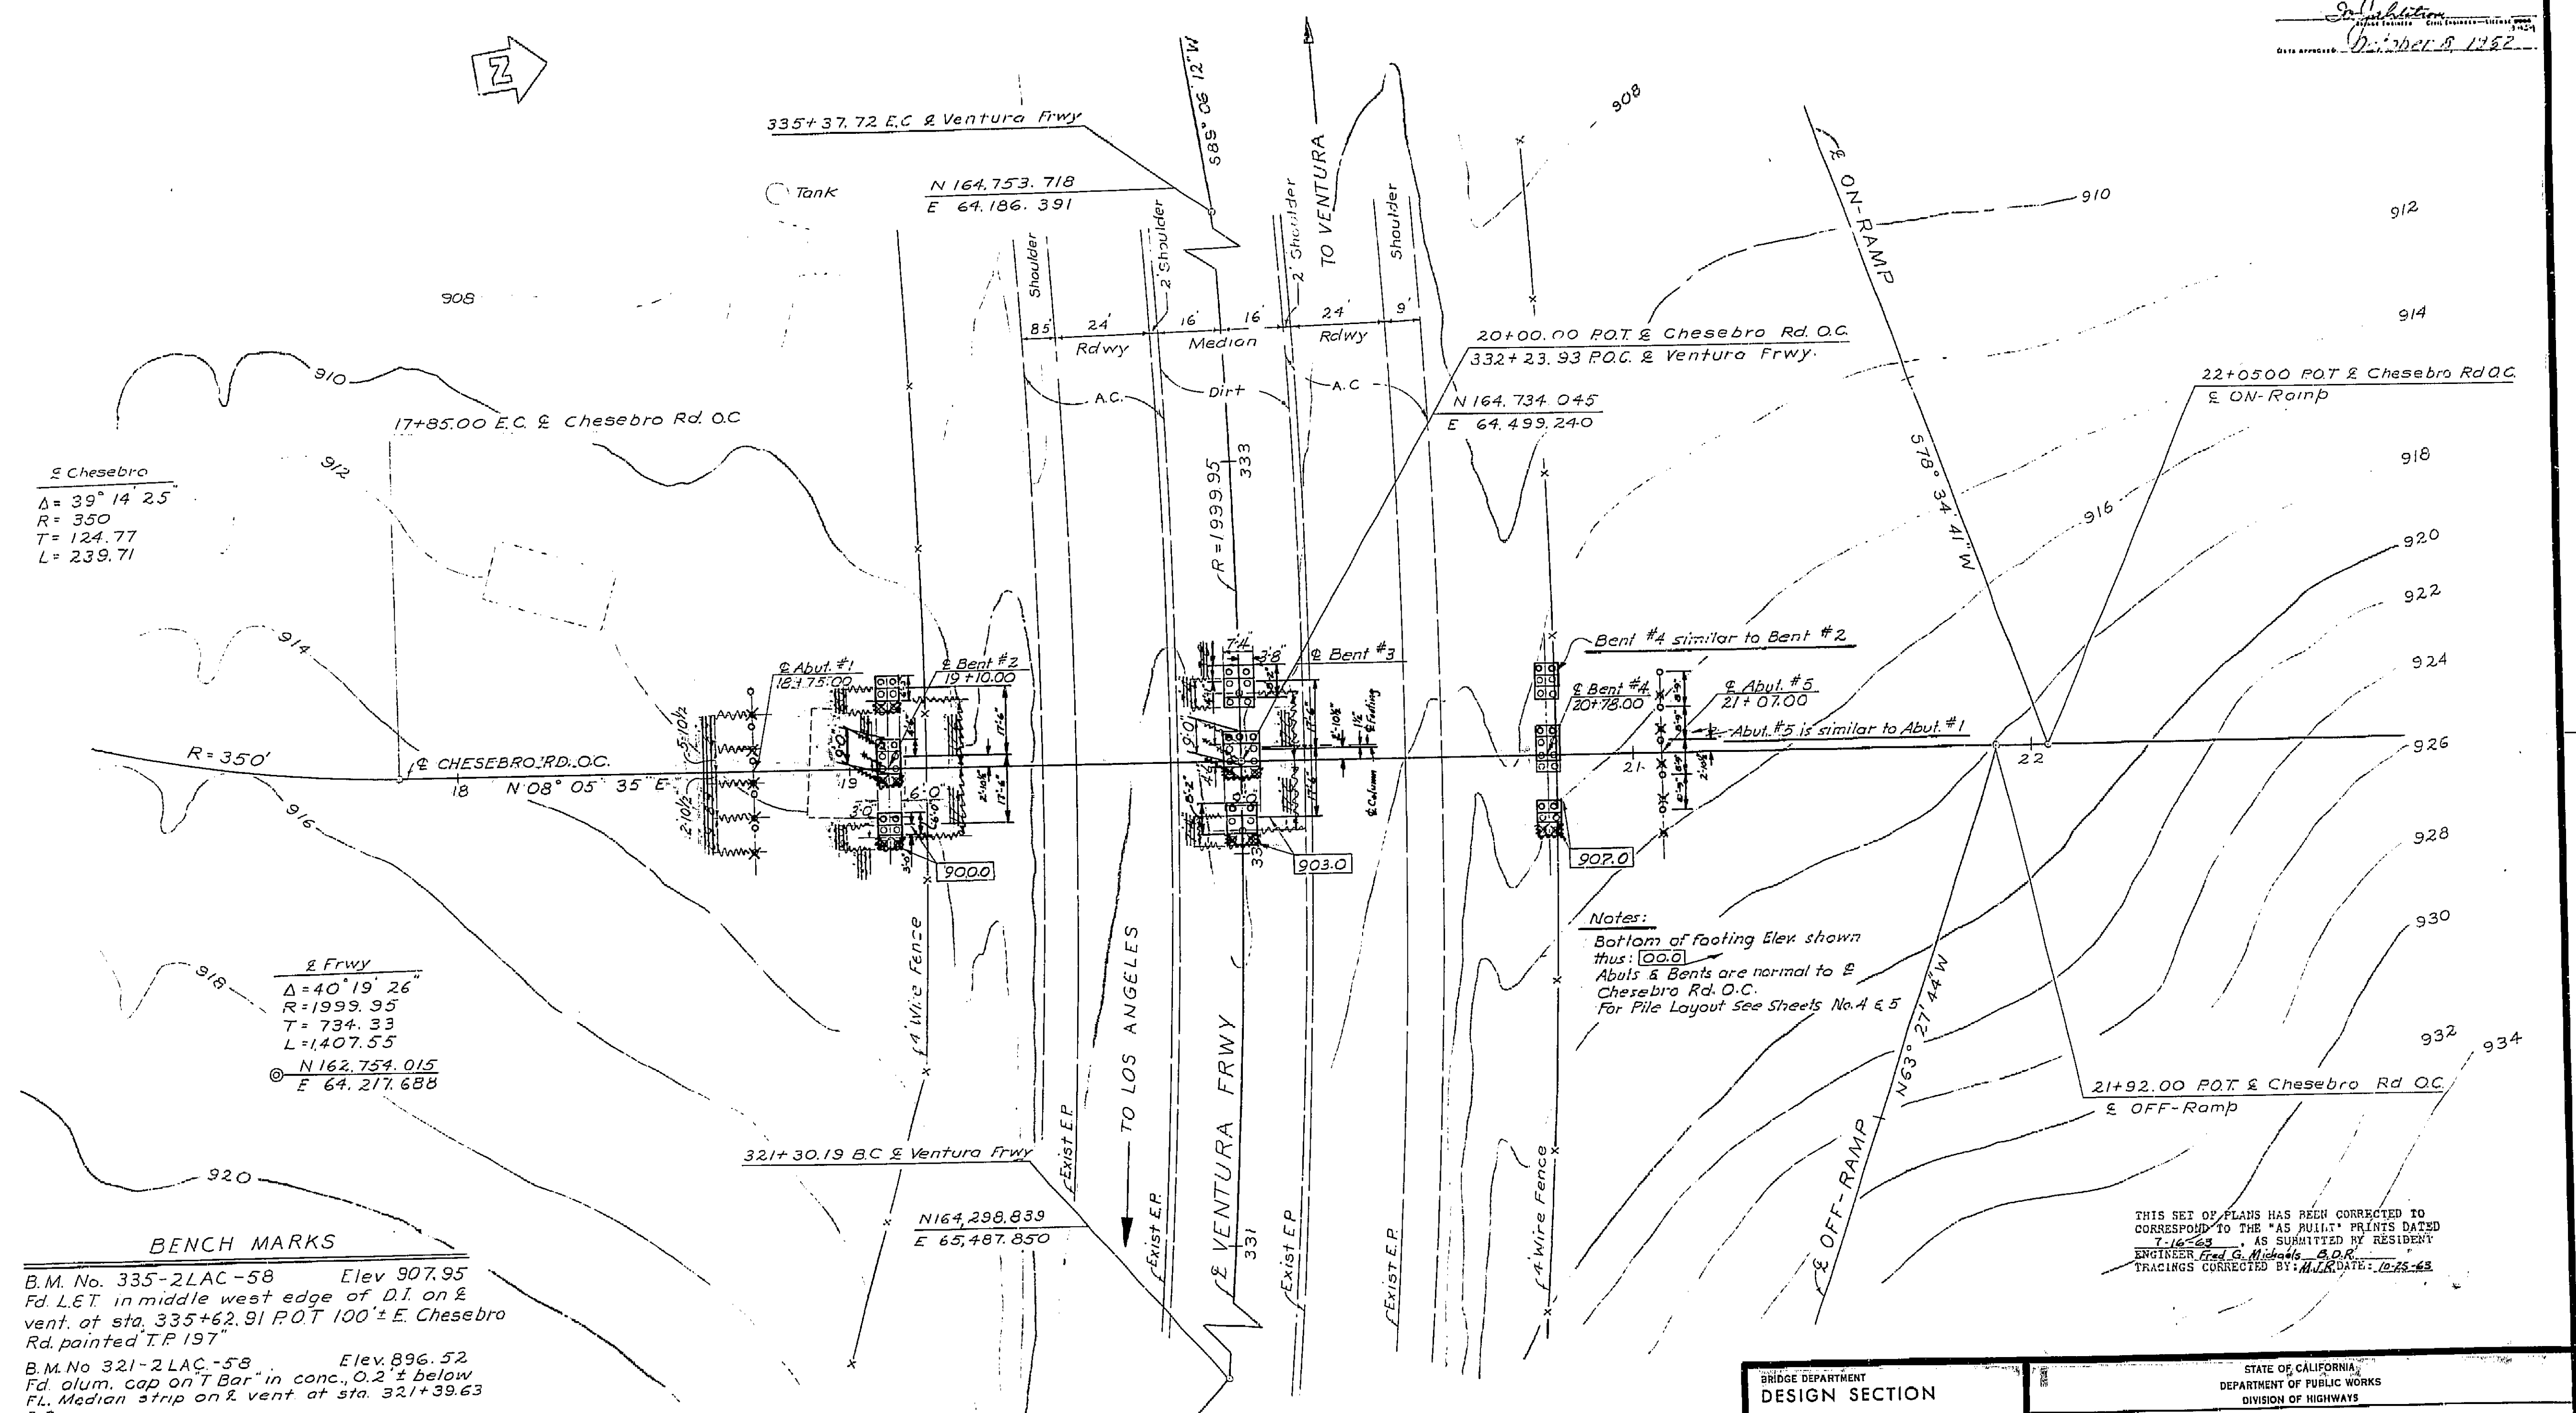

Chesebro  
 $\Delta = 39^\circ 14' 25"$   
 $R = 350$   
 $T = 124.77$   
 $L = 239.71$

Frwy  
 $\Delta = 40^\circ 19' 26"$   
 $R = 1999.95$   
 $T = 734.33$   
 $L = 1407.55$   
 $N 162.754.015$   
 $E 64.217.688$

**BENCH MARKS**  
 B.M. No. 335-2LAC-58 Elev. 907.95  
 Fd. L&T in middle west edge of D.I. on E vent. of sta. 335+62.91 P.O.T. 100' E. Chesebro Rd. painted T.P. 197  
 B.M. No. 321-2LAC-58 Elev. 896.52  
 Fd. alum. cap on T Bar in conc. 0.2' below P.L. Median strip on E vent. at sta. 321+39.63 B.C.

**AS BUILT PLANS**  
 Contract No. 63-7V13CS8  
 Date Completed \_\_\_\_\_  
 Document No. 7000 2373


CONTOURS CHECKED & VERIFIED IN FIELD  
 Date: June 1961  
 by: J.E.B.

**Notes:**  
 Bottom of footing Elev. shown thus: [00.0]  
 Abut. & Bents are normal to Chesebro Rd. O.C.  
 For Pile Layout see Sheets No. 4 & 5

THIS SET OF PLANS HAS BEEN CORRECTED TO CORRESPOND TO THE "AS BUILT" PRINTS DATED 7-16-58 AS SUBMITTED BY RESIDENT ENGINEER Fred G. Michaels, B.O.R. TRACINGS CORRECTED BY: M.L.R. DATE: 12-28-58

BRIDGE DEPARTMENT DESIGN SECTION		STATE OF CALIFORNIA DEPARTMENT OF PUBLIC WORKS DIVISION OF HIGHWAYS	
Section Supervisor: <i>R. E. Foster</i>	CHESEBRO ROAD OVERCROSSING		
DESIGN: <i>M. L. R.</i>	FOUNDATION PLAN		
DETAILS: <i>M. L. R.</i>	SCALE: 1"=20'	BRIDGE: 53-1676	FILE: 63
QUANTITIES: <i>M. L. R.</i>	DRAWING: C-531678-3		
Drawn By: H.R. Mariscal 6-26-61 Checked By: F.G.M.L. 8-5-61		PREL. DRAWING NO. P. 531678	

I HEREBY CERTIFY THAT THIS IS A TRUE AND ACCURATE COPY OF THE ABOVE DOCUMENT TAKEN UNDER MY DIRECTION AND CONTROL ON THIS DATE IN SACRAMENTO, CALIFORNIA PURSUANT TO AUTHORIZATION BY THE DIRECTOR OF PUBLIC WORKS.  
 DATE: 1-13-72 SIGNATURE: *[Signature]* TITLE: \_\_\_\_\_

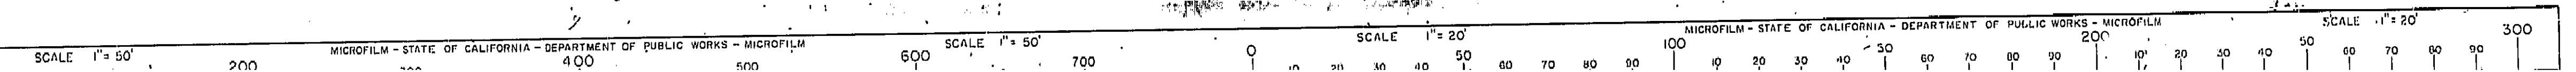

59


FED. ROAD DIST. NO.	STATE	PROJECT NO.	FISCAL YEAR	SHEET NO.	TOTAL SHEETS
7	CAL.			1	1

DIST.	COUNTY	PROJECT	SHEET NO.	TOTAL SHEETS
VII	LA	5	1	1

DATE APPROVED: 2/20/63  
 ENGINEER: Fred G. Michaels, B.S., C.E.  
 CIVIL ENGINEER - LICENSE NO. 1221

**BENCH MARK #335-2LAC-58**  
 Fd 1, 47 in middle West edge of D1 on E. Ven. at Sta 335+62.91  
 P.O.T. 100' ± E. Chesebro Rd. pointed "TR 197"

ELEV. 907.95

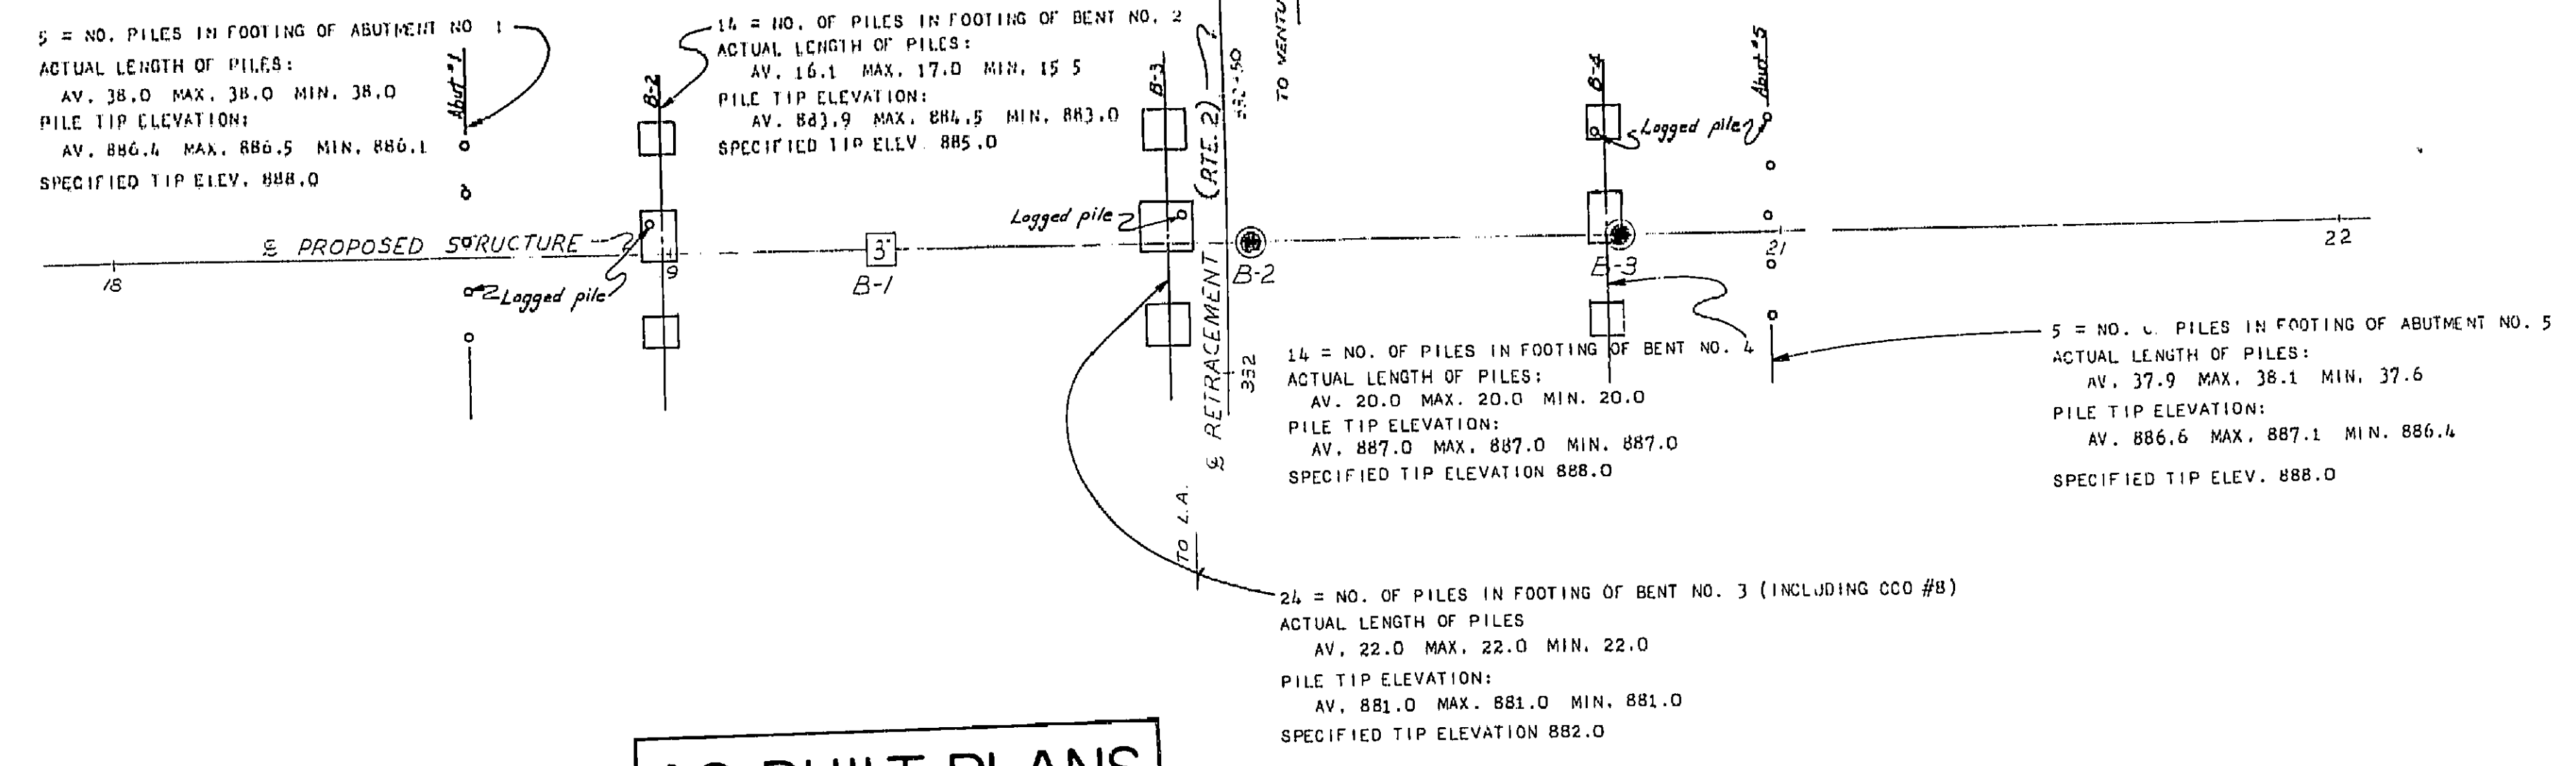

**AS BUILT PLANS**  
 Contract No. 63-7V13C58  
 Date Completed \_\_\_\_\_  
 Document No. 70002373

**PILE DATA**

TYPE OF PILE - C.I.D.H.  
 HAMMER DATA -  
 PILE DIAMETER: TIP 16" BUTT 15"  
 PILE DESIGN LOAD = 45 TONS  
 FOR THE STRUCTURE:  
 NUMBER OF PILES = 55 + 7 IN CCO #8  
 EST. LENGTH OF PILING = 1,210 L.F.  
 ACTUAL LENGTH OF PILING = 1,259.2 + 154.0 L.F. CCO #8

THIS SET OF PLANS HAS BEEN CORRECTED TO CORRESPOND TO THE "AS BUILT" PRINTS DATED 3-22-63 AS SUBMITTED BY RESIDENT ENGINEER Fred G. Michaels, B.S., C.E. TRACINGS CORRECTED BY: M.J.R. DATE: 10-29-63

NO GROUND WATER ENCOUNTERED DURING THIS INVESTIGATION BY BRIDGE DEPT. GEOLOGY SECTION DATE: June 1961

**NOTES**


The contractor's attention is directed to Section 2, Article (c) of the Standard Specifications and to the Special Provisions accompanying this set of plans. Classification of earth material as shown on this sheet is based upon field inspection and is not to be construed to imply mechanical analysis.

STATE OF CALIFORNIA  
 DEPARTMENT OF PUBLIC WORKS  
 DIVISION OF HIGHWAYS


**CHESEBRO RD. OVERCROSSING**

**LOG OF TEST BORINGS**

Scale: Horiz 1"=20', Vert 1"=10'  
 BRIDGE 53-1678 FILE DRAWING C-531678-15  
 P.E.L. DRAWING P-531678-15

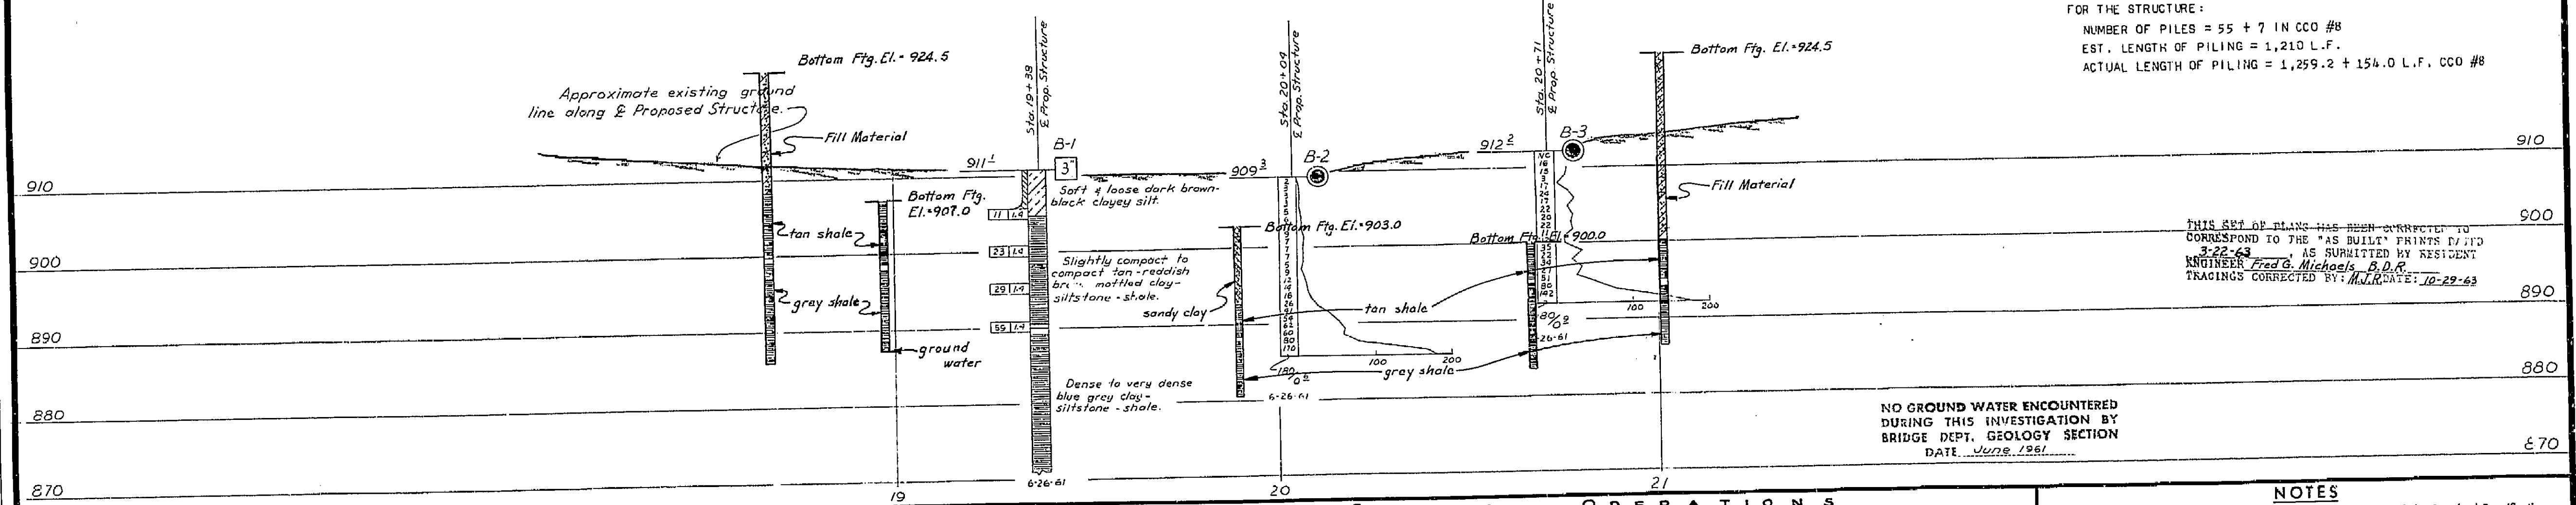

FIELD STUDY CHECKED BY: [Signature]  
 APPROVED BY: [Signature]

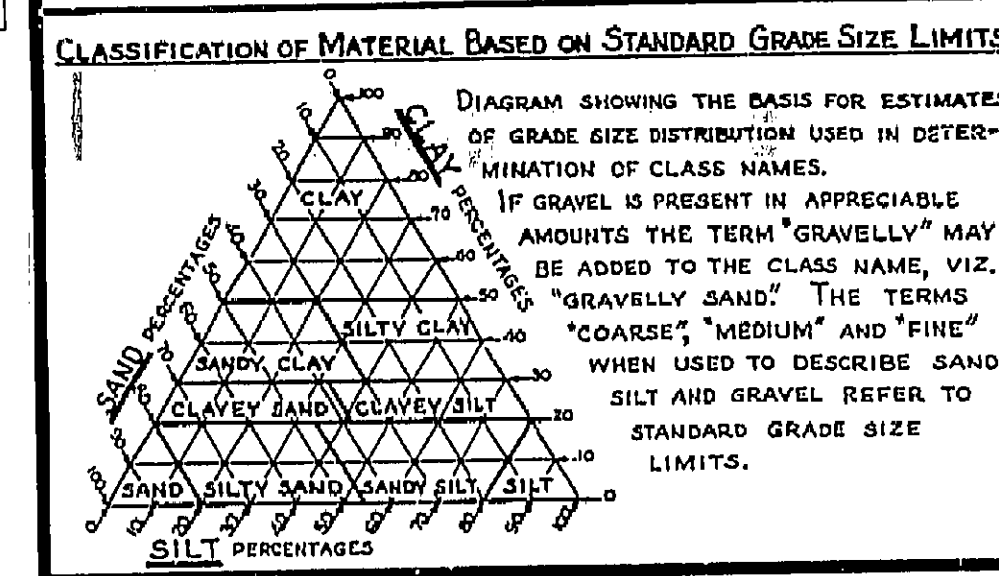

**LEGEND OF EARTH MATERIALS**


GRAVEL	SILTY CLAY OR CLAYEY SILT
SAND	PEAT AND/OR ORGANIC MATTER
SILT	FILL MATERIAL
CLAY	IGNEOUS ROCK
SANDY CLAY OR CLAYEY SAND	SEDIMENTARY ROCK
SANDY SILT OR SILTY SAND	METAMORPHIC ROCK

**LEGEND OF BORING OPERATIONS**

PENETROMETER	2 1/4" CONE PENETROMETER	SAMPLER BORING (DRY)	ROTARY BORING (WET)	AUGER BORING (DRY)	JET BORING	CORE BORING	TEST PIT
--------------	--------------------------	----------------------	---------------------	--------------------	------------	-------------	----------

1" SOIL TUBE  
 ROTARY BORING  
 PENETRATION BORING


I HEREBY CERTIFY THAT THIS IS A TRUE AND ACCURATE COPY OF THE ABOVE DOCUMENT TAKEN UNDER MY DIRECTION AND CONTROL ON THIS DATE IN SACRAMENTO, CALIFORNIA PURSUANT TO AUTHORIZATION BY THE DIRECTOR OF PUBLIC WORKS.  
 DATE \_\_\_\_\_ SIGNATURE \_\_\_\_\_ TITLE \_\_\_\_\_

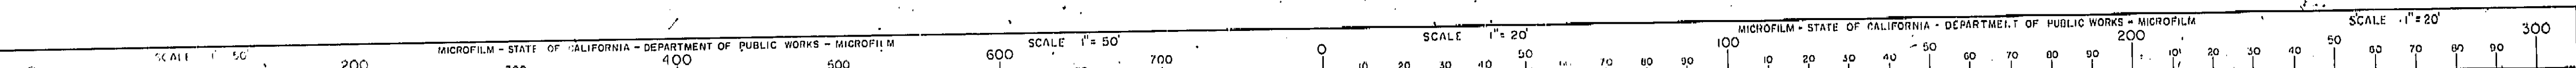

FED. ROAD DIST. NO.	STATE	P. A. PROJECT NO.	SHEET NO.	TOTAL SHEETS
7	CALIF.		60	21

DATE	COUNTY	ROUTE	SECTION	POST MILE	TOTAL MILES
11/14	LA	5	3	4	115


DATE APPROVED: *[Signature]*  
 11/14/62

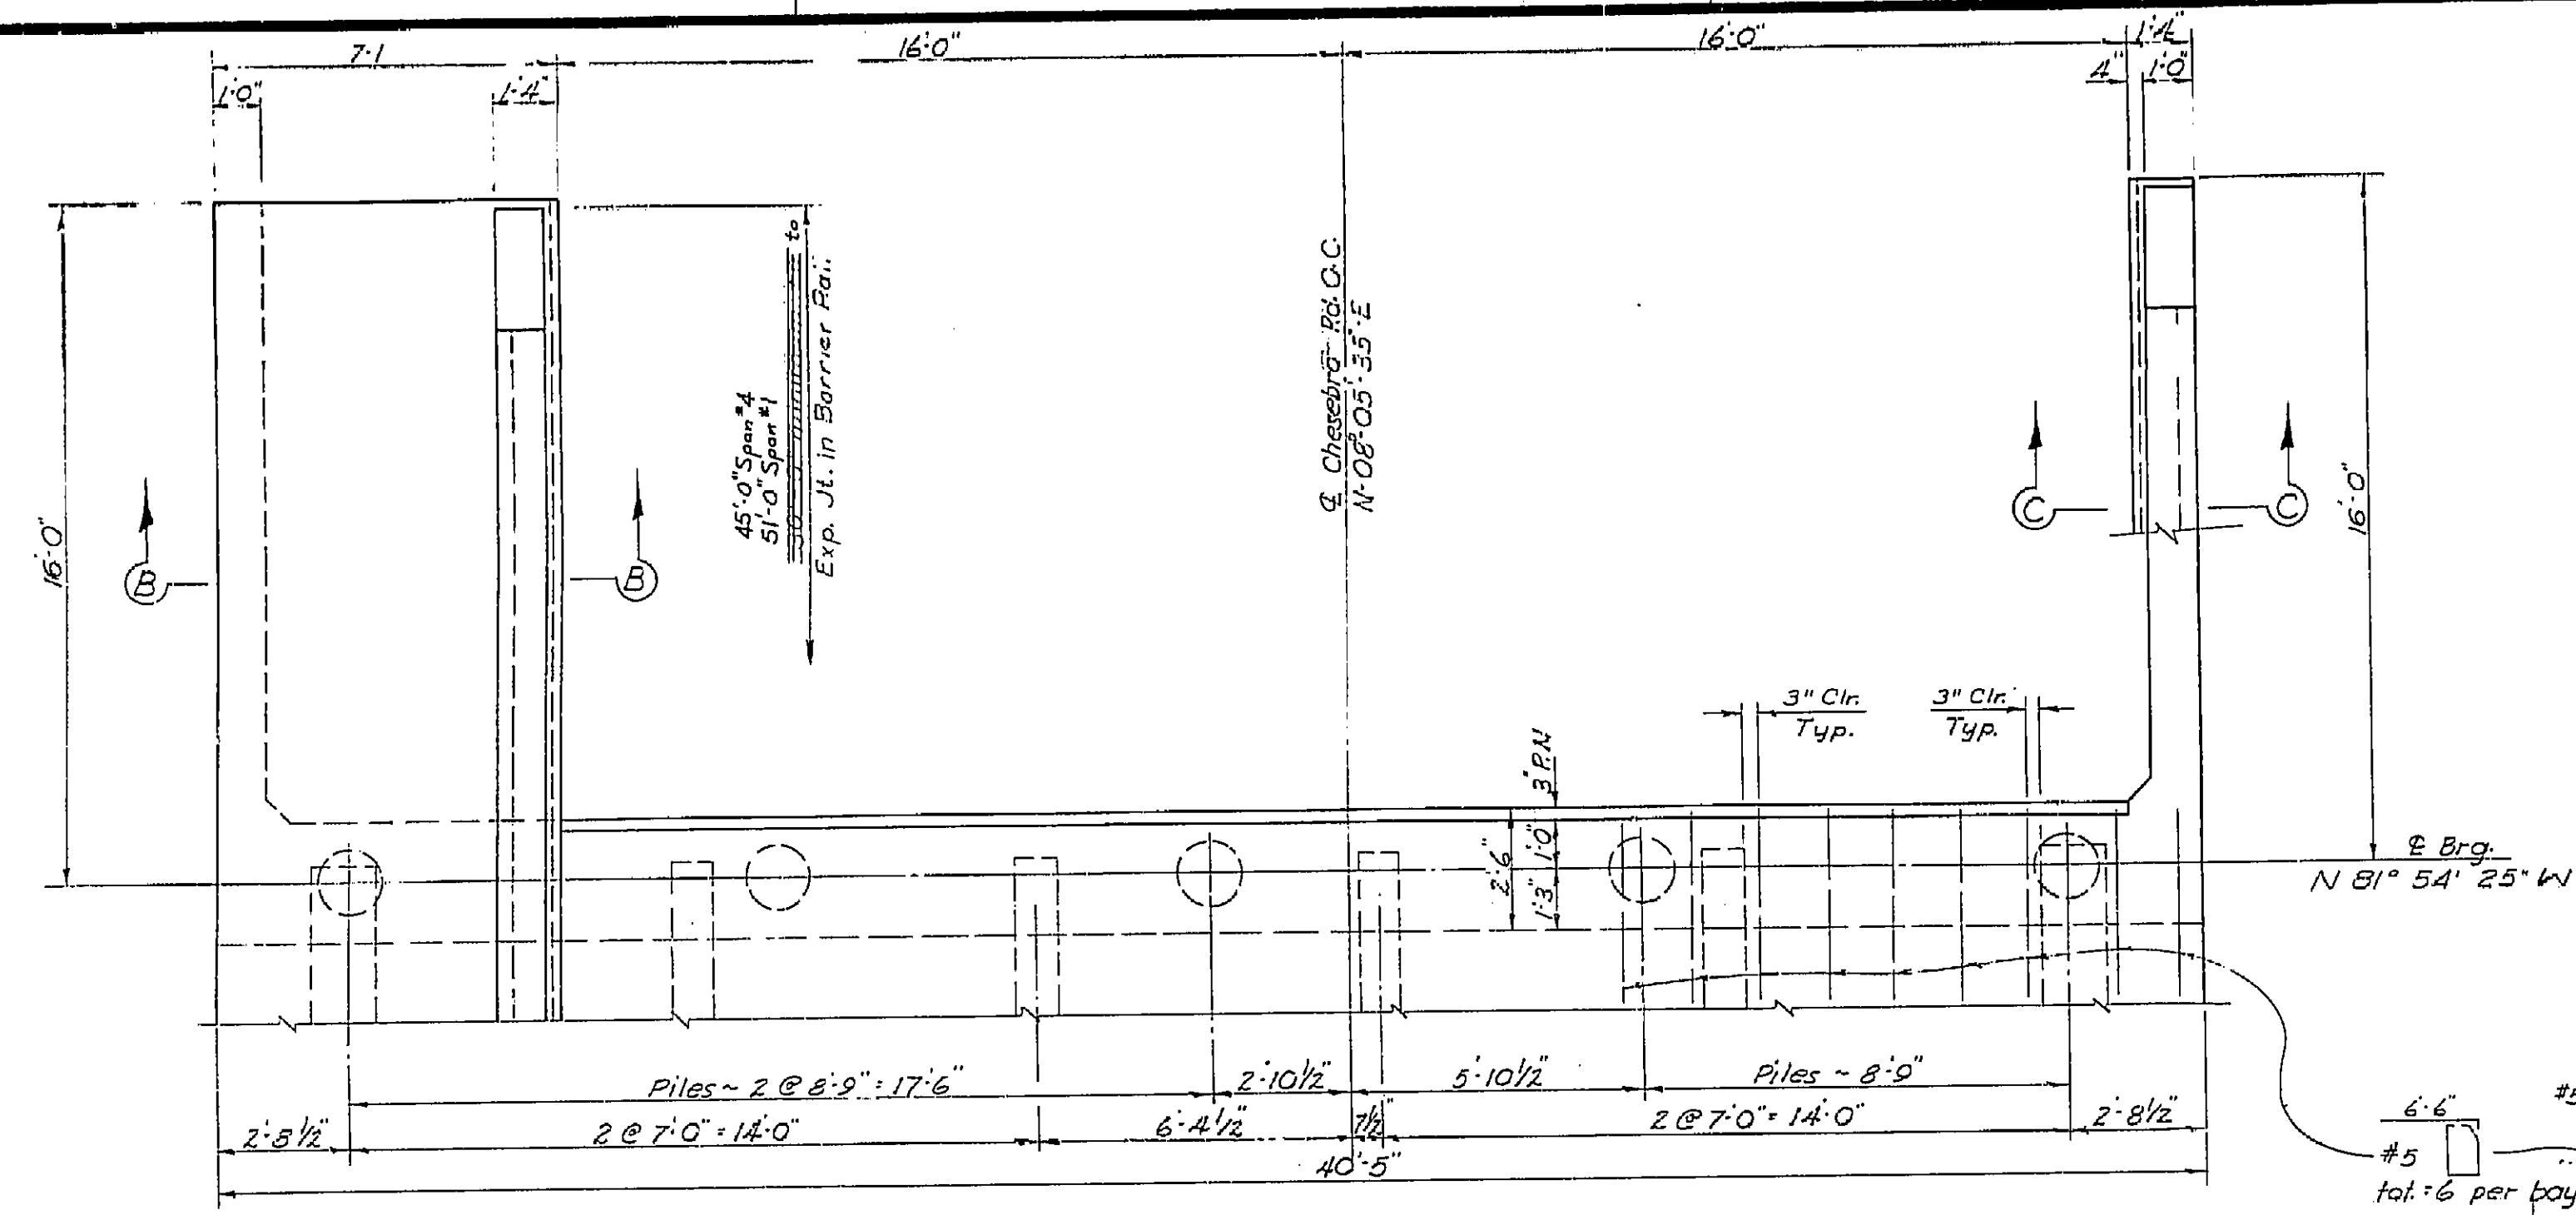

**PLAN**


Scale: 3/8" = 1'-0"

Note: Abutment #5 shown, Abutment #1 is similar

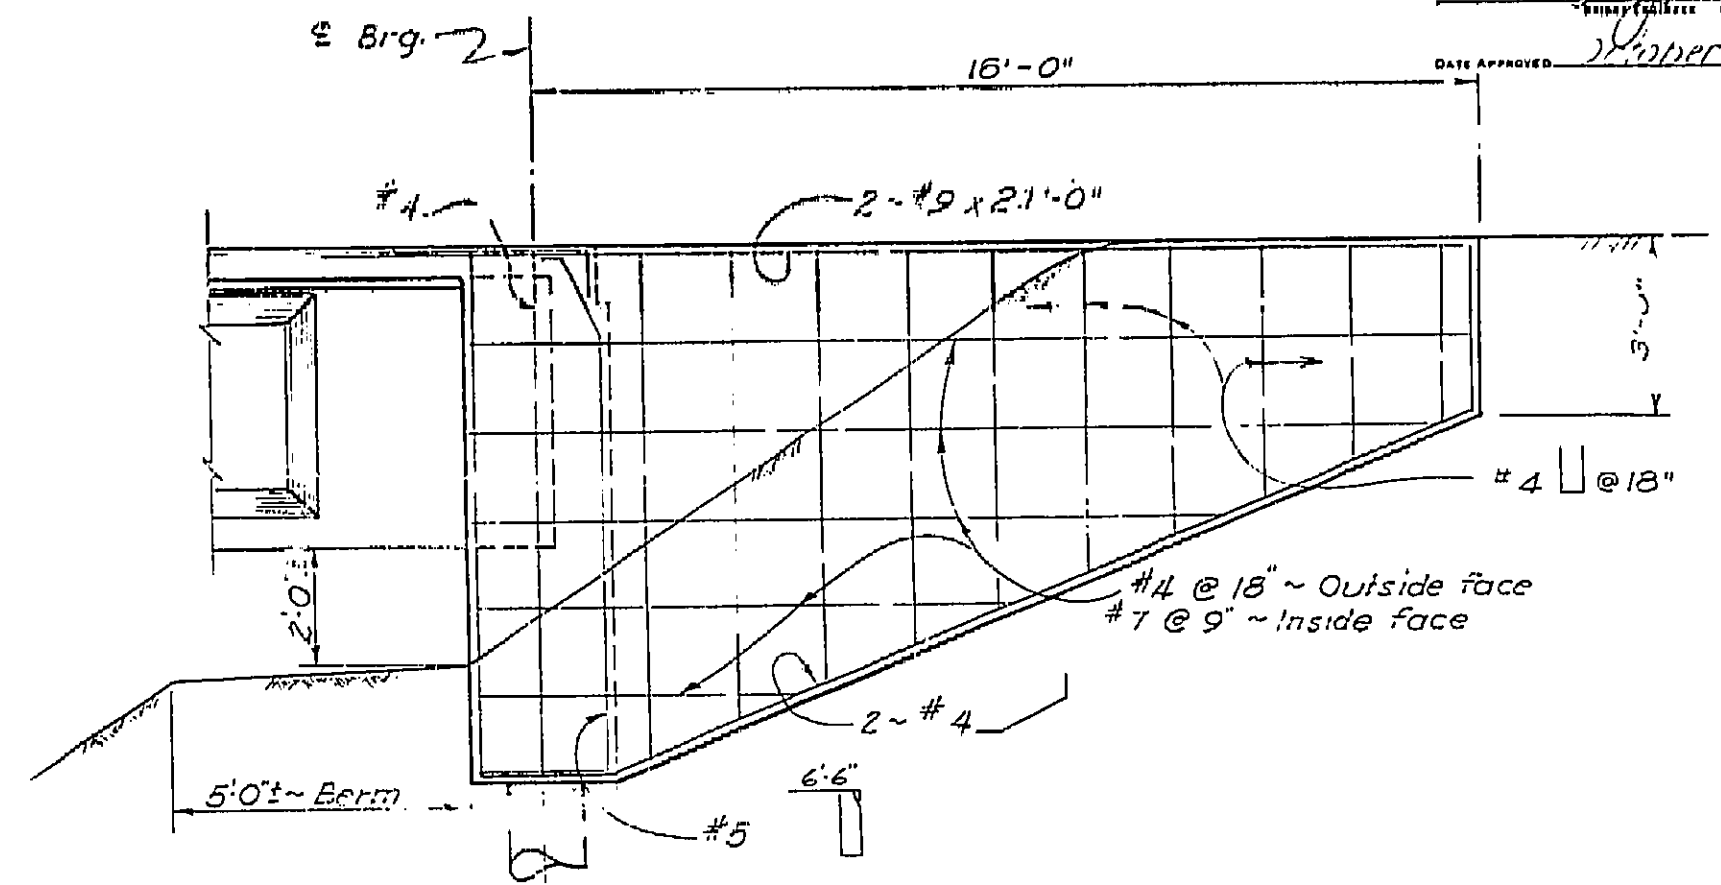


**WINGWALL ELEVATION**

Scale: 3/8" = 1'-0"

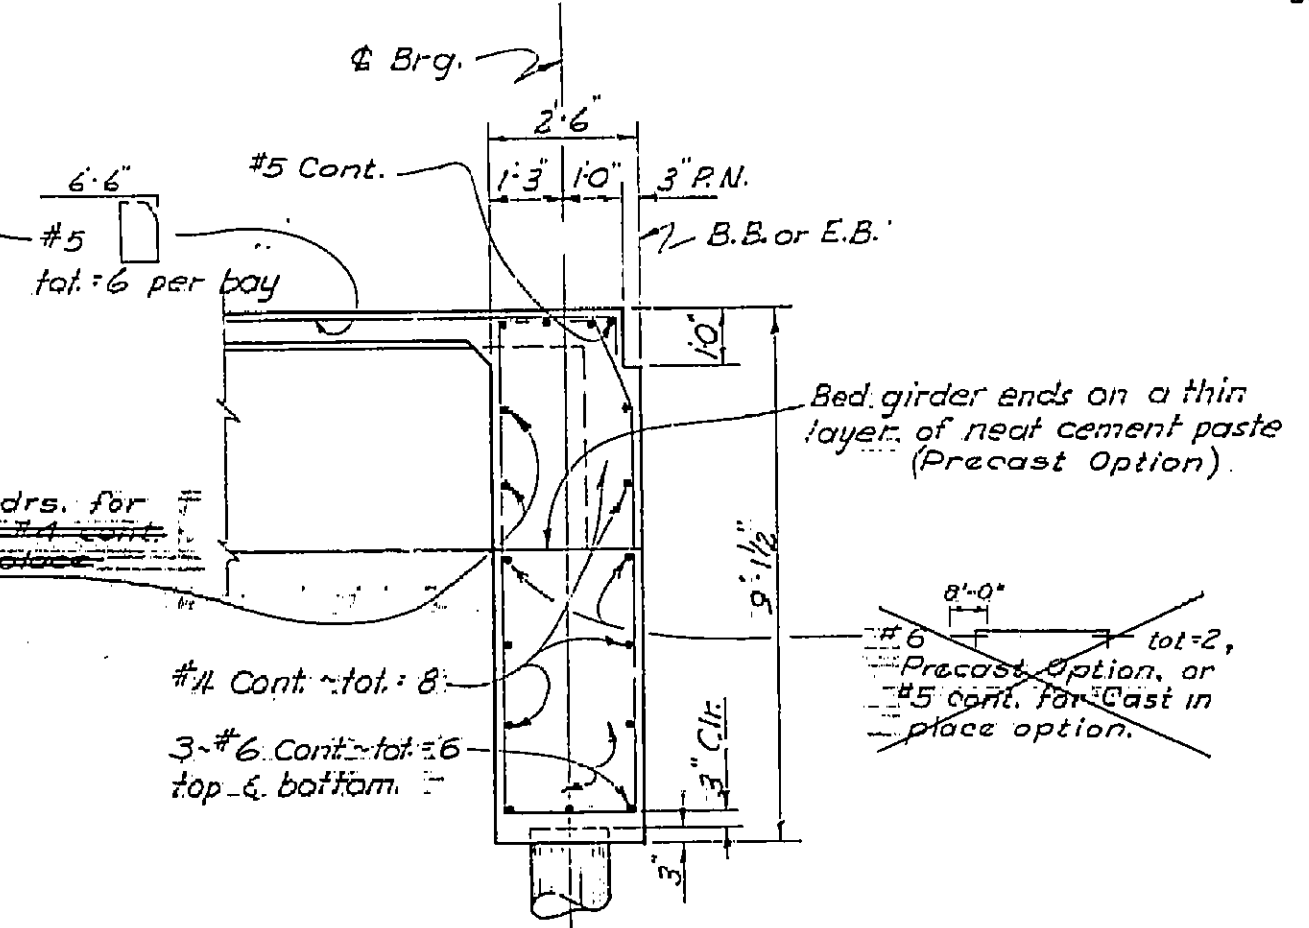


**SECTION A-A**

Scale: 3/8" = 1'-0"

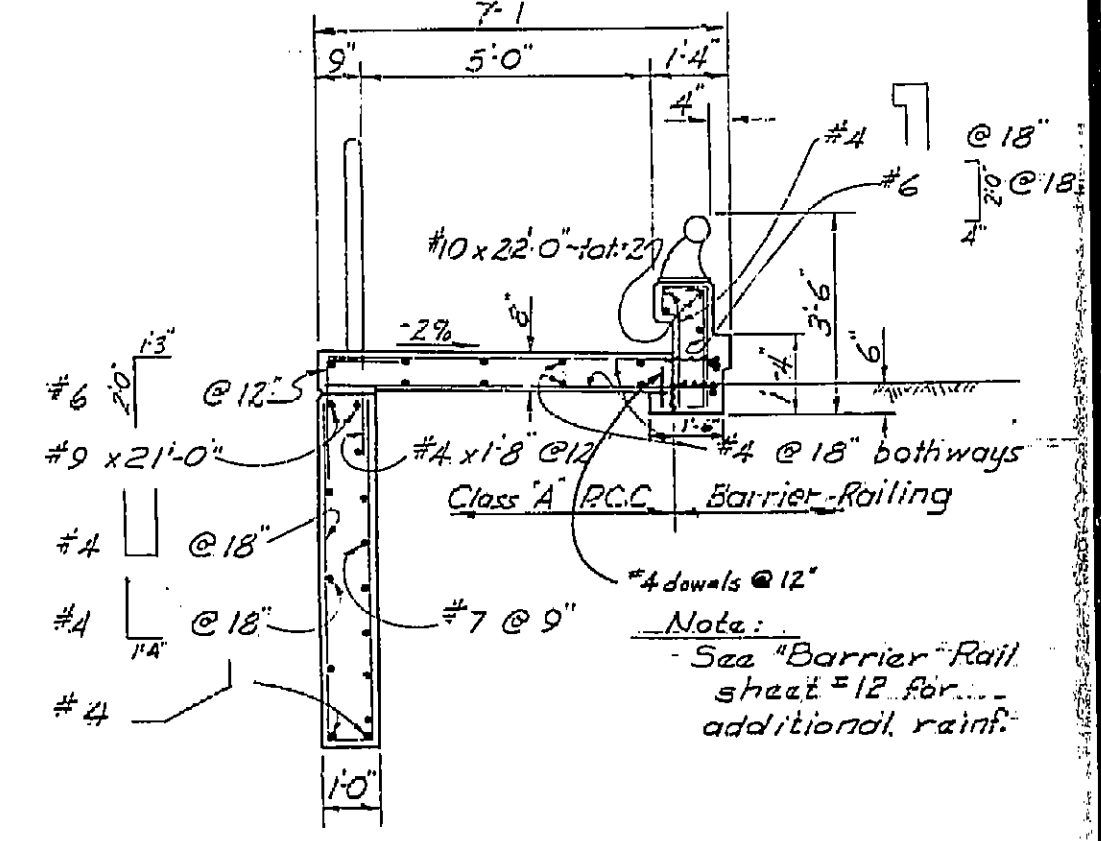

**SECTION B-B**

Scale: 3/8" = 1'-0"

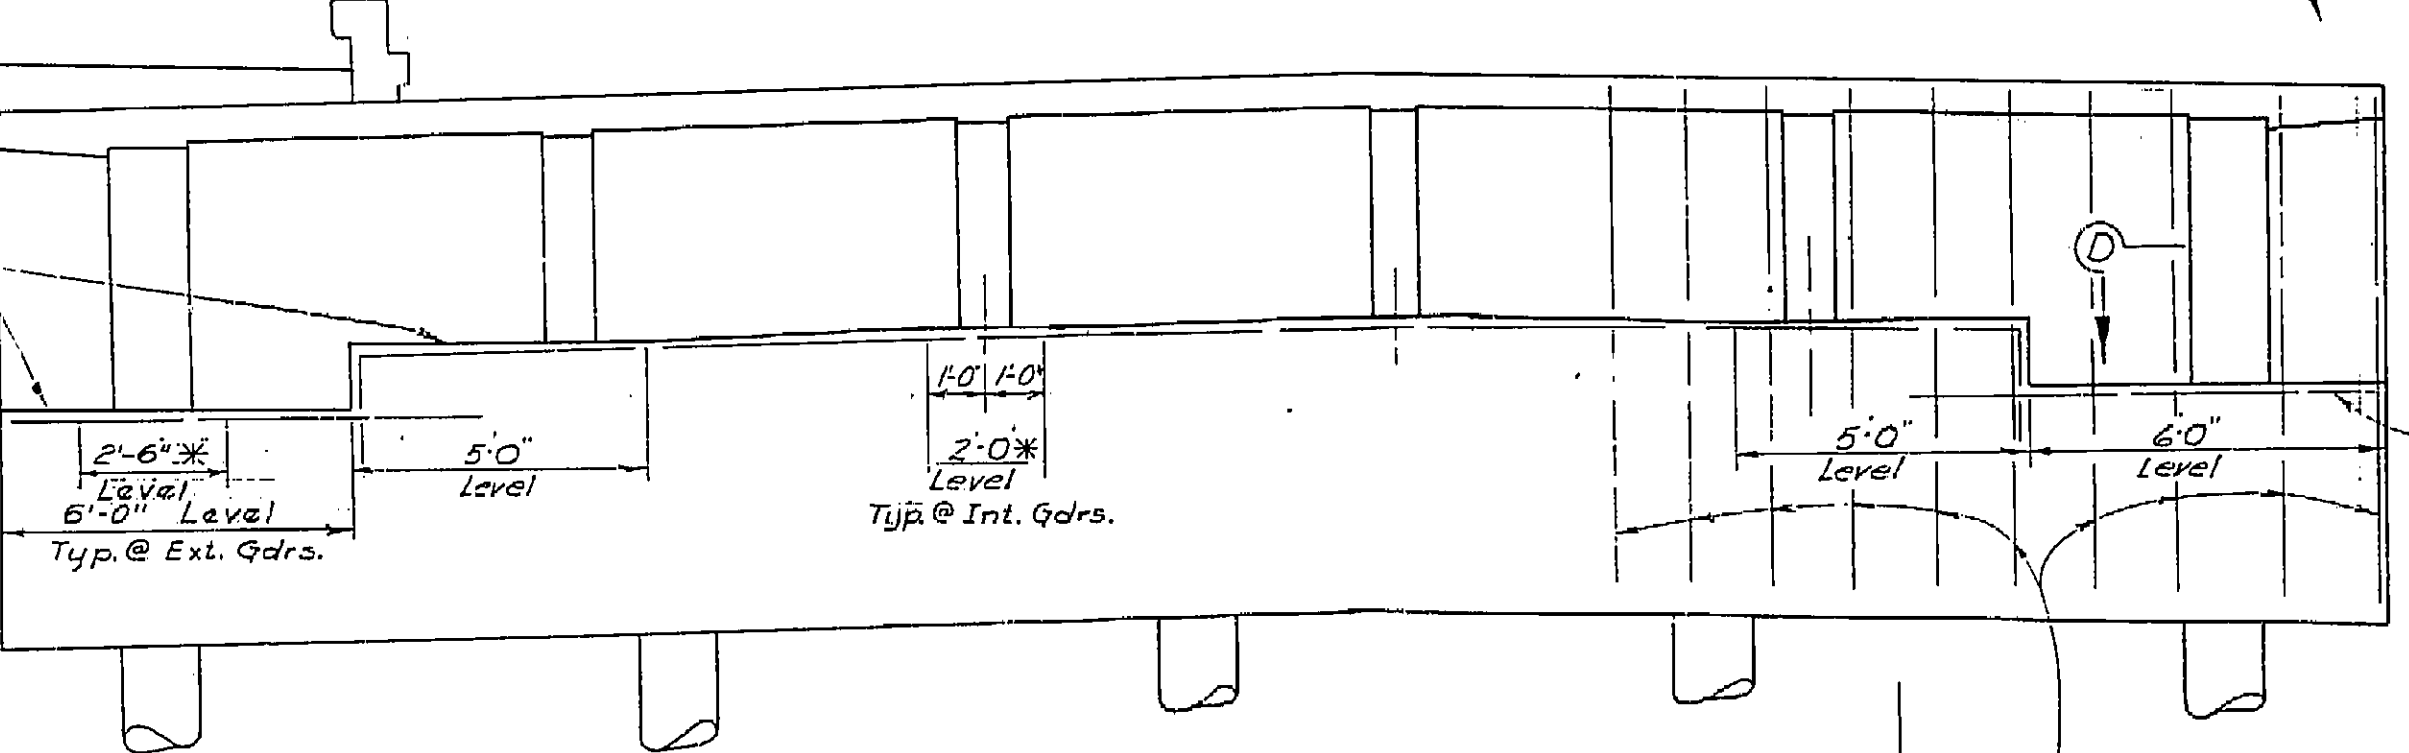


**ELEVATION**

Scale: 3/8" = 1'-0"

\* For Precast Option - Finish or grind to a smooth surface, level normal to E. Gdr., and at slope of gdr. length. to W. gdr. set girders in a thin layer of neat cement grout.

**AS BUILT PLANS**  
 Contract No. 63-7V13C58  
 Date Completed \_\_\_\_\_  
 Document No. 7000 2373

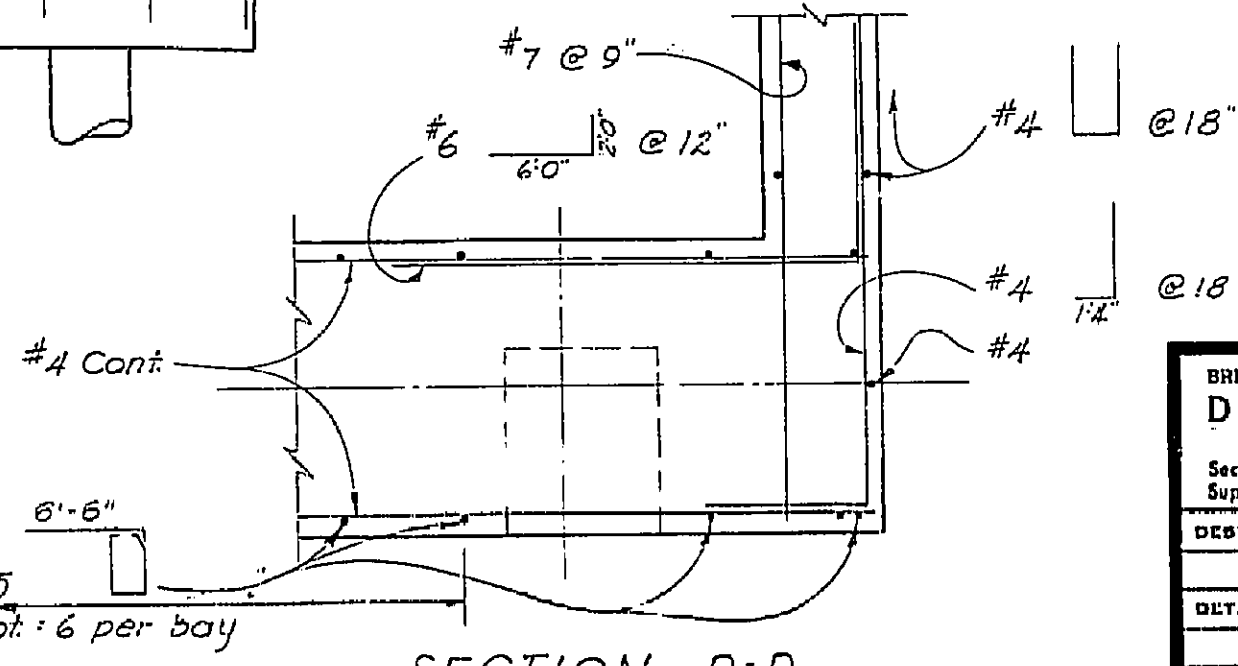

**SECTION C-C**

Scale: 3/8" = 1'-0"

**SECTION D-D**

Scale: 3/8" = 1'-0"


Note: For Barrier Railing Details not shown See Sheets #12 & 13


THIS SET OF PLANS HAS BEEN CORRECTED TO CORRESPOND TO THE "AS BUILT" PRINTS DATED 7-16-63 AS SUBMITTED BY RESIDENT ENGINEER Fred C. Michaels - B.O.B. REVISIONS CORRECTED BY: M.J.C. DATE: 10-25-63

BRIDGE DEPARTMENT	
<b>DESIGN SECTION 4</b>	
Section Supervisor	<i>[Signature]</i>
DESIGN	By E.L.S. R.S.B. 11/61
DETAILS	By <i>[Signature]</i> 11-61
QUANTITIES	By <i>[Signature]</i> 12/61


STATE OF CALIFORNIA DEPARTMENT OF PUBLIC WORKS DIVISION OF HIGHWAYS			
<b>CHESEBRO ROAD OVERCROSSING</b>			
<b>ABUTMENT DETAILS</b>			
SCALE AS SHOWN	BRIDGE 53-1678	FILE	DRAWING C-531678-4
PRELIMINARY DRAWING NO. P-531678-3		REVISION DATES	

I HEREBY CERTIFY THAT THIS IS A TRUE AND ACCURATE COPY OF THE ABOVE DOCUMENT TAKEN UNDER MY DIRECTION AND CONTROL ON THIS DATE IN SACRAMENTO, CALIFORNIA PURSUANT TO AUTHORIZATION BY THE DIRECTOR OF PUBLIC WORKS.  
 DATE 1-11-72 SIGNATURE *[Signature]* TITLE \_\_\_\_\_

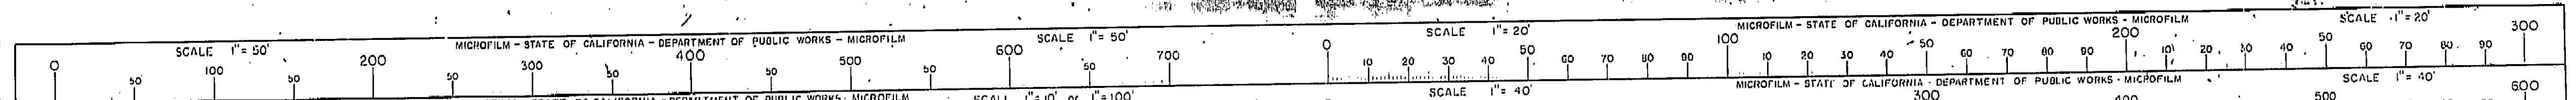


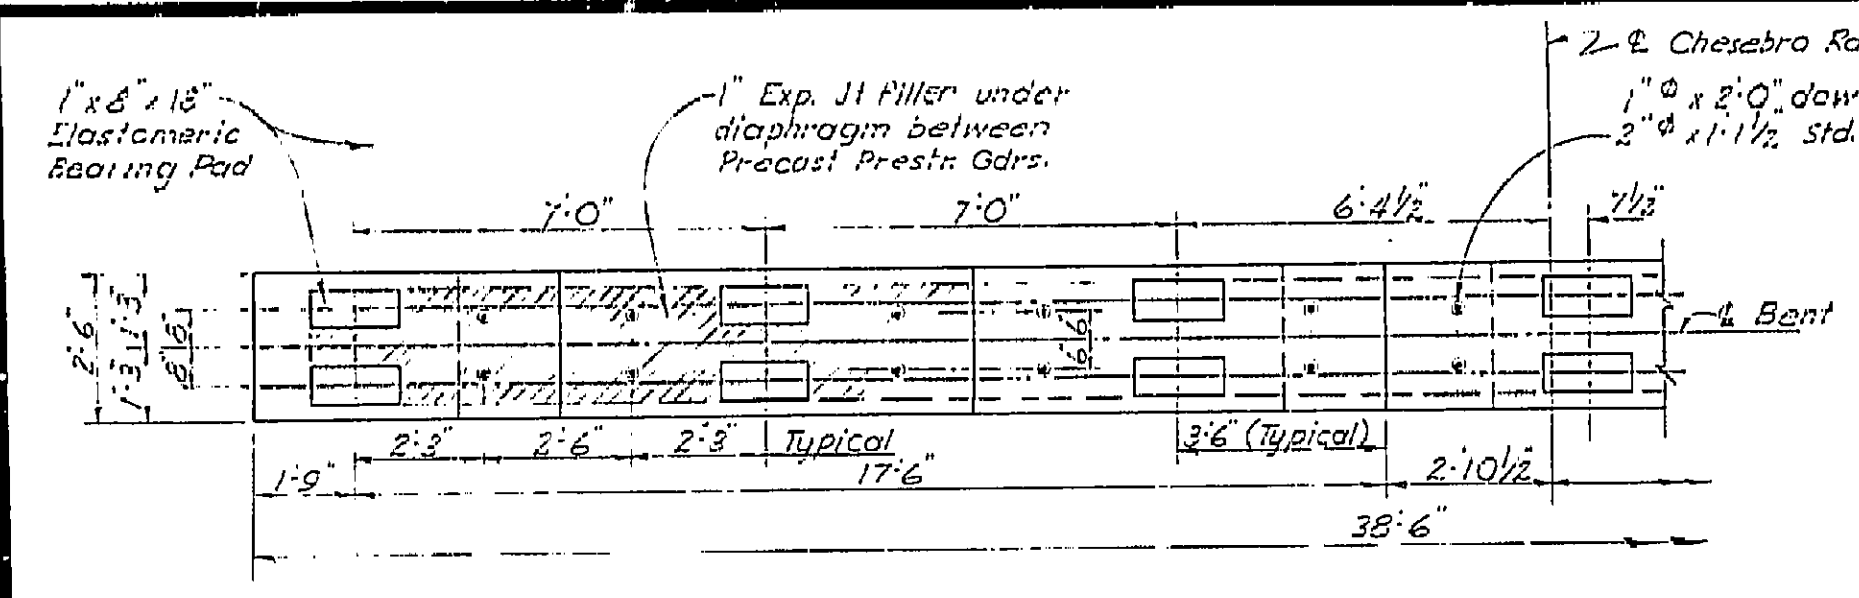


**HALF PLAN**  
BENT NO. 3  
Scale: 3/8" = 1'-0"

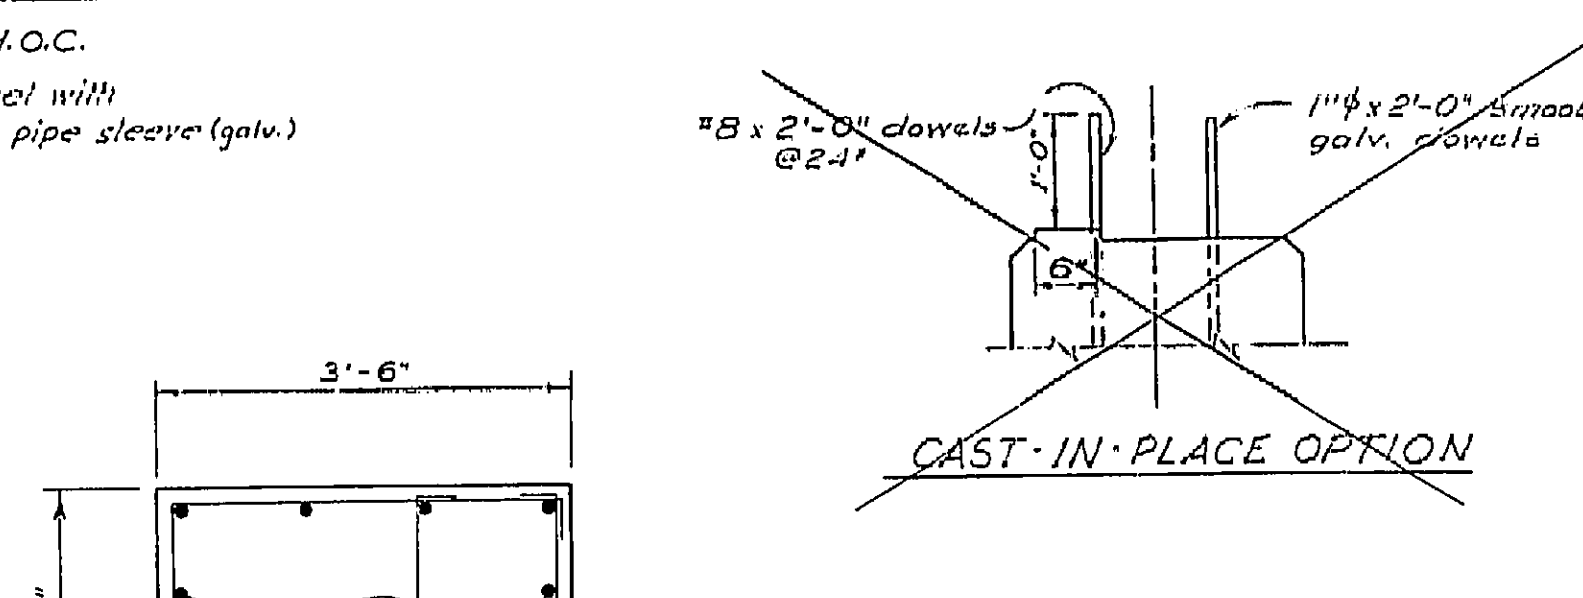


**CAST-IN-PLACE OPTION**

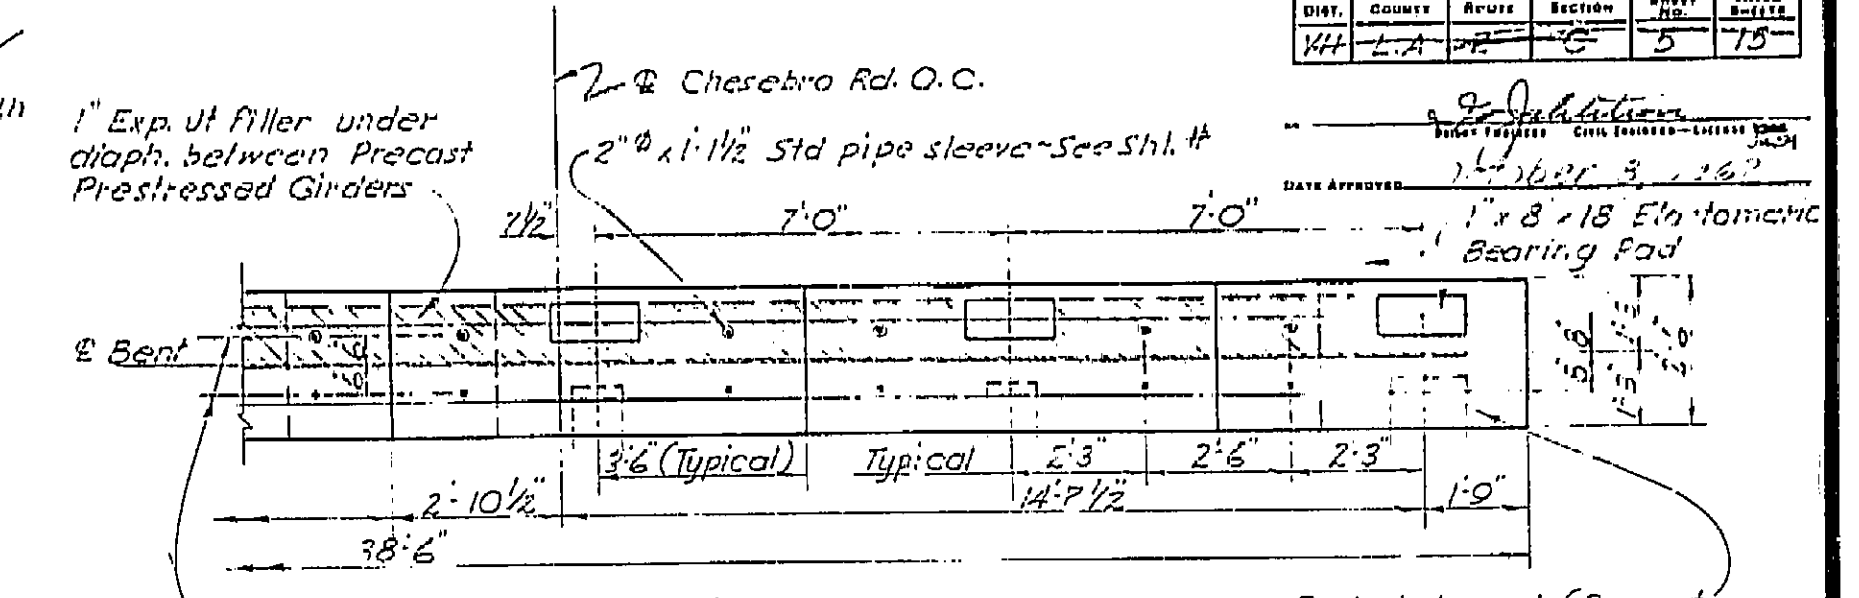

**HALF PLAN**  
BENT NO. 2  
Scale: 3/8" = 1'-0"

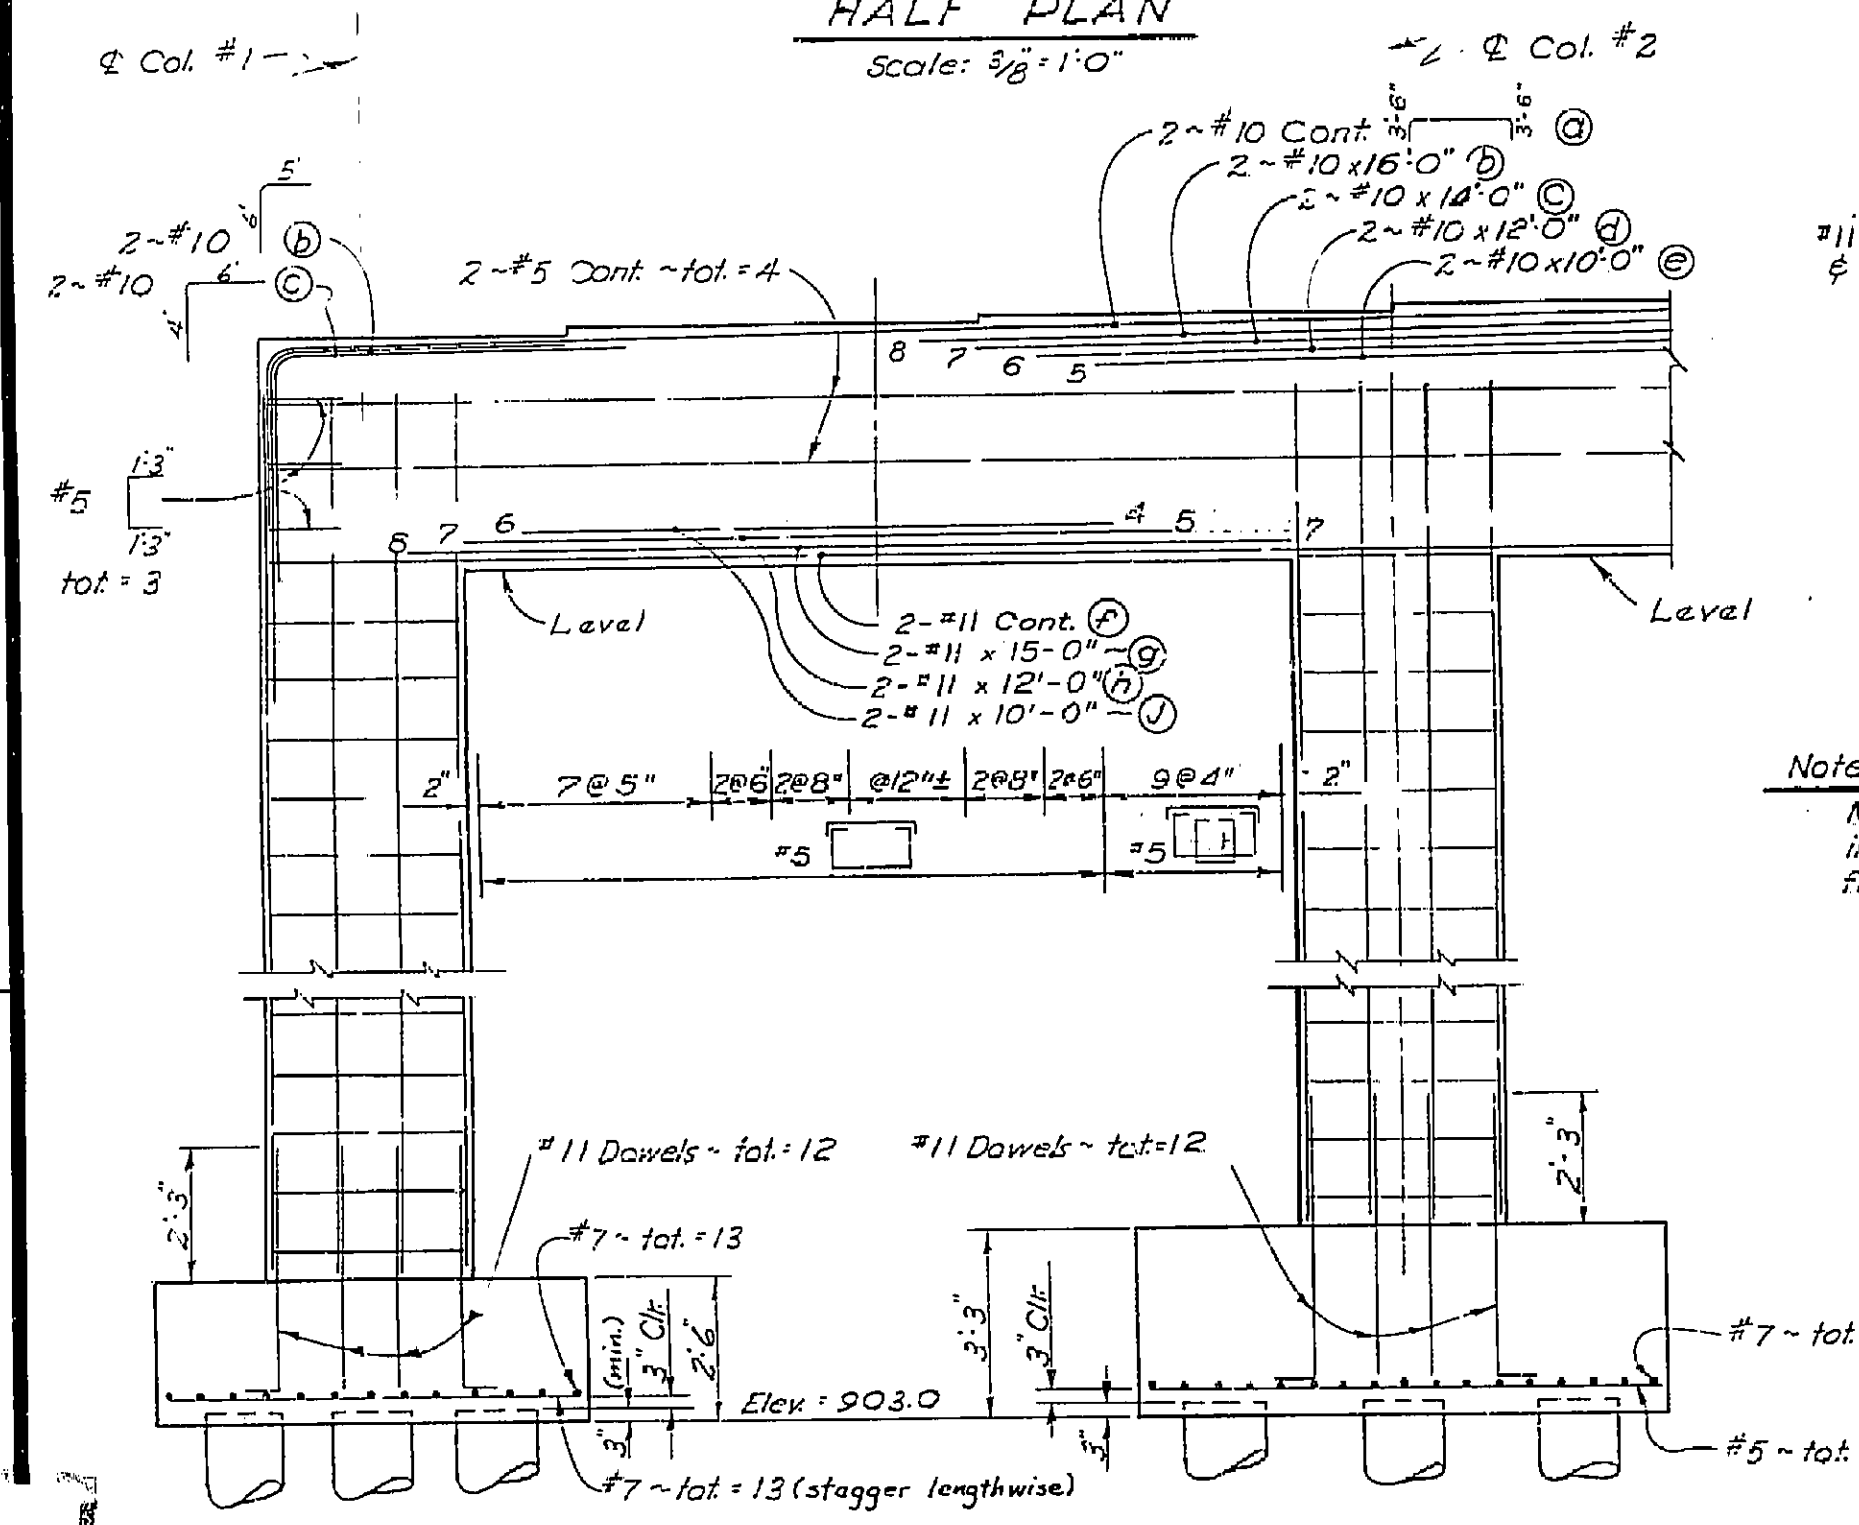


**HALF ELEVATION**  
BENT NO. 3  
Scale: 3/8" = 1'-0"

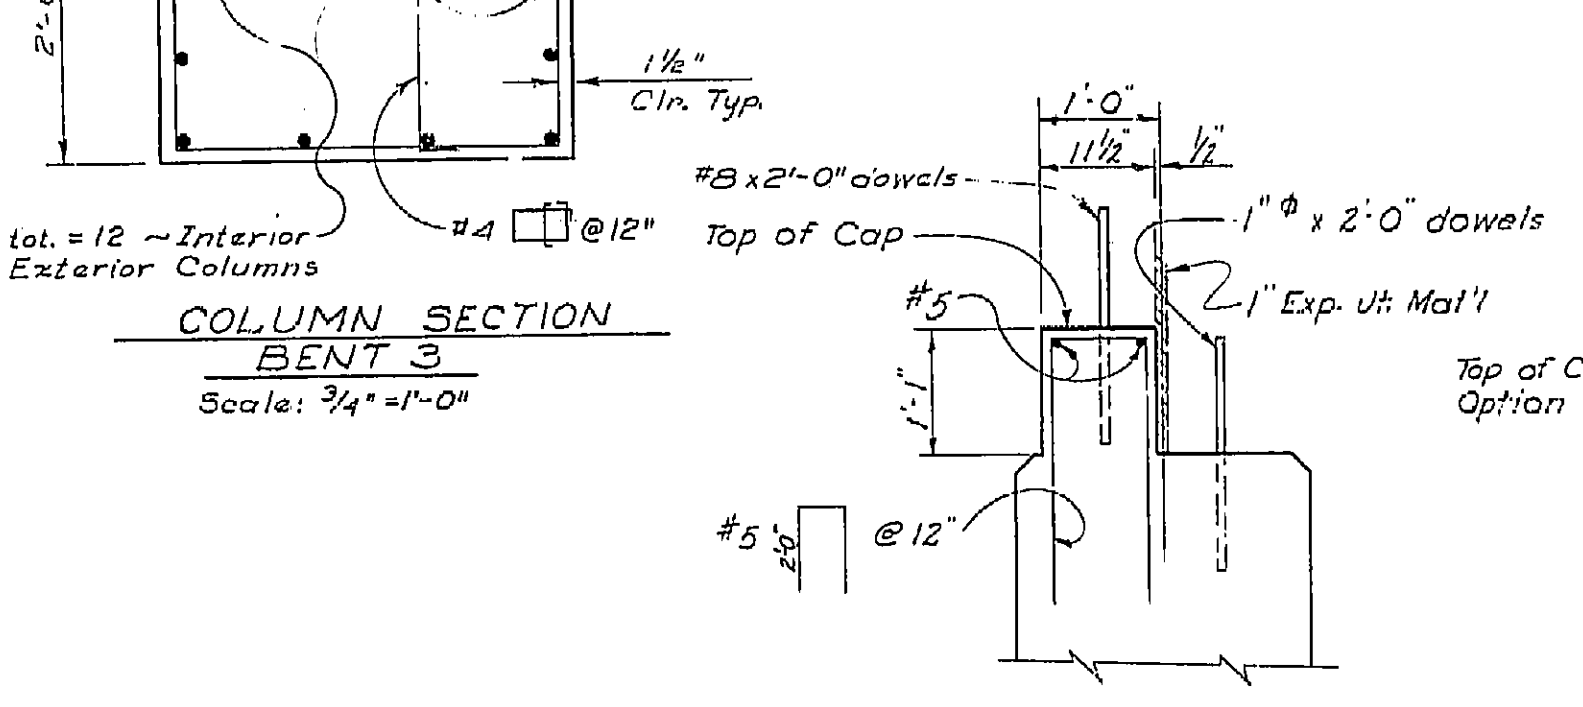

**COLUMN SECTION**  
BENT NO. 3  
Scale: 3/4" = 1'-0"


**CAST-IN-PLACE OPTION**

**CAP SECTION**  
BENTS NO. 2 & 4  
Scale: 3/4" = 1'-0"

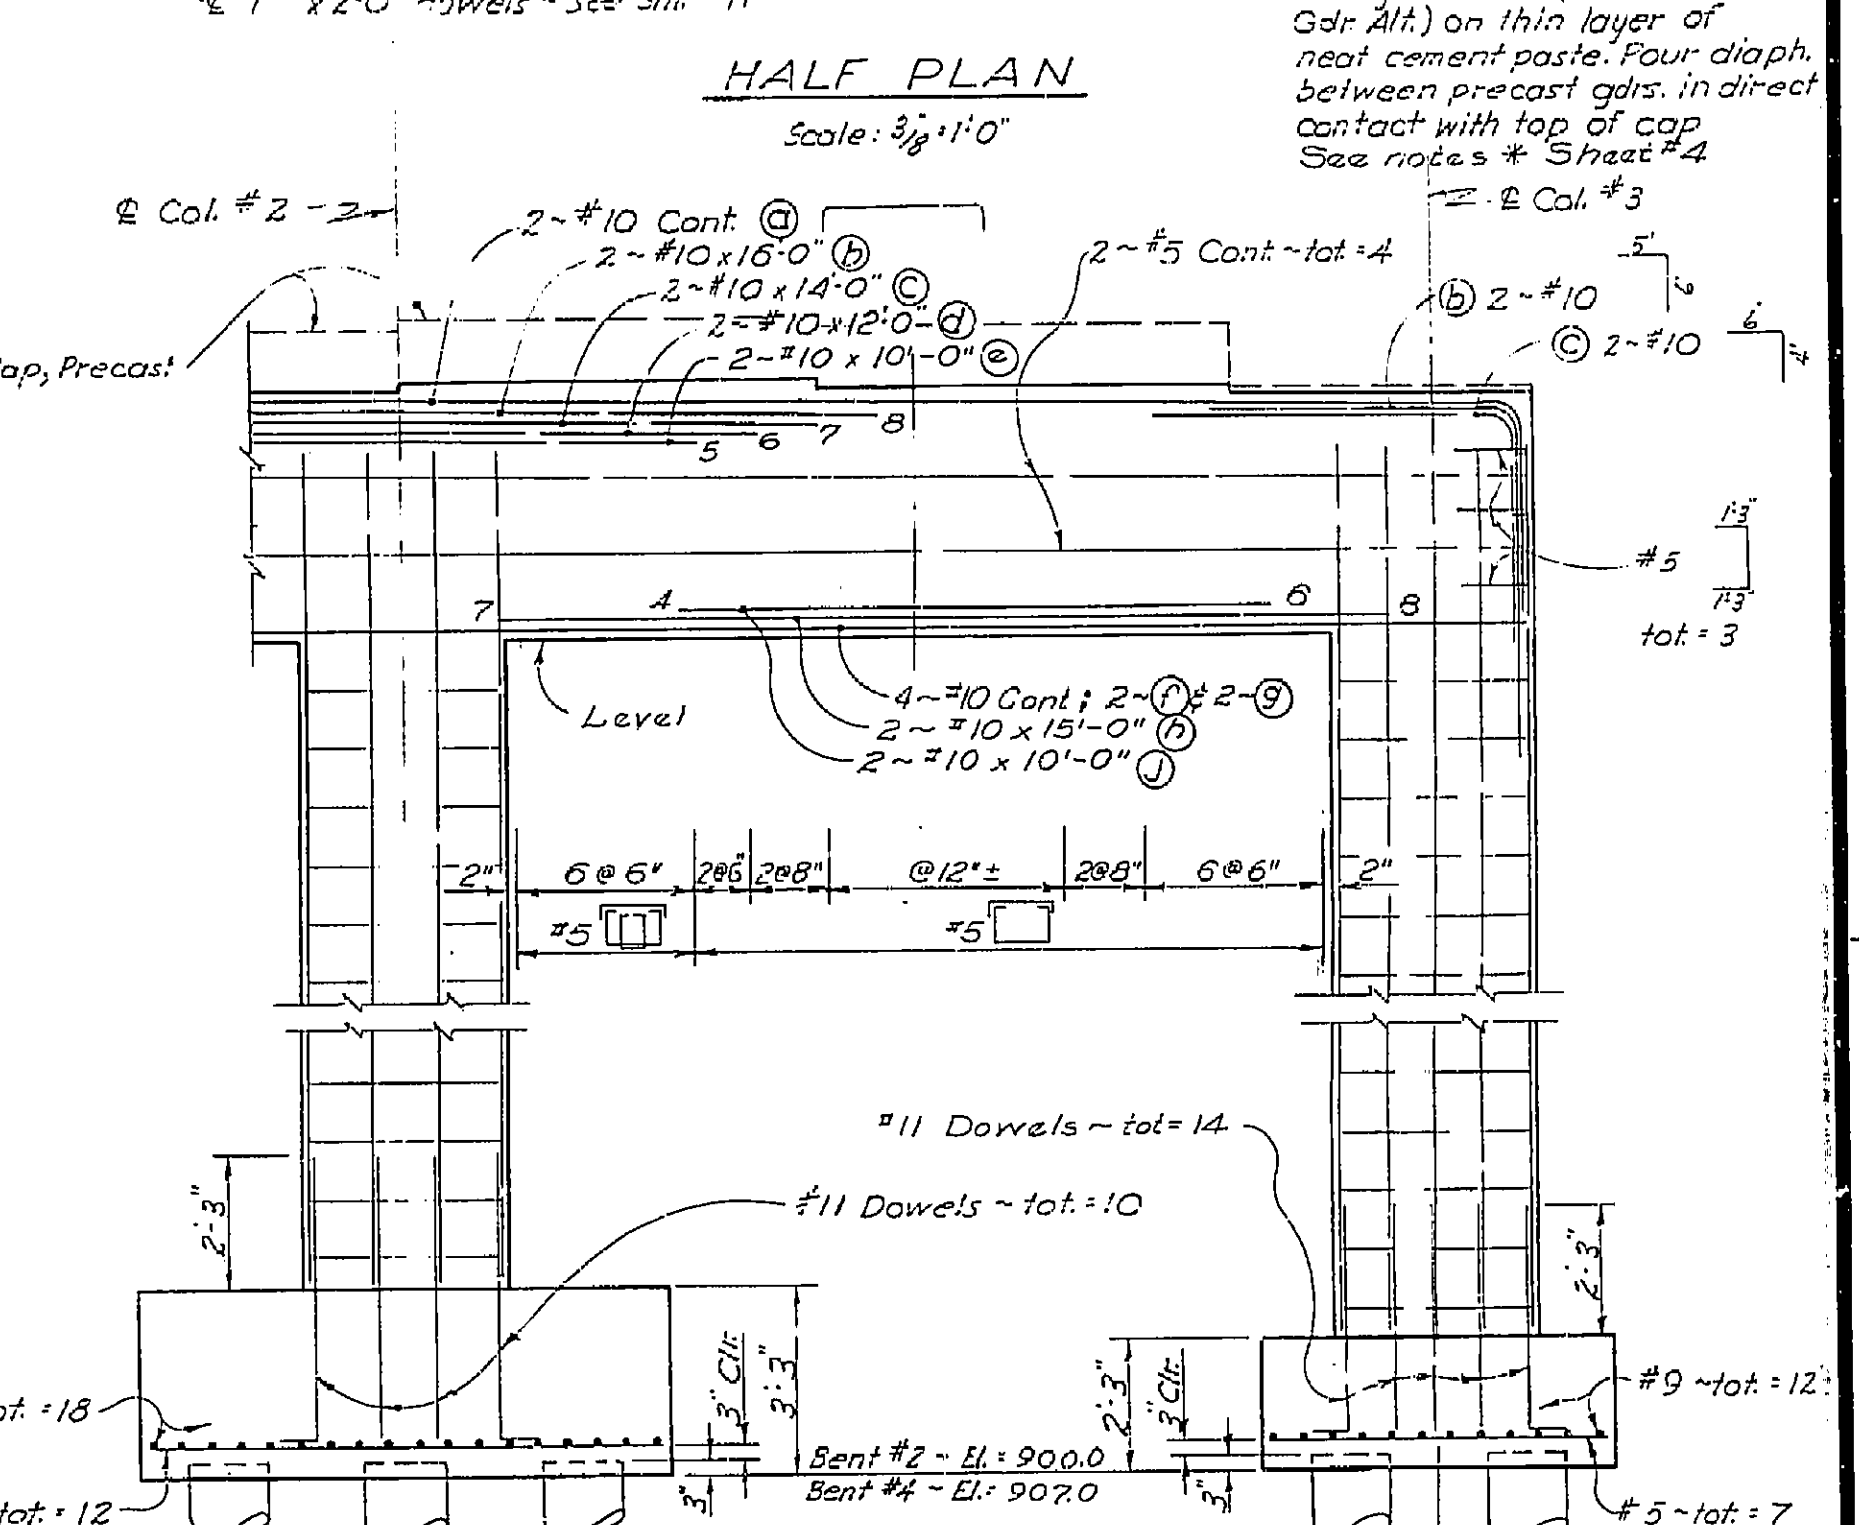


**HALF ELEVATION**  
BENTS NO. 2 & 4  
Scale: 3/8" = 1'-0"


Note: Number at ends of bars indicate distance in feet from & Col. for top reinf. and from & between Col. for bottom reinf.

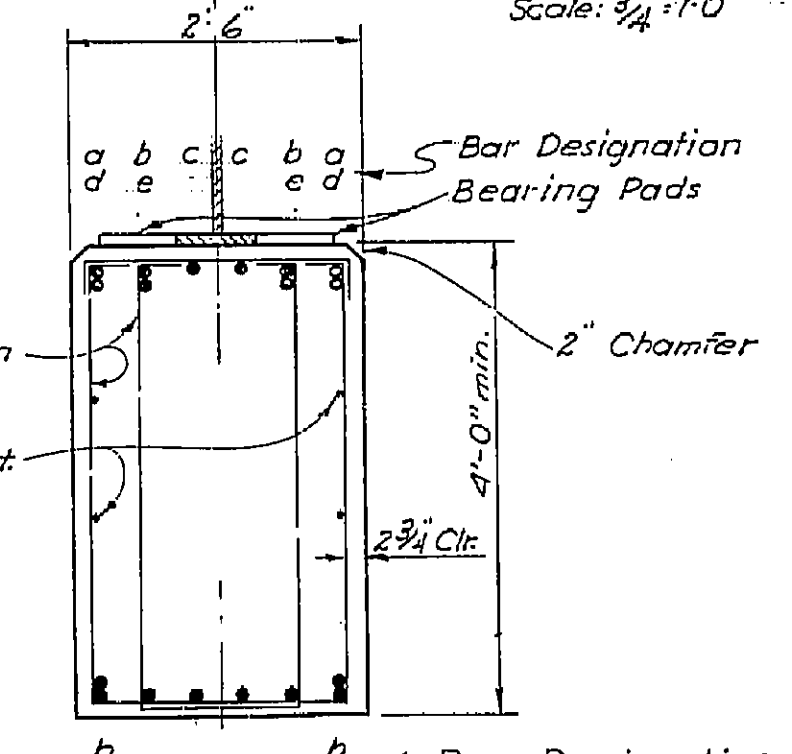


**CAP SECTION**  
BENT NO. 3  
Scale: 3/4" = 1'-0"

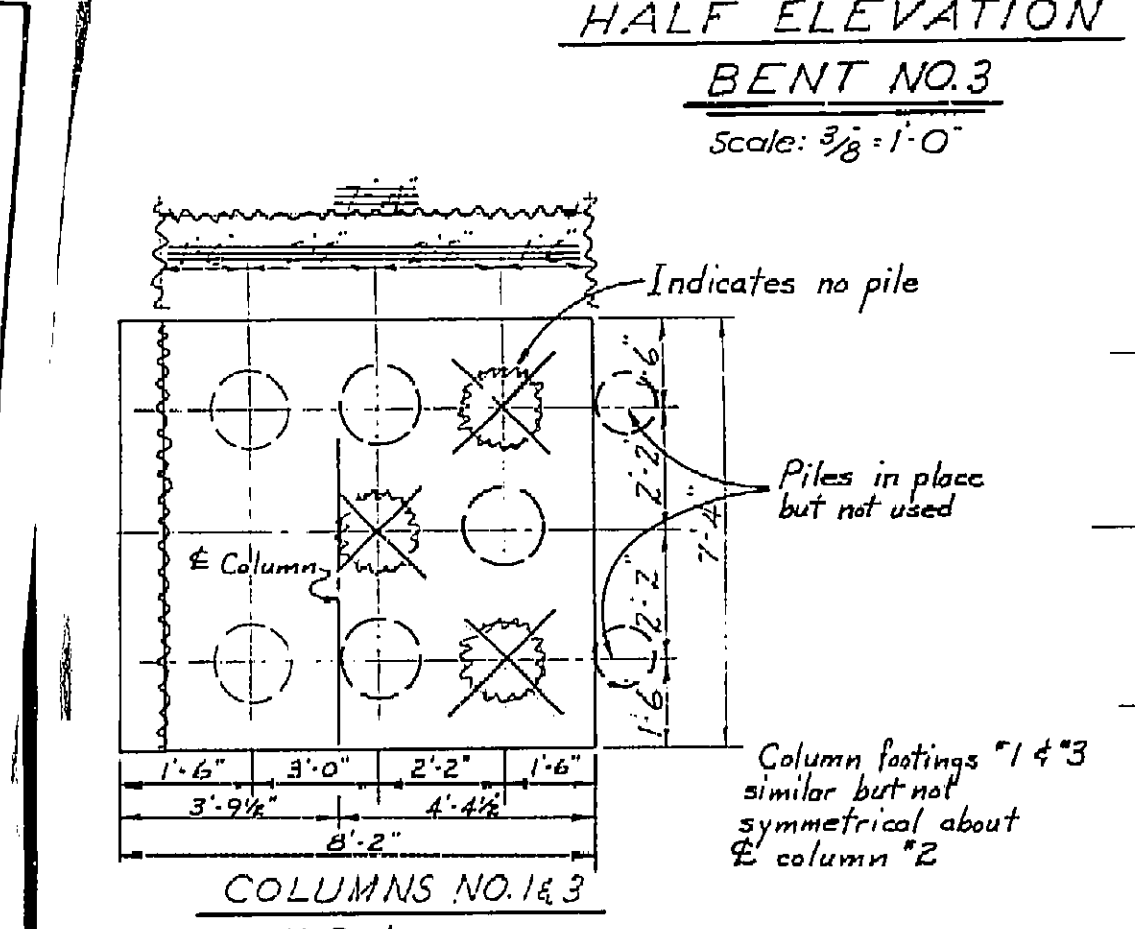


**FOOTING PLAN**  
Scale: 3/8" = 1'-0"

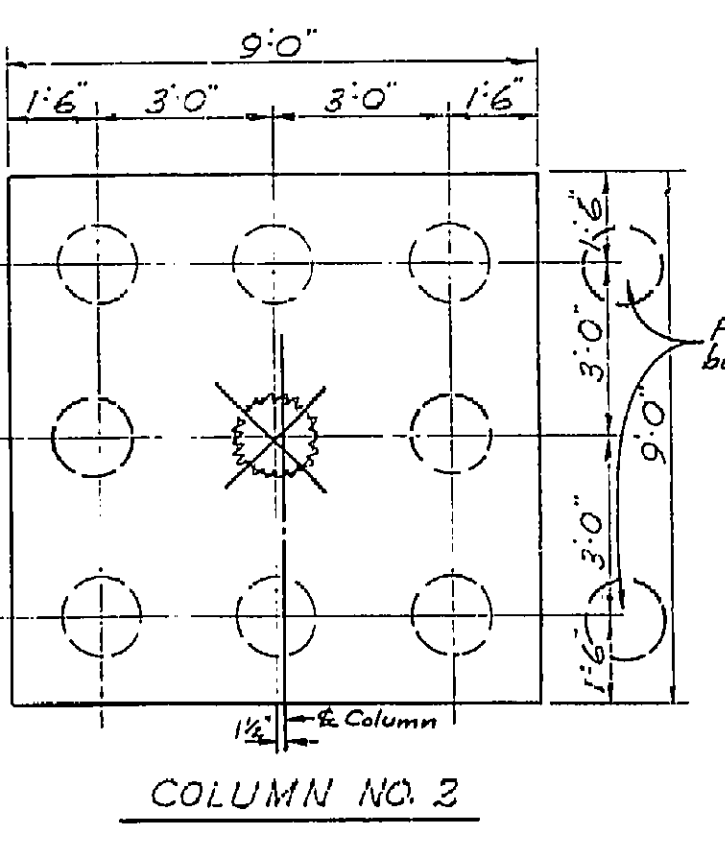


**COLUMN NO. 2**

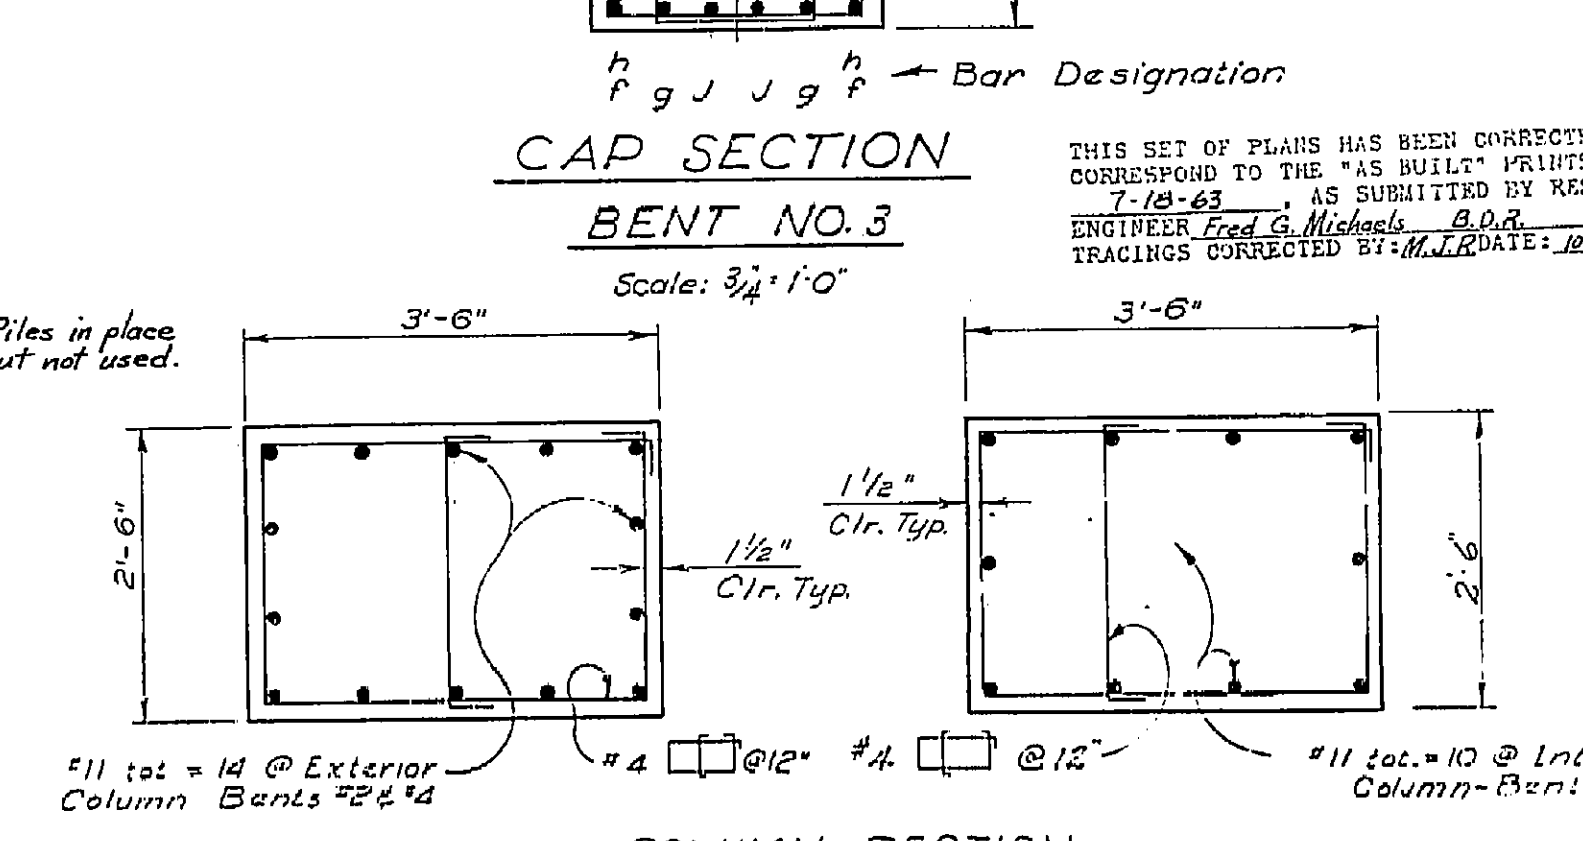

**COLUMN SECTION**  
BENTS 2 & 4  
Scale: 3/4" = 1'-0"

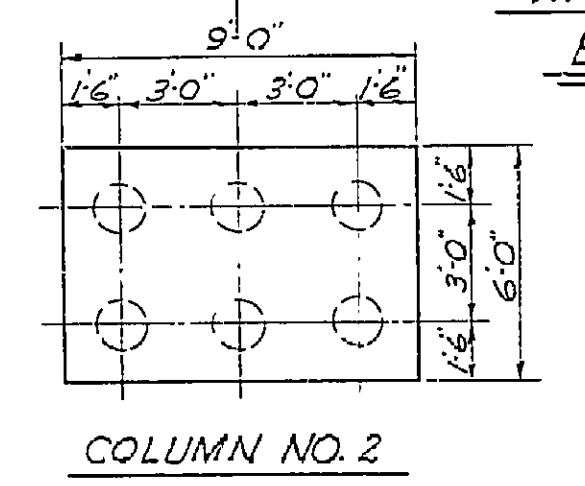

**COLUMN NO. 2**

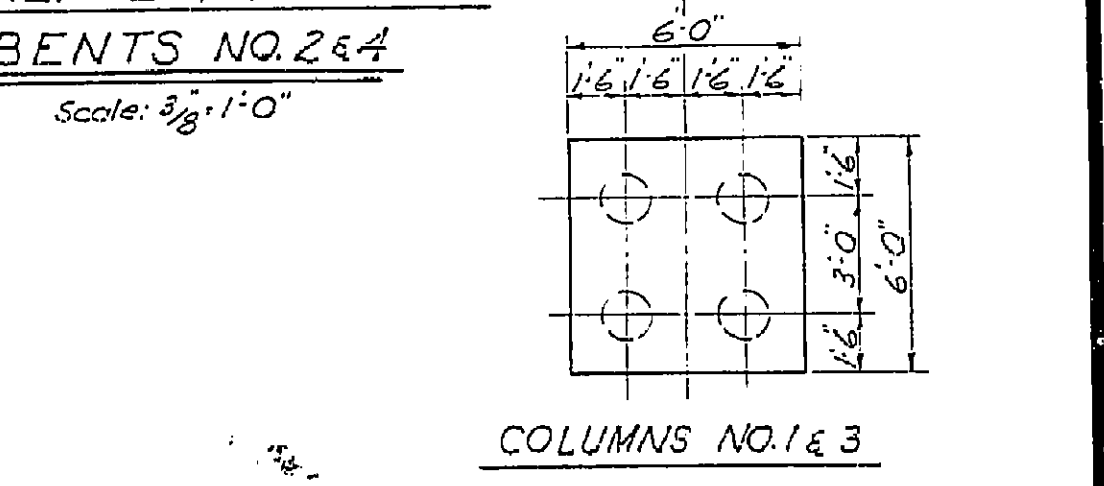


**COLUMNS NO. 1 & 3**

<b>BRIDGE DEPARTMENT</b>		<b>DESIGN SECTION 4</b>		STATE OF CALIFORNIA DEPARTMENT OF PUBLIC WORKS DIVISION OF HIGHWAYS	
Section Supervisor: <i>R. H. Fisher</i>		DESIGN: <i>R. L. S. R. S. H. H. H.</i>		CHESEBRO ROAD OVERCROSSING	
DETAILS: <i>John F. Brown</i>		DETAILS: <i>John F. Brown</i>		BENT DETAILS	
QUANTITIES: <i>John F. Brown</i>		QUANTITIES: <i>John F. Brown</i>		SCALE AS SHOWN BRIDGE 53-1078 FILE DRAWING C-531678-5	
PRELIMINARY DRAWING NO. P-531678-9		REVISION DATES			

**AS BUILT PLANS**  
Contract No. 63-7V13C5B  
Date Completed  
Document No. 70002373

I HEREBY CERTIFY THAT THIS IS A TRUE AND ACCURATE COPY OF THE ABOVE DOCUMENT TAKEN UNDER MY DIRECTION AND CONTROL ON THIS DATE IN SACRAMENTO, CALIFORNIA PURSUANT TO AUTHORIZATION BY THE DIRECTOR OF PUBLIC WORKS.

DATE: 11 72 SIGNATURE: *John F. Brown* TITLE: *Engineer*


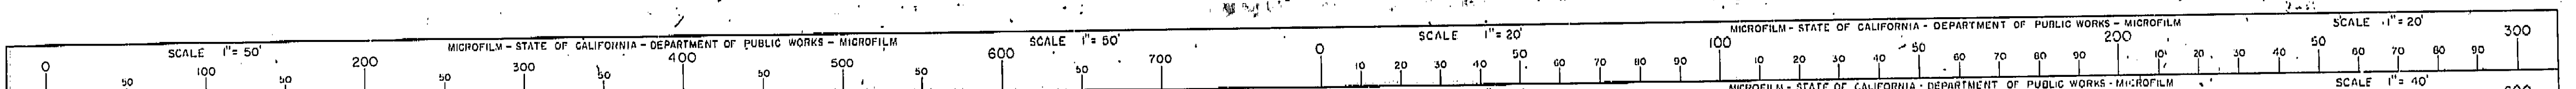


FED. ROAD DISTRICT	STATE	F. A. PROJECT NO.	SHEET NO.	TOTAL SHEETS
7	CALIF.		36	11

DIST.	COUNTY	ROUTE	SECTION	SHEET NO.	TOTAL SHEETS
VI	LA	5		6	16

Note:  
Anticipated deflection due to placing of deck = 1/8" at midspan of the 90 prestressed girder span & 1/4" at midspan of the 78 prestressed girder span. Final deck grade and camber to be determined by the Engineer.



Note:  
For Barrier Railing Details not shown See Sheets # 12 & 13  
For Precast Prestressed Girder Details See Sht # 10

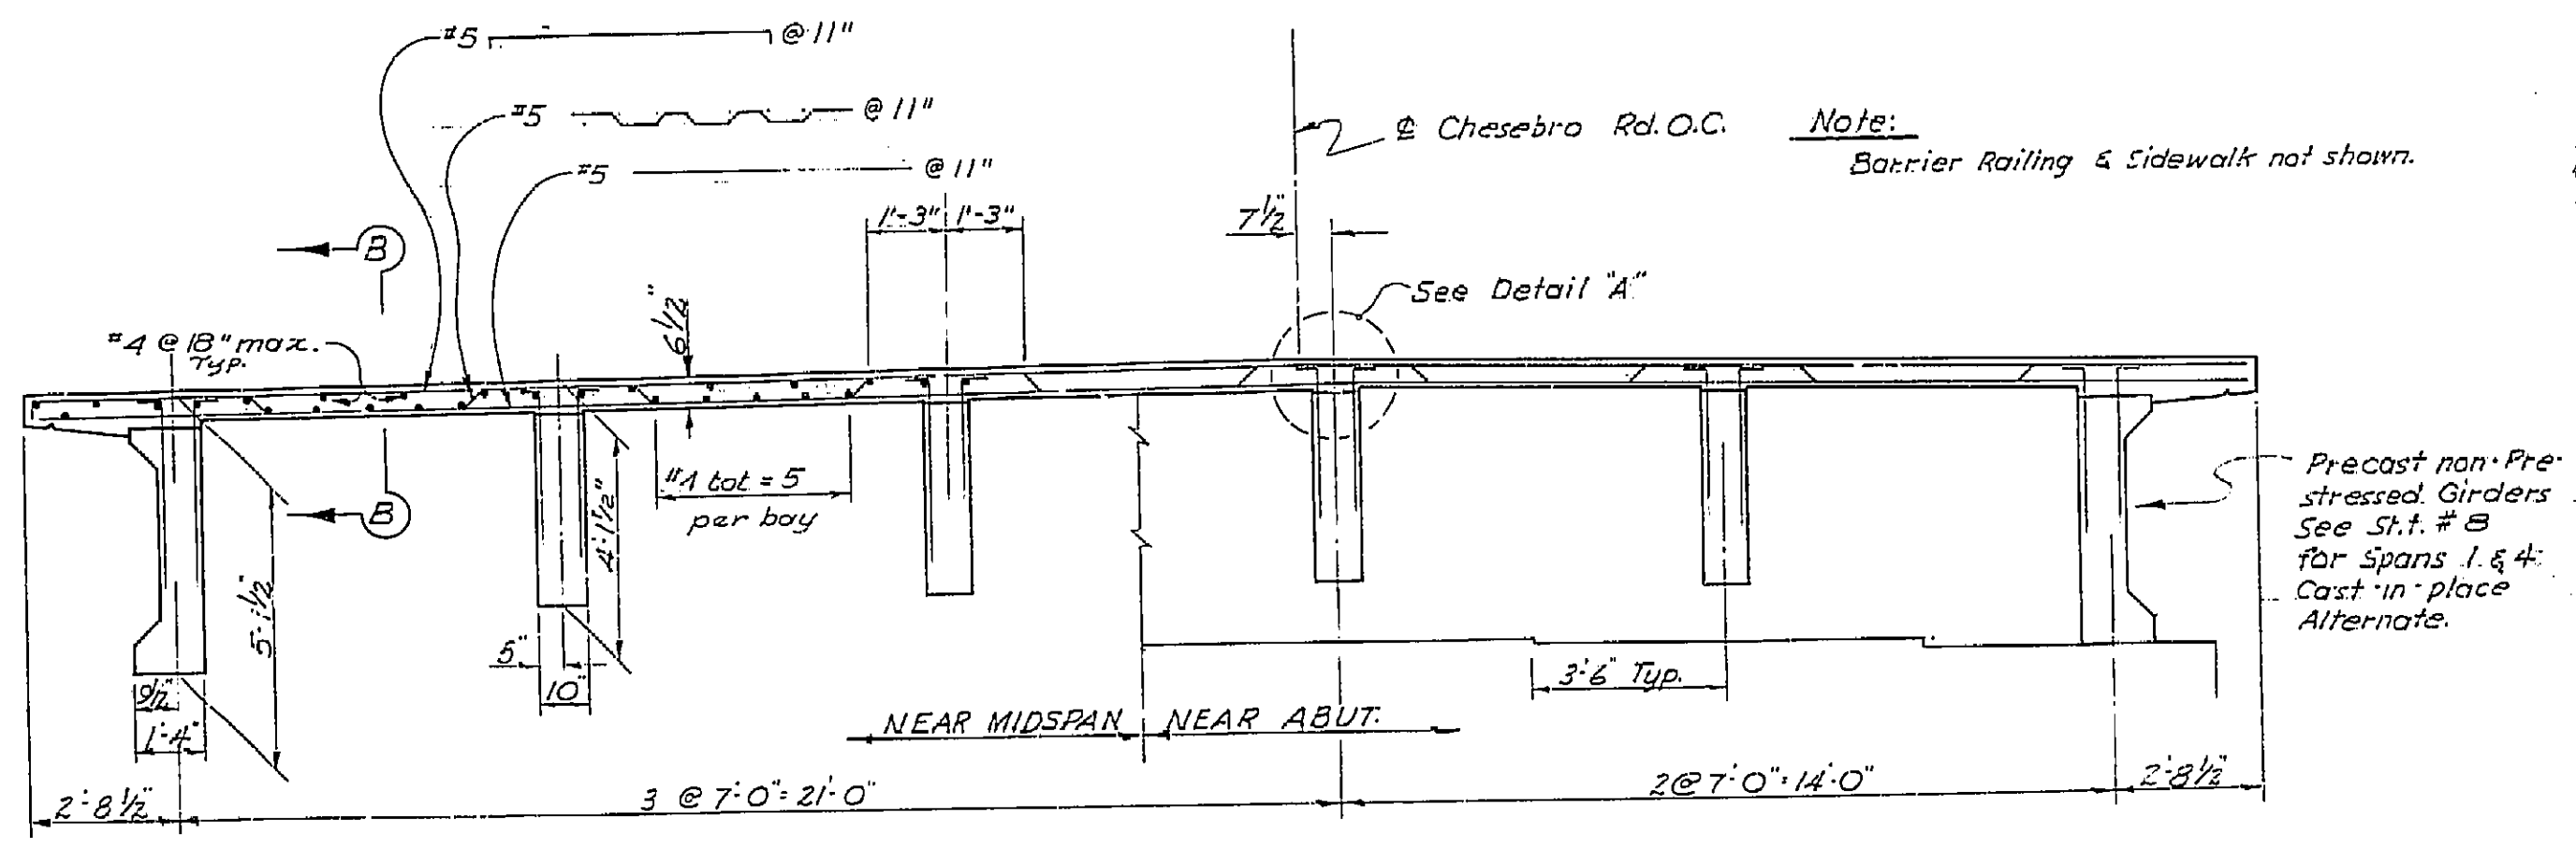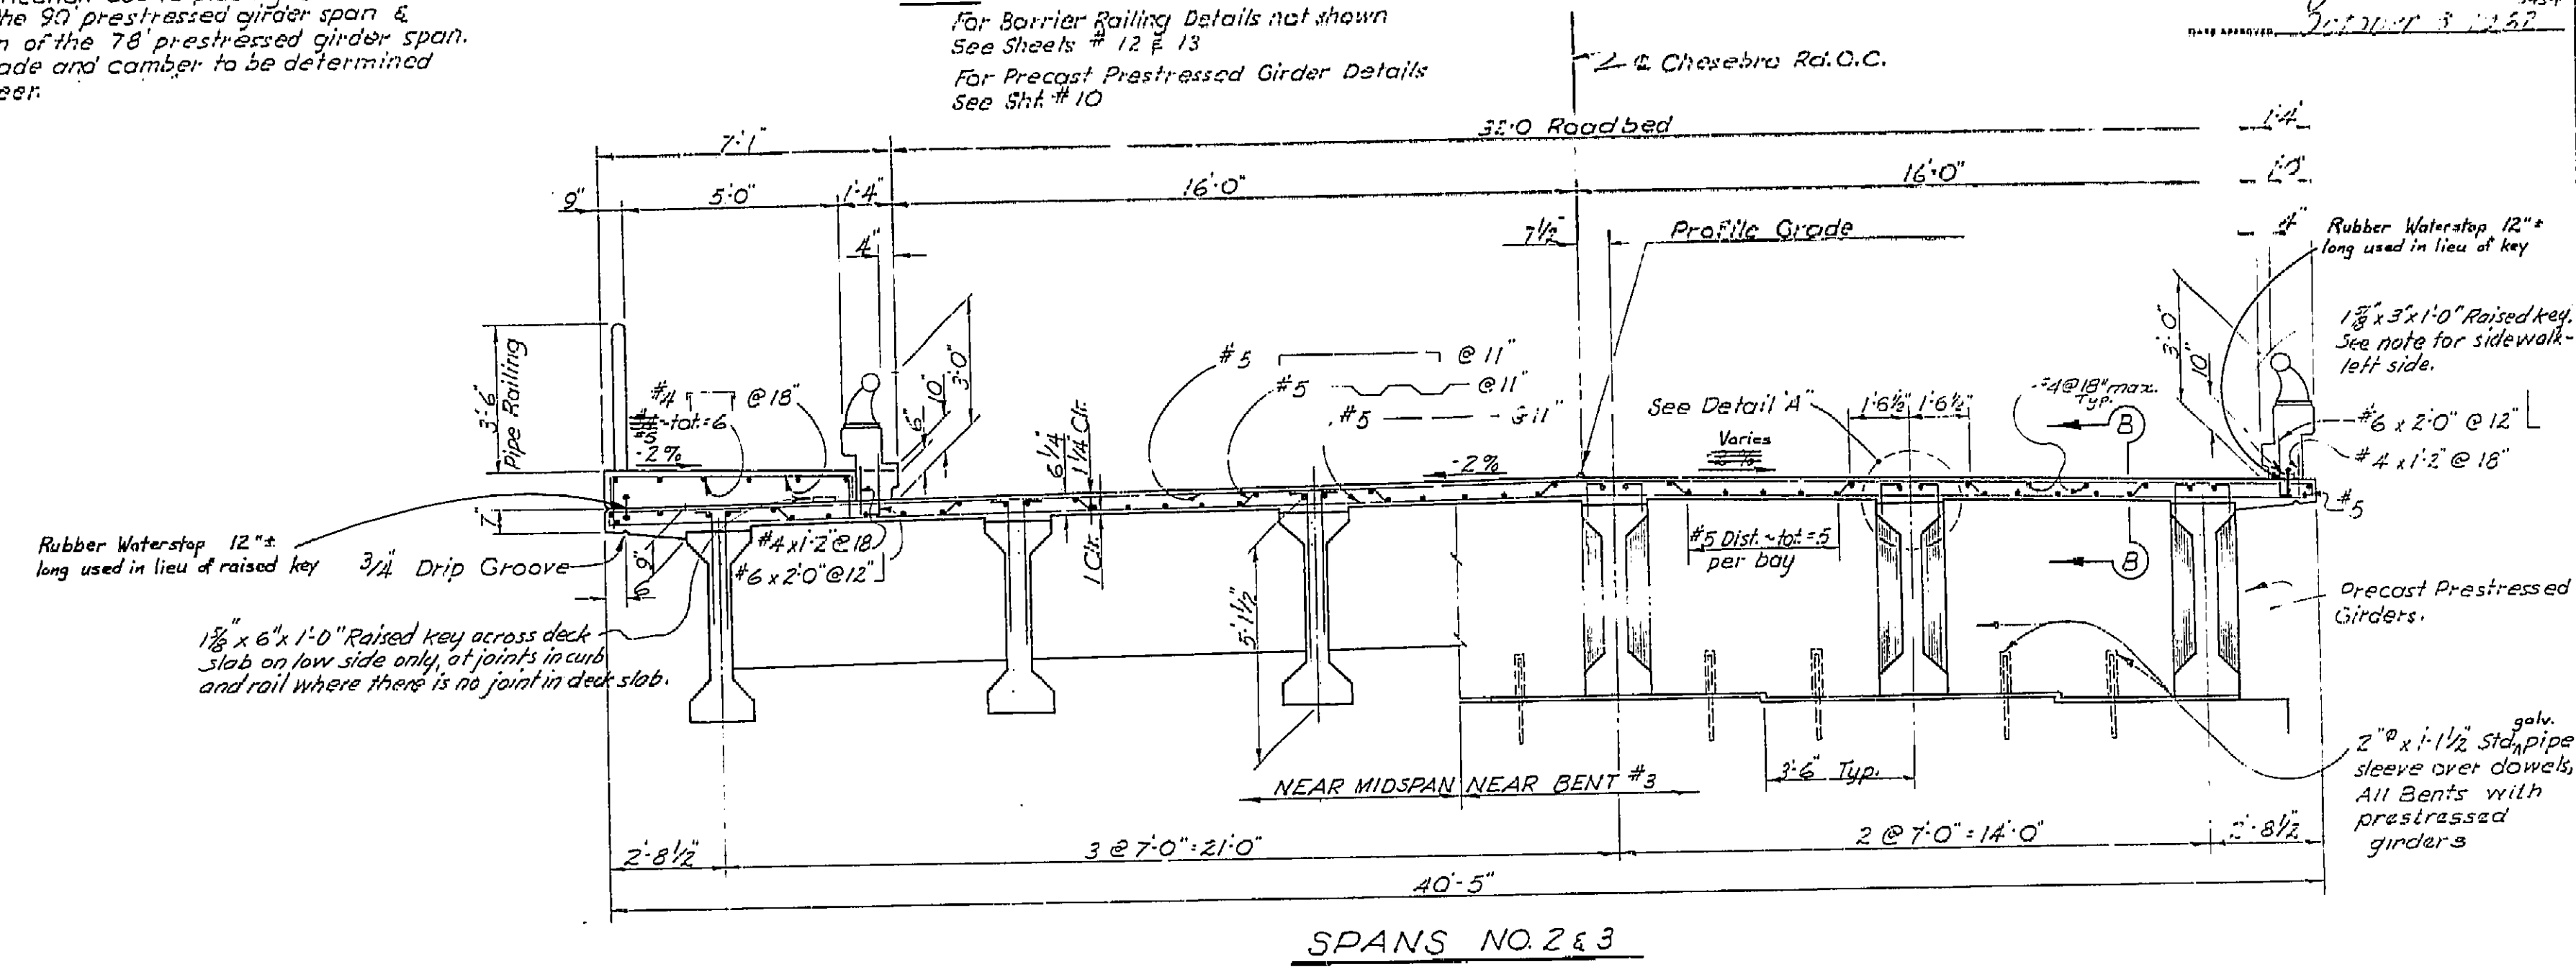

SPANS NO. 1 & 4  
(For Details Not Shown See Spans No. 2 & 3)  
TYPICAL SECTIONS  
Scale: 3/8" = 1'-0"


THIS SET OF PLANS HAS BEEN CORRECTED TO CORRESPOND TO THE "AS BUILT" PRINTS DATED 7-18-63 AS SUBMITTED BY RESIDENT ENGINEER Fred G. Michaels, B.O.B. TRACINGS CORRECTED BY: M.L.R. DATE: 10-25-63

**AS BUILT PLANS**  
Contract No. 63-7V13C58  
Date Completed \_\_\_\_\_  
Document No. 7000 2373

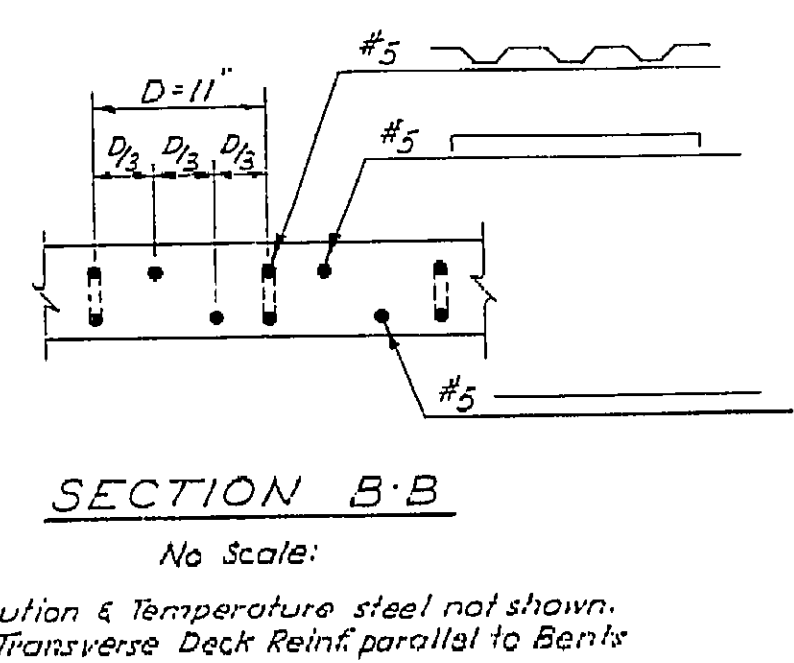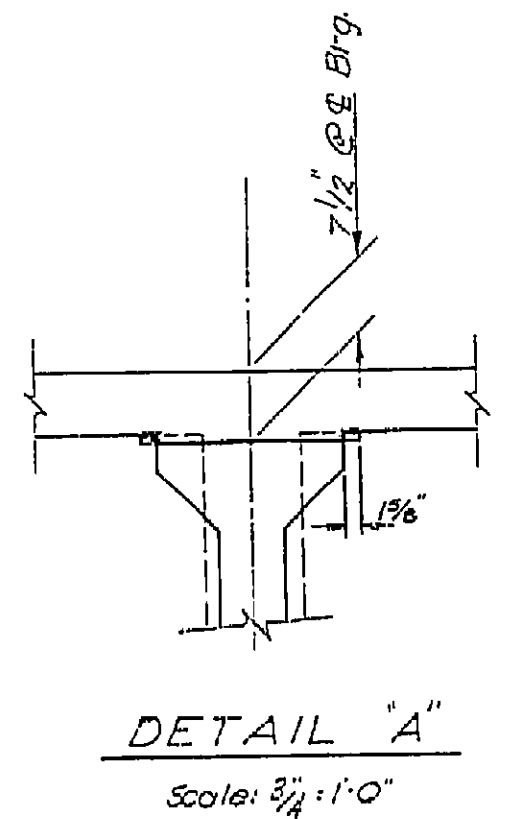

BRIDGE DEPARTMENT DESIGN SECTION <b>4</b>		STATE OF CALIFORNIA DEPARTMENT OF PUBLIC WORKS DIVISION OF HIGHWAYS	
Section Supervisor <i>R. E. [Signature]</i>	DESIGN By E.L.S. R.S.B. 11/61	CHESEBRO ROAD OVERCROSSING	
DETAILS By [Signature]	QUANTITIES By [Signature]	TYPICAL SECTIONS	
SCALE AS SHOWN		BRIDGE 53-1678	FILE
PRELIMINARY DRAWING NO. P-531678-2		DRAWING C-531678-6	

I HEREBY CERTIFY THAT THIS IS A TRUE AND ACCURATE COPY OF THE ABOVE DOCUMENT TAKEN UNDER MY DIRECTION AND CONTROL ON THIS DATE IN SACRAMENTO, CALIFORNIA PURSUANT TO AUTHORIZATION BY THE DIRECTOR OF PUBLIC WORKS.  
DATE 1-15-72 SIGNATURE [Signature] TITLE [Title]

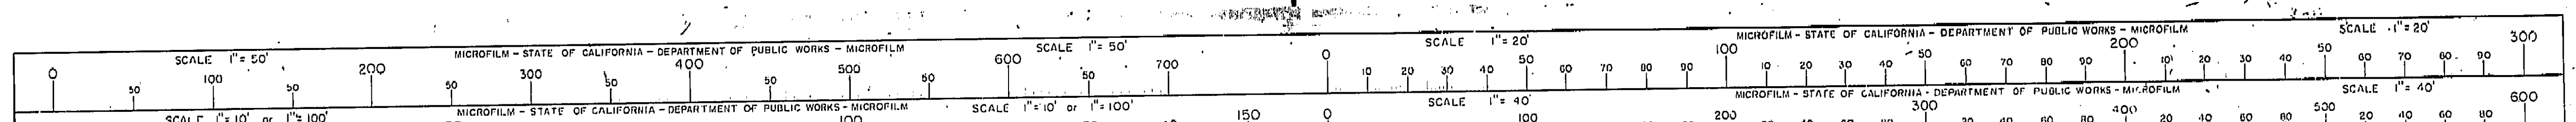

**APPENDIX C**

**RESPONSE TO CALTRANS REVIEW COMMENTS**



## APPENDIX C

### RESPONSE TO CALTRANS REVIEW COMMENTS

---

Kleinfelder submitted this Preliminary Geotechnical Report dated December 22, 2010 to the California Department of Transportation (Caltrans) for review. Kleinfelder subsequently received review comments dated February 2, 2011 on the report from Caltrans Office of Geotechnical Design – South 1. The Caltrans review comments and our responses to the comments are presented below. A copy of the Caltrans comment letter dated February 2, 2011 is included in this Appendix for reference. Our responses to the comments have been incorporated into this revised report as applicable.

**Comment No. 1.** *Table 1 on page 8 of 19:  $F_{norm}$  and  $F_{rev}$  should be revised to 0 and 1, respectively. Also,  $R_{jb}$  should be verified since the  $R_{jb}$  is greater than 3.8 km based on calculation using fault parameters from the 2007 Fault Database.*

**Response to Comment No. 1.** The values of 1 and 0 for  $F_{norm}$  and  $F_{rev}$  were transposed in Table 1 due to a typographical error. The values have been corrected as requested. A value of 4.7 km was calculated graphically for  $R_{jb}$ . A value of 3.8 km was estimated for  $R_{jb}$  by the ARS Online program. Our recommendations are based on an  $R_{jb}$  value of 3.8 km to be conservative. However, it should be noted that this does not affect the design response spectrum since the probabilistic response spectrum was found to govern over the deterministic response spectrum at all periods at this site.

**Comment No. 2.** *Plate 4a: please provide calculation and/or reference backup for Displacement Response Spectral curve, and also describe the use of this curve in seismic analysis. If it is unnecessary information, please remove it.*

**Response to Comment No. 2.** Based on our communication with representatives of Kimley-Horn and Associates, Inc., we understand that the displacement response spectral curve is not required for analysis during this phase of the project. Therefore, it has been removed from our report.

**Comment No. 3.** *Section 10.4 on page 9 of 19: please provide calculation backup for liquefaction analysis if the analysis was conducted.*

**Response to Comment No. 3.** Liquefaction calculations were not performed at this stage of the project. Our evaluation of the liquefaction potential at the site was based on preliminary screening. Based on the fact that the assumed historic shallow groundwater elevation of 890 feet is below the elevation that bedrock is shown on the as-built Log of Test Borings, it is our professional opinion that the potential for liquefaction to impact site is low.

The potential for liquefaction to occur at the project site should be re-evaluated during the PS&E phase of the project after completion of exploratory borings at the site and laboratory testing.

# Memorandum

*Flex your power!  
Be energy efficient!*

**To:** MR. KHAN HOSSAIN  
Senior Transportation Engineer  
Office of Design D

**Date:** February 2, 2011  
**File:** 07-LA-101-PM33/34.4  
07-257200  
Oversight

**From:** DEPARTMENT OF TRANSPORTATION  
DIVISION OF ENGINEERING SERVICES  
Geotechnical Services  
Office of Geotechnical Design – South 1

**Subject:** Review of Preliminary Geotechnical Report for US 101 Palo Comado Canyon Road Interchange Improvement Project

Per your request, the Office of Geotechnical Design – South 1 of the Division of Engineering Services has preformed a review of Draft Preliminary Geotechnical Report for the subject project. The review is limited to geotechnical aspect of the project. The information provided and reviewed for this project is listed as follows:

- Draft Preliminary Geotechnical Report for US 101 Palo Comado Canyon Road Interchange improvement in city of Agoura Hills, California, prepared by Kleinfelder West, Inc. for Kimely-Horn and Associates, Inc. on December 22, 2010.

In addition, it is our understanding that a Preliminary Foundation Report prepared by Group Delta was reviewed.

Based on the review of the report, our comments are as follows:

1. Table 1 on page 8 of 19:  $F_{norm}$  and  $F_{rev}$  should be revised to 0 and 1, respectively. Also,  $R_{jb}$  should be verified since the  $R_{jb}$  is greater than 3.8 km based on calculation using fault parameters from the 2007 Fault Database.
2. Plate 4a: please provide calculation and/or reference backup for Displacement Response Spectral curve, and also describe the use of this curve in seismic analysis. If it is unnecessary information, please remove it.
3. Section 10.4 on page 9 of 19: please provide calculation backup for liquefaction analysis if the analysis was conducted.

MR. KHAN HOSSAIN  
February 2, 2011  
Page 2

Oversight  
EA 07-257200

If you have any questions or comments, please contact me at 916-227-4533.

SEUNGWOON HAN, PH.D, P.E.  
Transportation Engineer - Civil  
Office of Geotechnical Design-South 1