

**PRELIMINARY FOUNDATION REPORT  
PALO COMADO OC a.k.a. CHESEBRO RD OC (WIDEN)  
BRIDGE NO. 53-1678  
07-LA-101-PM 33.69  
AGOURA HILLS, CALIFORNIA**

**Prepared for**

**Parsons Transportation Group, Inc.  
2201 Dupont Dr # 200  
Irvine, CA 92612**

**Prepared by**

**GROUP DELTA CONSULTANTS, INC.  
92 Argonaut, Suite 120  
Aliso Viejo, California 92656  
Tel. (949) 609-1020  
Fax (949) 609-1030**



**GDC Project No. L-783  
January 2, 2008  
(Revised February 5, 2009)**



Certified MBE

Geotechnical Engineering

Geology

Hydrogeology

Earthquake Engineering

Materials Testing & Inspection

Forensic Services

January 2, 2008 (Revised February 5, 2009)

Parsons Transportation Group  
2201 Dupont Drive Suite 200  
Irvine, CA 92612

Attention: Mr. Thomas E. Sardo

Subject: Preliminary Foundation Report  
Palo Comado OC a.k.a. Chesebro Rd OC (Widen)  
Bridge No. 53-1678  
07-LA-101-PM 33.69  
Agoura Hills, California  
GDC Project No. L-783

Dear Mr. Sardo:

Group Delta Consultants is pleased to submit our Preliminary Foundation Report for the subject bridge improvements. The report is based on review of existing information, and is to be included as part of the Advance Planning Study and Type Selection submittal. This report was prepared in general accordance with Caltrans Guidelines for Foundation Investigations and Reports (v. 1.2, June 2002). We have updated our report based on Caltrans Geotechnical Review Comments (see Appendix C).

We appreciate the opportunity to provide our services on this project and look forward to working with during the design and construction of the project.

If you have any questions, please call.

Sincerely,

**GROUP DELTA CONSULTANTS, INC.**

Curt Scheyhing, P.E.  
Senior Engineer



Kul Bhushan, Ph.D., G.E.  
Sr. Consulting Principal



## TABLE OF CONTENTS

<b>1.0 INTRODUCTION</b>	<b>1</b>
1.1 Project Description	1
1.2 Project Location	1
<b>2.0 SITE AND SUBSURFACE CONDITIONS</b>	<b>2</b>
2.1 Topography and Drainage	2
2.2 Site Geology	2
2.3 Soil and Bedrock Conditions	2
2.4 Groundwater	3
2.5 Seismicity	3
<b>3.0 AS-BUILT DATA</b>	<b>4</b>
3.1 General	4
3.2 Existing Bridge and Foundations	4
<b>4.0 SEISMIC EVALUATION</b>	<b>5</b>
4.1 Potential Seismic Hazards	5
4.2 Ground Surface Rupture	5
4.3 Ground Motion	5
4.4 ARS Curve	6
4.5 Liquefaction Evaluation	7
4.6 Other Seismic Hazards	7
<b>5.0 PRELIMINARY FOUNDATION RECOMMENDATIONS</b>	<b>8</b>
5.1 Existing Foundations	8
5.1.1 Axial Pile Capacities	8
5.1.2 Lateral Pile Capacities	8
5.1.3 Abutment Passive Resistance	8
5.2 New Foundations	9
5.2.1 Axial Pile Capacities	9
5.2.2 Lateral Pile Capacities	9
5.3 Pile Installation	9
5.4 Scour Potential	10
5.5 Soil Corrosion Potential	10
<b>6.0 ADDITIONAL INVESTIGATIONS</b>	<b>10</b>
<b>7.0 LIMITATIONS</b>	<b>10</b>

### LIST OF TABLES

Table 1	Summary of As-Built Foundation Characteristics
---------	--



## LIST OF FIGURES

Figure 1	Vicinity Map
Figure 2	Aerial Photographs
Figure 3	As-Built General Plan
Figure 4	As-Built Foundation Plan
Figure 5	Geologic Map
Figure 6	As-Built Log of Test Borings
Figure 7	Historically Highest Groundwater Map
Figure 8	Caltrans 1996 Seismic Hazard Map
Figure 9	Liquefaction Hazard Zone Map
Figure 10	Recommended ARS Curves

## LIST OF APPENDICES

Appendix A	As-Built Plans (Original Construction)
Appendix B	As-Built Plans (Pre-stressed I-Girder Replacement)
Appendix C	Caltrans Comments and Responses



**PRELIMINARY FOUNDATION REPORT  
PALO COMADO OC A.K.A. CHESEBRO ROAD OC (WIDEN)  
BRIDGE NO. 53-1678  
07-LA-101-PM33.69  
AGOURA HILLS, CALIFORNIA**

## **1.0 INTRODUCTION**

### **1.1 Project Description**

Based on review of the Request for Proposals (RFP), we understand that the City of Agoura Hills in cooperation with Caltrans proposes to widen the Palo Comado OC (a.k.a. Chesebro Road OC) over the U.S. Route 101 in Los Angeles County (see Figures 1 and 2). The existing bridge constructed in 1963 is a 4-span structure that will be widened as part of this project. The as-built General Plan and Foundation Plan are shown in Figures 3 and 4, respectively. The overcrossing currently contains one lane of traffic in each direction, and has a sidewalk on the west side of the bridge. No plans showing the extent or location of the widened structure are currently available, nor was the information included in the RFP; therefore we assume that widening may take place on one or both sides of the existing bridge. Ancillary improvements also include minor ramp and traffic modifications, possible future integration into a roundabout north of the bridge, and other related changes.

### **1.2 Project Location**

The site coordinates are approximately:

- Latitude: 34.1433°
- Longitude: -118.7379°

A vicinity map is included in Figure 1.



## 2.0 SITE AND SUBSURFACE CONDITIONS

### 2.1 Topography and Drainage

The ground surface elevation on Chesebro Rd / Palo Comado Rd is between El. 933.5 and 934.0 feet at the abutments. The elevation at the freeway level ranges from about El. +910 feet below the south abutment to about El. 914 feet below the north abutment. Freeway drainage flows to the west. Slopes below the abutments are inclined at 1.5h: 1v and abutment approach side slopes range from 1.5h: 1v to 2h: 1v.

### 2.2 Site Geology

Based on the "Preliminary Geologic Map of the Los Angeles 30'x60' Quadrangle," (Yerkes and Campbell, 2005) the natural site geology at the bridge site consists of relatively young shallow alluvial deposits originating from Palo Comado and Cheseboro Canyons, overlying bedrock of the Calabasas Formation (Tcb). The site is shown on the geologic map in Figure 5, which shows Tcb exposed at the surface to the northeast of the bridge. Calabasas Formation undivided (early late Miocene and late middle Miocene) is generally interbedded clayey to silty sandstone and silty shale, containing local beds of sedimentary breccia (probable Conejo Volcanics) clasts. Many sandstone beds are lithologically similar to those in overlying, less-deformed Modelo Formation. Approach fills have been placed at the abutments over alluvial and bedrock materials.

### 2.3 Soil and Bedrock Conditions

One rotary boring and two penetration borings were performed at the site in June 1961, as shown on the as-built Log of Test Borings (LOTB) in Figure 6. The rotary boring was drilled to a depth of about 40 feet. The penetration borings reached refusal at depths of about 20 to 25 feet. Logs from Cast-in-Drilled-Hole (CIDH) piles installed in 1962 are also shown in the LOTB. ***Note: It appears that the pile logs may be shown at the wrong supports, since the bottom of footing elevations shown on the LOTB pile logs are reversed from those shown on the foundation plan. For example, the LOTB shows bottom of footing at Bent 2 to be at El. 907, while the Foundation Plan shows El. 900 feet for Bent 2.***

The LOTB indicates the sites is underlain by shallow alluvial soils or fill to depths of up to about 10 feet below freeway grade, which are in turn underlain by clay-silt shale materials. Approach fills up to about 25 feet high overlie the alluvium / shale at the abutments. The alluvial soils are generally clayey / silty materials and range from about 1 to 10 feet in depth below freeway grades. Bedrock underlying the alluvial materials is described as tan and gray clay-siltstone shale, which is considered a soft rock or hard clayey soil. The top of the shale appears to range



between El. 900 and 910 feet. No soils information is provided on the abutment fills.

## 2.4 Groundwater

Borings performed at the site in June 1961 did not encounter groundwater to depths of roughly 40 feet. Pile logs performed during original pile construction in 1962 encountered perched groundwater within the shale at a depth of roughly 25 feet below freeway grade (approximately El. +887 feet).

Based on California Geological Survey Seismic Hazard Evaluation of the Calabasas 7.5-Minute Quadrangle (2001), the highest historical groundwater at the subject bridge is approximately 20 foot deep (see Figure 7). Reference depth is unknown, but assuming freeway grade as reference depth the high historical groundwater depth appears similar to the groundwater conditions shown on the As-Built LOTB. Perched groundwater may be encountered in the shale at 20 to 25 feet below freeway grades.

## 2.5 Seismicity

The site location is shown on the Caltrans 1996 Seismic Hazard Map in Figure 8. Using Caltrans deterministic methodology, design accelerations are based on the rated Magnitudes of the Faults, the fault to site distances, and the type of faulting (reverse, thrust, strike-slip, etc.). As indicted in Figure 8, the parameters for the closest contributing faults to the site are:

Fault Name <sup>1</sup>	Fault Type <sup>1</sup>	Magnitude <sup>1</sup>	Distance <sup>2</sup> (km)
Chatsworth South (CWS)	Unclassified	6.25	7
Chatsworth North (CWN)	Unclassified	6.5	10
Malibu Coast-Santa Monica-Hollywood-Raymond (MMR)	Reverse-Oblique	7.5	12

1. From Caltrans "A Technical Report to Accompany the Caltrans California Seismic Hazard Map 1996 (Based on Maximum Credible Earthquakes)."
2. Scaled from Caltrans "Caltrans California Seismic Hazard Map 1996."



### 3.0 AS-BUILT DATA

#### 3.1 General

GDC evaluated foundation systems for the subject bridge based on the original 1962 As-Built plans (see Appendix A). The As-Built General Plan is shown in Figure 3, the As-Built Foundation Plan is shown in Figure 4, and the As-Built Log of Test Boring (LOTB) is shown in Figure 6.

It appears that the footing elevations for Bent 2 and 4 are reversed on the LOTB relative to the As-Built Foundation Plan. For purposes of this report, it has been assumed that the footing elevations on the As-Built Foundation Plan are correct. Due to the discrepancy between the LOTB and the Foundation Plan, tip elevations may have been transposed between Bents 2 and 4. Therefore, in our summary of existing pile tip elevations in Table 1, we have given a range to account for the differences between Bents 2 and 4.

#### 3.2 Existing Bridge and Foundations

A brief summary of the existing bridge and foundations is presented below:

- The bridge structure is a four-span bridge with pre-stressed pre-cast "I" girders built in 1963 (see Figure 3). One I-girder was replaced on span 3 in 2006 (see Appendix B);
- All foundations are supported on 45-ton (90 kip) design capacity Cast In Drilled Hole (CIDH) piles (pile diameter = 16 inches);
- The bottom of footing elevation at both abutments is El. 924.5 feet. Average tip elevation at the abutments is El. +886.5 feet. The average pile penetration length at the abutments is 38 feet (see Figure 6);
- Based on the Foundation Plan (Figure 4) the bottom of footing elevation at Bent 2 is El. 900 feet. Average tip elevation at Bent 2 is about El. 884 to 887 feet. The average pile penetration length is about 13 to 16 feet;
- Bottom of footing elevation at Bent 3 is 903 feet. The average tip elevation at Bent 3 is El. 881 feet. The average pile penetration length is 22 feet;
- Bottom of footing elevation at Bent 4 is 907 feet. The average tip elevation at Bent 4 is at El. 884 to 887 feet. The average pile penetration length is 20 to 23 feet;

A summary of each existing foundation support is presented in Table 1.





## **4.0 SEISMIC EVALUATION**

### **4.1 Potential Seismic Hazards**

The project is located in a seismically active area. Potential geologic and seismic hazards for the site include ground rupture, seismic shaking, slope instability, lateral spreading, subsidence, liquefaction, seismic compaction and settlement, and tsunamis / flooding. The site is located in a state liquefaction hazard zone as shown in Figure 9. The site location on Caltrans 1996 Seismic Hazard Map is illustrated in Figure 8.

### **4.2 Ground Surface Rupture**

The site is not located in an Alquist-Priolo Earthquake Fault Zone. No active faults are known to cross the site or project toward the site. The closest fault is at a distance of 7 km. Due to the distance from the closest faults ground rupture due to faulting is not considered a significant hazard at the site, and a fault rupture investigation is not needed. However, ground shaking due to nearby and distant earthquakes should be anticipated during the life of the bridge.

### **4.3 Ground Motion**

GDC evaluated seismic data from the Caltrans California Seismic Hazard Map (Figure 8) and accompanying Report (1996). The bridge site is located between the 0.4 and 0.5g Peak Bedrock Acceleration (PBA) contours, which is rounded up to a design PBA of 0.5g. The closest potentially controlling faults to the site are the Chatsworth South Fault at a distance of 7 km with a rated maximum credible magnitude (MCE) of 6.25, the Chatsworth North Fault at a distance of 10 km with a rated magnitude of 6.5, and the Malibu Coast-Santa Monica-Hollywood-Raymond Fault with Magnitude 7.5 at a distance of 12 km from the site.

Caltrans Guidelines for Foundation Investigations and Reports requires verification of the PBA determined above using the attenuation relationships presented by Sadigh et. al. (1997) and Geomatrix, which considers the type of controlling faults and gives 10% higher accelerations for Reverse/Oblique and 20% higher accelerations for Reverse/Thrust type of faulting. A summary of site to closest mapped fault distance, and PBA from Caltrans Map and Sadigh 1997 / Geomatrix for the bridge extents is presented in the following table:



Fault Name Abbreviation (Type)	Fault Name	Fault to Site Distance (km)	Magnitude $M_w$	Deterministic PBA (g's)	
				Rounded Up Caltrans 1996 Map	Sadigh (1997)
CWS (Unclassified)	Chatsworth South	7	6.25	0.5	0.41
CWN (Unclassified)	Chatsworth North	10	6.5	-	0.38
MMR (Reverse/Oblique)	Malibu Coast, Santa Monica, Hollywood, Raymond	12	7.5	0.5	0.43

The unclassified faults have been assumed to be reverse/thrust faults. The largest site acceleration or design PBA is 0.5g.

#### 4.4 ARS Curve

Since the site is underlain at shallow depth by shale bedrock, and the bridge is supported on piles within the bedrock, we recommend Soil Type C for selection of ARS curves. The controlling Caltrans Seismic Design Criteria (SDC) ARS Curve at the site is for Peak Bedrock Acceleration of 0.5g, Soil Profile Type C, and MCE magnitude of 7.25 +/- 0.25. In addition, to account for near-source effect (site less than 15 km from fault), the following adjustments on the spectral acceleration values are recommended on the Caltrans SDC response spectra:

- 20% increase for periods equal to or greater than 1.0 second.
- No changes for periods less than 0.5 second.
- Linear interpolation for periods between 0.5 second and 1.0 second.

The recommended ARS curve is presented in Figure 10.



#### 4.5 Liquefaction Evaluation

Liquefaction involves a sudden loss in strength of a saturated, cohesionless soil (predominantly sands, silty sands, and non-plastic silts) caused by cyclic loading such as an earthquake. This results in temporary transformation of the soil to a fluid mass. Typically, liquefaction occurs in areas where groundwater is less than 50 feet from the surface and where the soils contain zones of saturated loose to medium dense cohesionless materials. The site is located in a mapped liquefaction hazard zone in accordance with California Geological Survey (CGS) Seismic Hazard Zone Report for the Calabasas 7.5 Minute Quadrangle as shown in Figure 9, due to its location in an alluvial canyon.

Groundwater encountered during original pile construction in 1962 was at roughly El. +887 feet or at a depth of about 25 ft below the freeway grade. Highest historical groundwater in this area based on Figure 7 is approximately 20 feet deep, or near El. 890 feet. Based upon the 1962 As-Built LOTB data sheet (Figure 6) earth materials below the highest historical groundwater are shale bedrock not subject to liquefaction. Therefore, potential for liquefaction at the site is low.

#### 4.6 Other Seismic Hazards

The site has no known history of subsidence. The site is generally level, the embankment slopes are only about 25 feet high, were engineered during bridge construction, and the subsurface consists of materials not subject to liquefaction. Therefore, seismic slope stability is not expected to be a major issue. Stability of abutment slopes will be evaluated in the SFR.

All low-lying areas along California's coast are subject to potentially dangerous tsunamis. Tsunamis are long period waves generated primarily from distant and local offshore earthquakes, landslides, or volcanic eruptions. Due to the distance of the site from the coast and site elevations of more than 900 feet above mean sea level (MSL), tsunamis are not considered a significant hazard at the site.



## **5.0 PRELIMINARY FOUNDATION RECOMMENDATIONS**

### **5.1 Existing Foundations**

The bridge is supported on 16-inch diameter CIDH piles penetrating into shale bedrock. A summary of as-built foundations is presented in Table 1.

#### **5.1.1 Axial Pile Capacities**

GDC evaluated the ultimate axial compressive and uplift capacities of the existing piles. Shale bedrock would likely have ultimate compressive skin friction ranging from 2 to 3 ksf, and fill or alluvial materials may have ultimate compressive skin friction of 0.5 to 1 ksf. We neglected end bearing capacity (Caltrans does not allow use of end bearing for CIDH piles less than 2 feet diameter). Based on our evaluation and reported penetration through soils and into shale bedrock, nominal compression of 180 kips and nominal tension of 90 kips appear to be reasonable design values. The recommended ultimate compressive and uplift capacities of the original piles are shown in Table 1.

#### **5.1.2 Lateral Pile Capacities**

Resistance to lateral loads may be developed by passive soil pressures acting on the side of the pile caps, where present, and by the lateral capacity of the piles. The Caltrans Bridge Design Specifications Manual, Section 4.5.6.5.1, recommends a standard lateral capacity of 13 kips for 16 inch diameter CIDH concrete piles at  $\frac{1}{4}$  inch deflection. These values require a minimum SPT N value of 10. Based on the as-built LOTB, this site should satisfy that requirement, and these preliminary lateral capacities may be used for design. Site specific lateral pile capacity at the site should be determined after site-specific borings are performed during the PS&E stage of the project.

#### **5.1.3 Abutment Passive Resistance**

The ultimate lateral capacity of an abutment wall is a function of the height of the abutment wall that is acted on by the passive soil pressure on the backfill. The Caltrans Seismic Design Criteria (SDC), Section 7.8, dated February 2004 recommends a passive pressure of 5 ksf for a wall height of 5.5 feet based on full-scale abutment testing conducted at UC Davis. For wall heights other than 5.5 feet, the passive pressure may be determined by multiplying the 5-ksf value with the ratio  $(H/5.5)$  where H is wall height in feet in accordance with SDC. For higher walls the maximum value of the passive resistance should be limited to 7.3 ksf corresponding to an abutment height of 8 feet.



## 5.2 New Foundations

Similar 16-inch CIDH piles may be used for the proposed widening.

### 5.2.1 Axial Pile Capacities

Assuming the same bottom of footing elevations as the existing bridge, for 45 ton (90 kip) design capacity, pile lengths at abutments of 35 to 40 feet are anticipated, and for nominal compression at bents of 180 kips (2 times design load), pile lengths on the order of 20 to 25 feet are expected. About 10 kips nominal capacity is available for each additional foot of penetration. If higher capacity is required at the bents, 70 ton (140 kip) piles with nominal resistance of 280 kips could be used, with lengths on the order of 30 to 35 feet. Note that Caltrans guidelines do not allow drilled piles in excess of 30 times the diameter, or about 40 feet for the 16 inch piles. Caltrans does not allow use of battered CIDH piles. Caltrans does not allow use of end bearing for piles less than 2 feet diameter.

We recommend that all the piles be installed at a minimum spacing of 2½ pile diameters center-to-center. Since the CIDH Piles will be drilled into bedrock, end bearing is neglected in design, and friction in bedrock is likely higher than estimated, it is our opinion that piles with this minimum spacing will not require a reduction in vertical capacity for group action.

### 5.2.2 Lateral Pile Capacities

Preliminary lateral capacity of 16 inch CIDH concrete piles at abutments and bents may be based on the Caltrans Bridge Design Specifications Manual, Section 4.5.6.5.1. This is 13 kips for the 16 inch CIDH concrete piles at ¼ inch deflection. These values assume a minimum SPT N value of 10. Actual capacity will likely be higher. Group effects on lateral capacity should be considered based on pile spacing and number of rows of piles, in accordance with Caltrans Geo-Research Group, Research Notes, "Lateral Load Tests of Pile Groups Lead to Improved Design Recommendations," GRG Vol. 1, No. 6. Site specific lateral pile capacity at the site should be determined after site-specific borings are performed and foundation layouts are available during the PS&E stage of the project.

## 5.3 Pile Installation

Based on review of the LOTBs, drilling into the shale bedrock can be accomplished with moderate to heavy effort using heavy duty drilling equipment. Soils at the site do not appear to have high caving potential, groundwater is limited to seeps in the bedrock, and therefore open-hole construction is likely to be possible. Detailed recommendations for pile constructability will be provided at the PS&E stage in the Foundation Report, once additional borings are performed.



#### **5.4 Scour Potential**

The site is not located within an existing channel. As such, scour is not considered a significant hazard at the site.

#### **5.5 Soil Corrosion Potential**

Corrosion data for the site is unavailable. As such, corrosion potential of existing site soils will need to be evaluated. Site specific corrosion evaluation for the project should be based upon corrosion sampling and testing per Caltrans Corrosion Guidelines and Bridge Design Specifications.

#### **6.0 ADDITIONAL INVESTIGATIONS**

To develop site specific data for foundation design, we propose a total of five hollow stem auger borings at the site (one per support). Borings would extend below the anticipated pile tips. The results of the borings will be correlated with the existing LOTBs and used to develop final recommendations for the foundation design of the new addition, and retrofit or replacement of the existing bridge. Log of the Test Boring Sheets will be provided in the Foundation Report at the PS&E stage for the proposed widening.

#### **7.0 LIMITATIONS**

GDC's recommendations and evaluations were performed using generally accepted engineering approaches and principles available at this time, and the degree of care and skill ordinarily exercised under similar circumstances by reputable geotechnical engineers practicing in this area. No other representation, either expressed or implied, is included in our report.



## 8.0 REFERENCES

California Department of Conservation, Division of Mines and Geology, "Seismic Hazard Zone Report for the Calabasas 7.5-Minute Quadrangle, Los Angeles and Ventura Counties, California" 1997.

California Department of Conservation, Division of Mines and Geology, "State of California Seismic Hazard Zones, Calabasas Quadrangle," Official Map, February 1, 1998.

Caltrans, "Bridge Design Specifications," April, 2000.

Caltrans, "Corrosion Guidelines," Version 1.0, September 2003.

Caltrans Geo-Research Group, Research Notes, "Lateral Load Tests of Pile Groups Lead to Improved Design Recommendations," GRG Vol. 1, No. 6.

Caltrans, "Guidelines for Foundation Investigations and Reports," Version 1.2, June 2002.

Mualchin, L., and Jones, A. L., "Peak Acceleration From Maximum Credible Earthquake in California (Rock and Stiff Soil Sites)", OFR 92-1, California Division of Mines and Geology, 1996.

Mualchin, L., 1996, "A Technical Report to Accompany the Caltrans California Seismic Hazard Map 1996," A report prepared by the California Department of Transportation, Engineering Service Center, Office of Earthquake Engineering, Sacramento, California, dated July 1996.

Ziony, J.I., Editor, "Evaluating Earthquake in the Los Angeles Region--An Earth Science Perspective", United States Geological Survey Professional Paper 1360, 1985.



***TABLES***

---



**TABLE 1: SUMMARY OF AS-BUILT FOUNDATION CHARACTERISTICS**  
**Palo Comado OC a.k.a Chesebro Road OC, Bridge No. 53-1678**  
**07-LA-101 PM 33.69**

Support Location	Foundation Type	Number of Piles	Capacity			Average Bottom of Pile Cap Elevation	Average Pile Tip Elevation	Average Length of Pile
			Design Compression	Ultimate Compressive	Ultimate Uplift			
			Kips	Kips	Kips			
Abut. 1	Cast In Drilled Hole (CIDH)	5	90	180	90	924.5	886	38.5
Bent 2*	Cast In Drilled Hole (CIDH)	14	90	180	90	900	884 - 887	13 - 16
Bent 3	Cast In Drilled Hole (CIDH)	24	90	180	90	903	881	22.0
Bent 4*	Cast In Drilled Hole (CIDH)	14	90	180	90	907	884 - 887	20 - 23
Abut. 5	Cast In Drilled Hole (CIDH)	5	90	180	90	924.1	887	37.5

**Reference: 1962 As-Built Log of Test Borings (LOTB)as-built sheet**

Notes:


\*Pile data recorded on 1962 As-Built LOTB for Bent 2 and Bent 4 are reversed relative to the As-Built Foundation Plan. For purposes of this report it was assumed that the footing elevation in the Foundation Plan is correct, and that the tip elevations may have been transposed between Bent 2 and Bent 4. Therefore, a range of tip elevations is reported..

1. All piles are vertical (no batter piles).
2. Specified tip elevations are El. +888.0 feet for Abut 1, Abut 5, and Bent 4. Specified tip elevations are El. +882.0 and El. +885.0 feet for Bent 2 and Bent 3, respectively.
3. CIDH pile diameter = 16.0 inches.
4. Recommended axial pile load capacity values for seismic design assuming the piles are in good condition and the connection can transmit the uplift loads. The recommended values are limited to twice the reported design values.



***FIGURES***

---

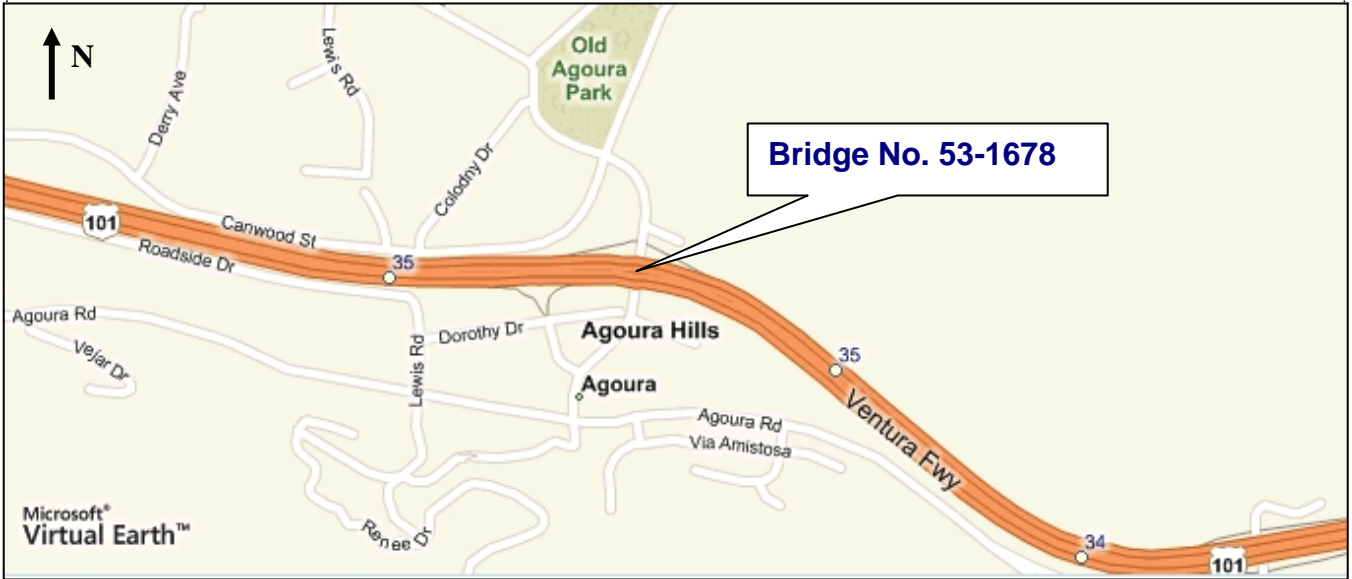

The base maps are from Microsoft's Virtual Earth



GDC Project No. L-783  
 Palo Comado OC  
 (a.k.a. Chesebro Road OC)  
 Improvements  
 Vicinity Map

Figure 1



The base maps are from Microsoft's Virtual Earth and Google Earth



GDC Project No. L-783  
 Palo Comado OC  
 (a.k.a. Chesebro Road OC)  
 Improvements  
 Aerial Photographs

Figure 2



FED. ROAD DIST. NO.	STATE	ROUTE NO.	SECTION	SHEET NO.	TOTAL SHEETS
7	CALIF.			5	7

DATE	BY	REVISION
7-2-63		101

**Concrete Cast-in-Drilled Hole Piles**

Location	Specified Tip Elev.
Abut. #1	888.0
Bent #2	885.0
Bent #3	882.0
Bent #4	888.0
Abut. #5	888.0

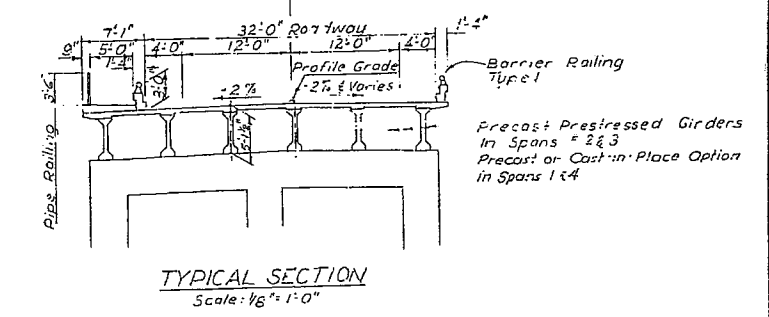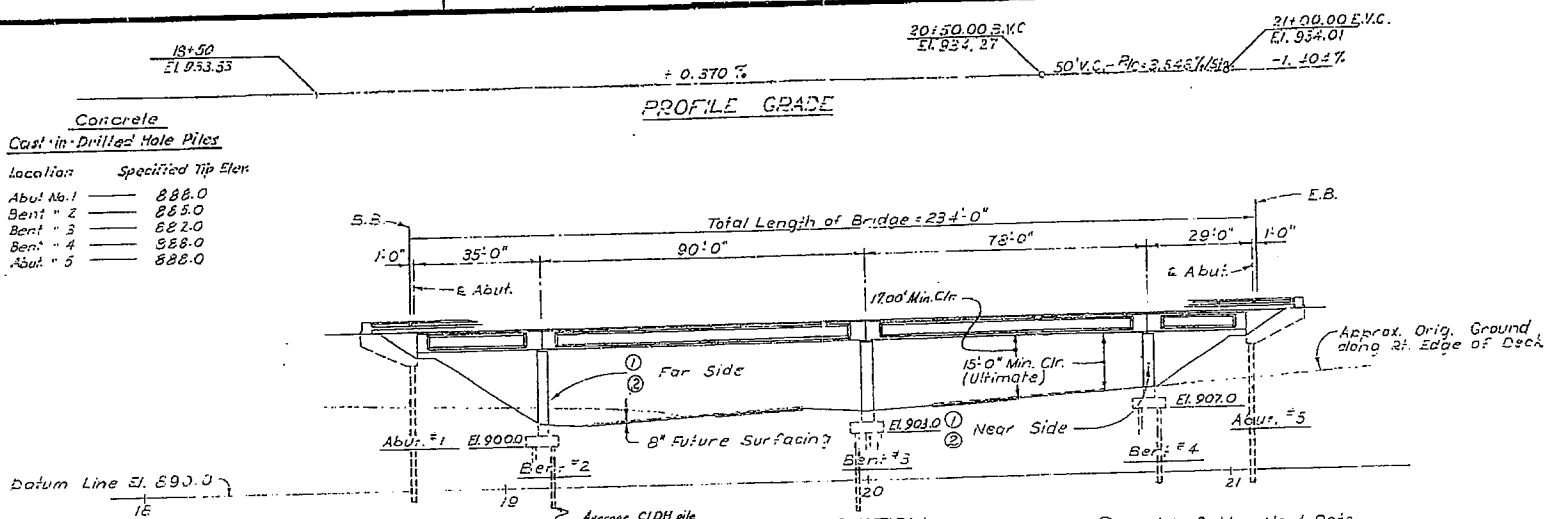

**ELEVATION**  
Scale: 1" = 20'-0"


① = Point Bridge No. & Date  
② = Point Chesebro Rd. O.C.  
⊙ Indicates point of minimum vertical clearance.

Freeway  
A = 40° 19' 26"  
R = 1999.95'  
T = 734.35'  
L = 1407.55'  
N 162° 15' 01" E 64.217 658

**AS BUILT PLANS**  
Contract No. 63-7V13C58  
Date Completed  
Document No. 7000 2373

**INDEX TO PLANS**

Sheet No.	Title
1	General Plan
2	Grid Grades
3	Foundation Plan
4	Abutment Details
5	Bent Details
6	Typical Sections
7	Girder Layout
8	Girder Details Spans 1 & 4 - Precast Alternative
9	Girder Details Spans 1 & 4 - Cast-in-Place Alternative
10	Girder Details Spans 2 & 3
11	Diaphragm Details
12	Barrier Railing Sheet 1
13	Barrier Railing Sheet 2
14	Pipe Railing
15	Log of Test Borings

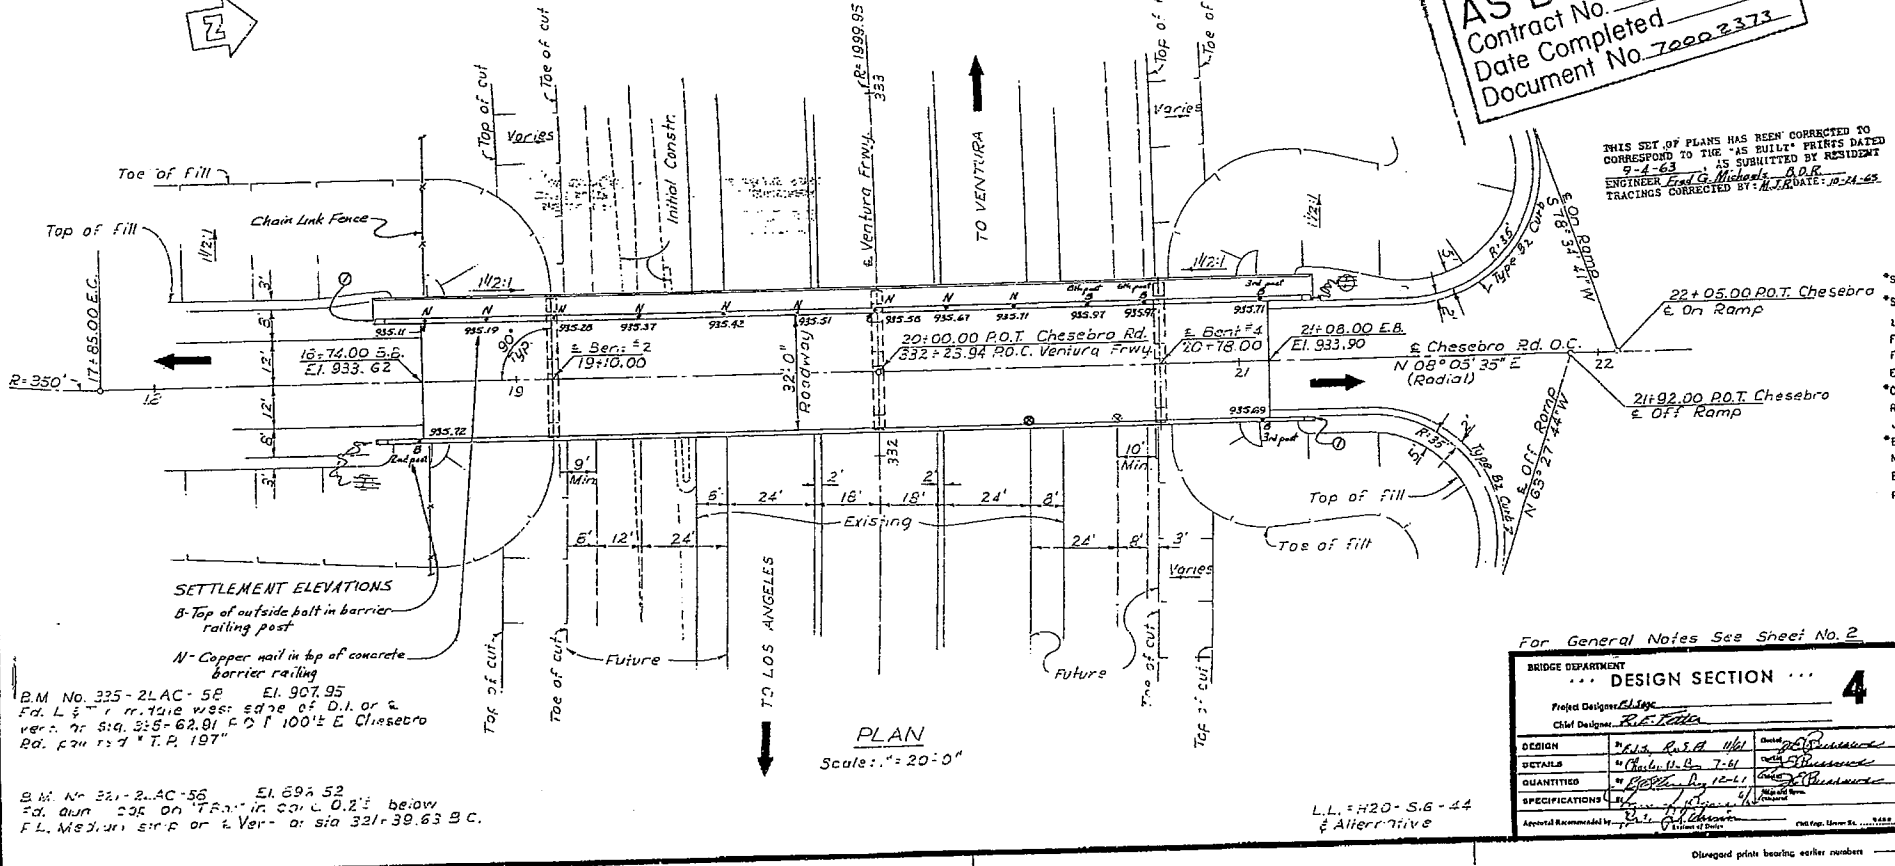

**APPROXIMATE QUANTITIES**

*STRUCTURE EXCAVATION (BRIDGE)	310 C.Y.
*STRUCTURE BACKFILL (BRIDGE)	180 C.Y.
16" C.I.D.H. CONCRETE PILING	1,210 L.F.
FURNISHING PC/PS CONCRETE GIRDERS (90'-0")	6 EA.
FURNISHING PC/PS CONCRETE GIRDERS (78'-0")	6 EA.
ERECTING PC/PS CONCRETE GIRDERS	12 EA.
*CLASS "A" CONCRETE (BRIDGE)	540 C.Y.
RUBBER WATERSTOPS	128 L.F.
JOINT SEALER	128 L.F.
*BAR REINFORCING STEEL (BRIDGE)	109,000 LBS.
MISCELLANEOUS METAL (BRIDGE)	400 LBS.
BARRIER RAILING (TYPE 1)	528 L.F.
PIPE BRIDGE RAILING (3'-6")	262 L.F.

**\*FINAL QUANTITIES**  
Contract # 63-7V13C58  
Note: Route Change (VII-LA-5)

For General Notes See Sheet No. 2

BRIDGE DEPARTMENT	DESIGN SECTION	4
Project Designer: <i>[Signature]</i>	Chief Designer: <i>[Signature]</i>	
DESIGN	<i>[Signature]</i>	<i>[Signature]</i>
DETAILS	<i>[Signature]</i>	<i>[Signature]</i>
QUANTITIES	<i>[Signature]</i>	<i>[Signature]</i>
SPECIFICATIONS	<i>[Signature]</i>	<i>[Signature]</i>

**VENTURA FREEWAY**

STATE OF CALIFORNIA  
DEPARTMENT OF PUBLIC WORKS  
DIVISION OF HIGHWAYS

**CHESEBRO ROAD OVERCROSSING**  
LOCATED ABOUT 400 FEET EAST OF THE INTERSECTION OF EXISTING CHESEBRO RD. AND VENTURA FWY IN LOS ANGELES COUNTY


**GENERAL PLAN**

SCALE AS NOTED BRIDGE 53-1878 FILE DRAWING C-531678-1

PREL. DRAWING NO. P-531678-1

I HEREBY CERTIFY THAT THIS IS A TRUE AND ACCURATE COPY OF THE ABOVE DOCUMENT TAKEN UNDER MY DIRECTION AND CONTROL ON THIS DATE IN SACRAMENTO, CALIFORNIA PURSUANT TO AUTHORIZATION BY THE DIRECTOR OF PUBLIC WORKS.

DATE 11-22 SIGNATURE *[Signature]* TITLE *[Title]*

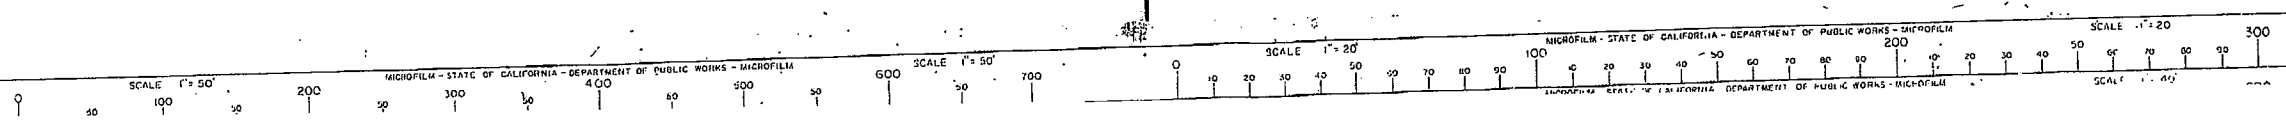


57

FED. ROAD DIST. NO.	STATE	F. PROJECT NO.	SHEET NO.	TOTAL SHEETS
7	CALIF.		63	91

VII	LA	5
-----	----	---

DATE: 12/18/52

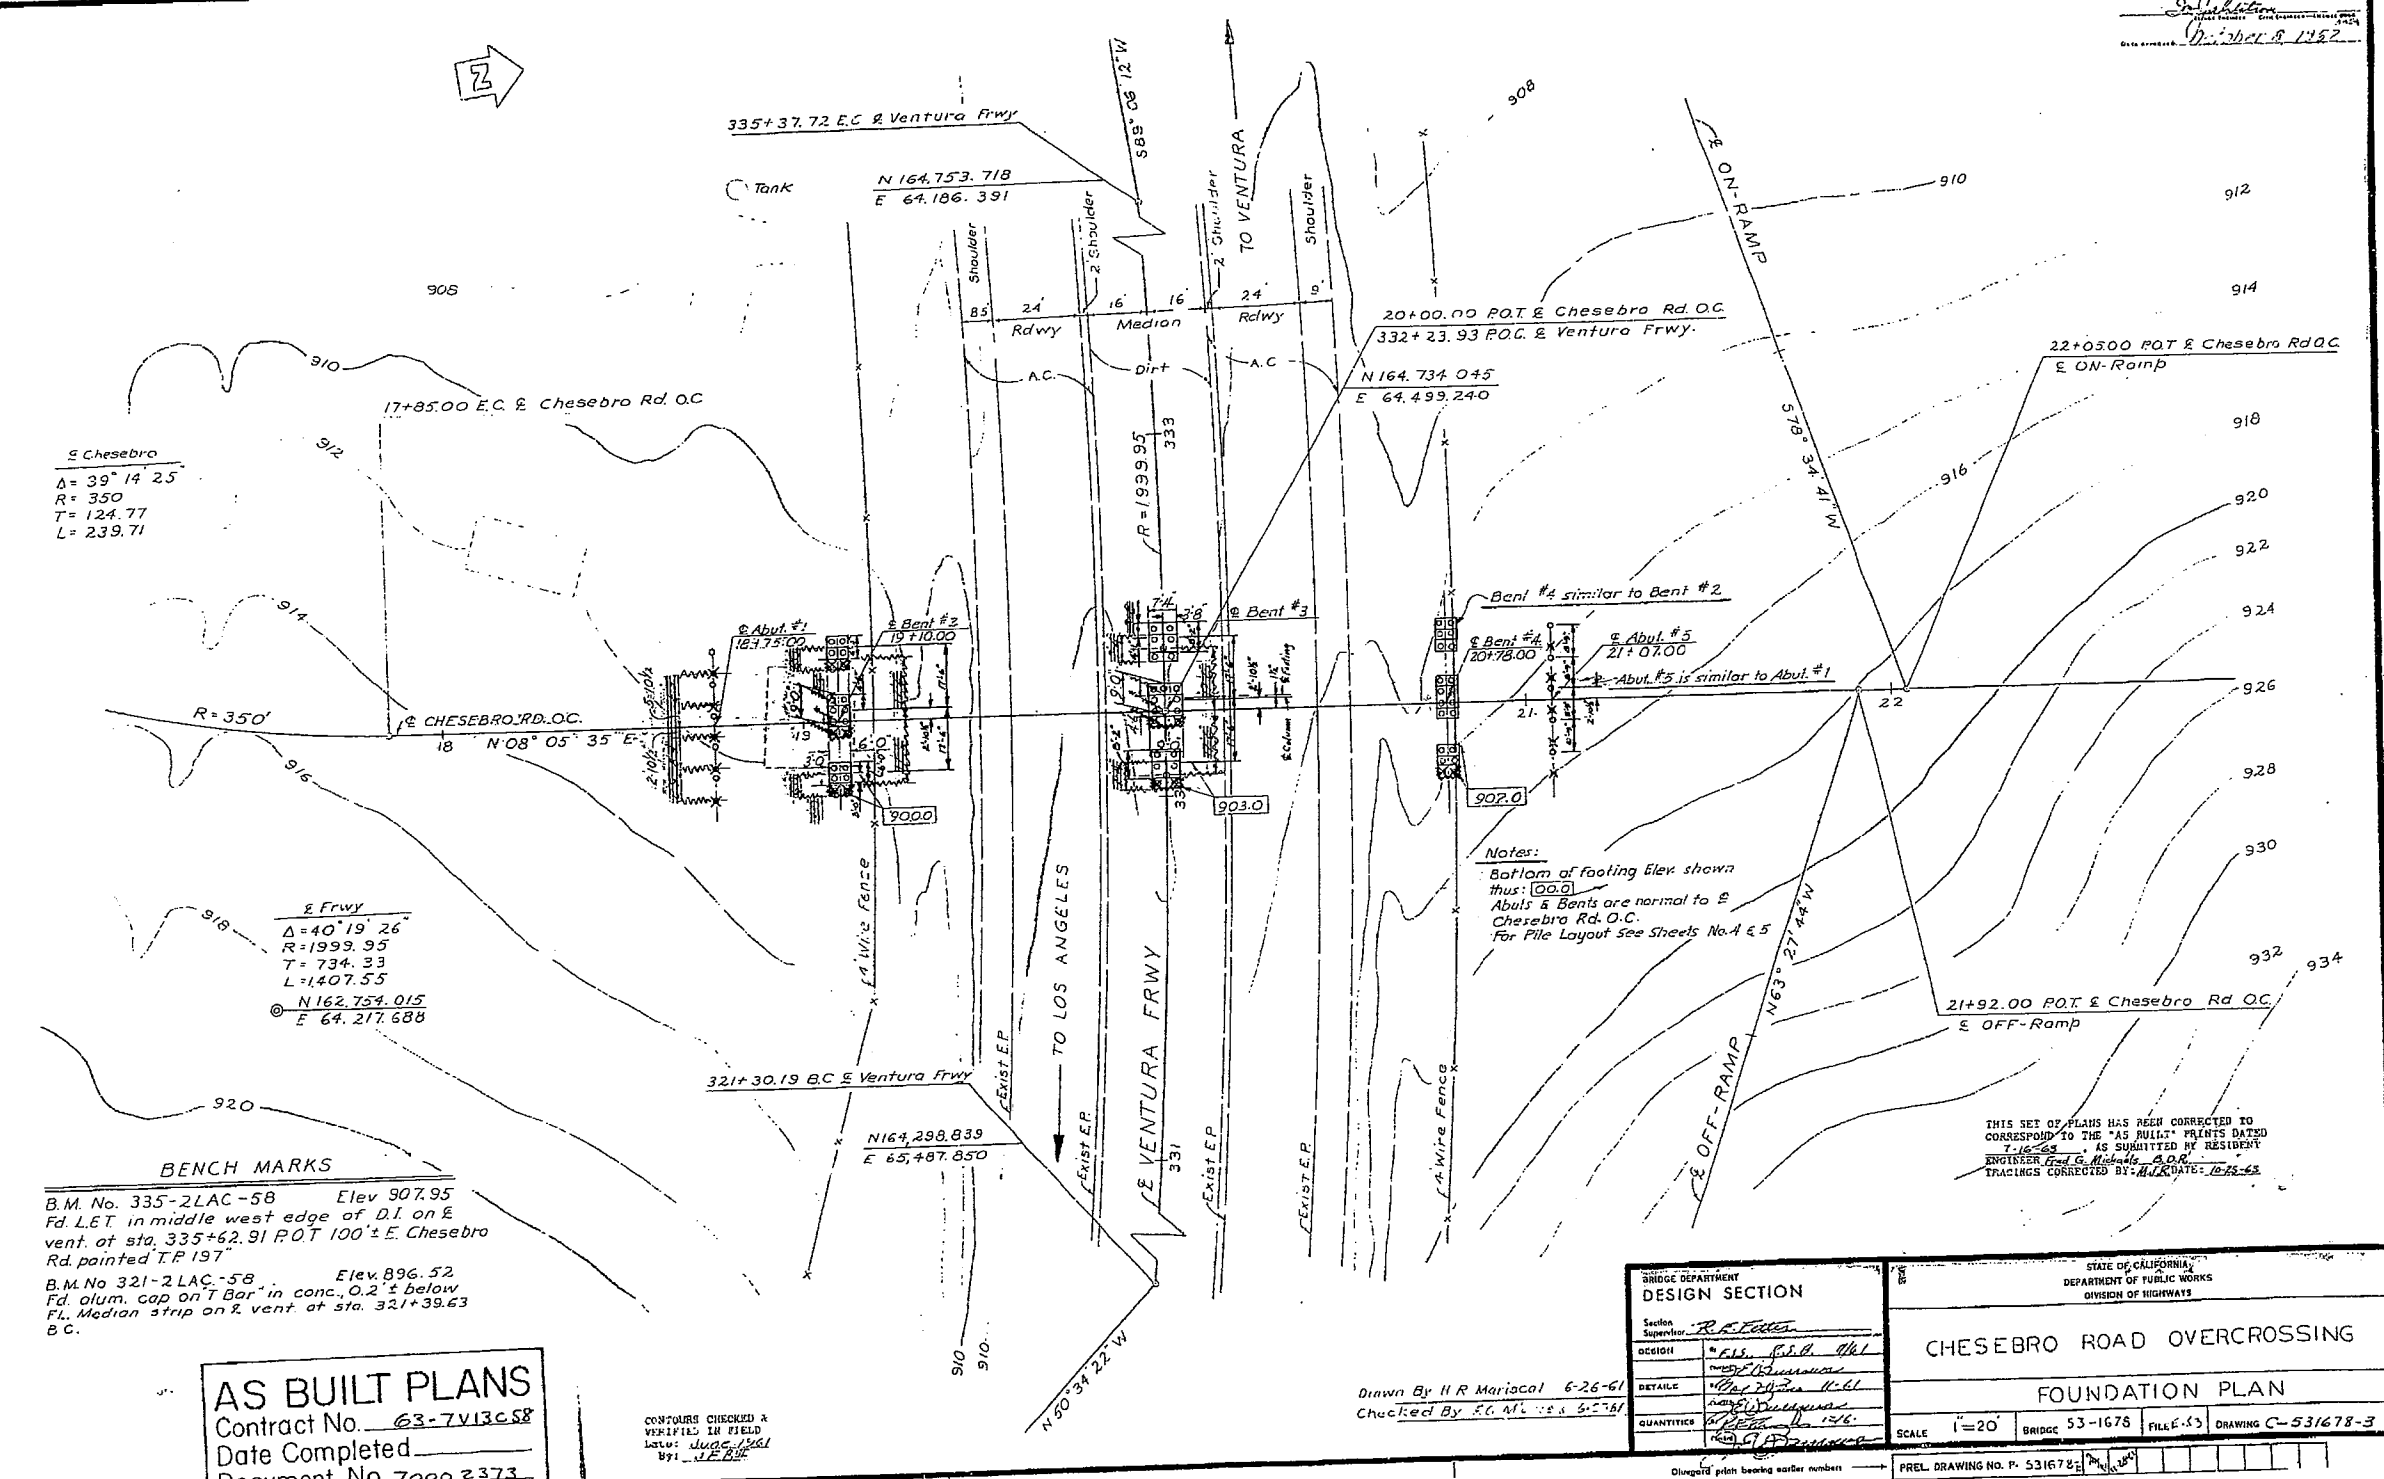

Chesebro  
 $\Delta = 39^\circ 14' 25''$   
 $R = 350$   
 $T = 124.77$   
 $L = 239.71$

E. Frwy.  
 $\Delta = 40^\circ 19' 26''$   
 $R = 1999.95$   
 $T = 734.33$   
 $L = 1407.55$   
 $N 162.754.015$   
 $E 64.217.688$

**BENCH MARKS**  
 B.M. No. 335-2 LAC-58 Elev. 907.95  
 Fd. L.E.T. in middle west edge of D.I. on E vent. of sta. 335+62.91 P.O.T. 100' ± E. Chesebro Rd. painted T.P. 197.  
 B.M. No. 321-2 LAC-58 Elev. 896.52  
 Fd. alum. cap on T Bar in conc. 0.2' ± below Fl. Median strip on E vent. of sta. 321+39.63 B.C.

**AS BUILT PLANS**  
 Contract No. 63-7V13C58  
 Date Completed \_\_\_\_\_  
 Document No. 7000 2373

CONTOURS CHECKED & VERIFIED IN FIELD  
 DATE: June 1961  
 BY: J.E.B.

**Notes:**  
 Bottom of footing Elev. shown thus: [ ]  
 Abutts & Bents are normal to Chesebro Rd. O.C.  
 For Pile Layout See Sheets No. A & S


THIS SET OF PLANS HAS BEEN CORRECTED TO CORRESPOND TO THE "AS BUILT" PRINTS DATED 7-16-63 AS SUBMITTED BY RESIDENT ENGINEER G. G. McNamee & Co. TRACKINGS CORRECTED BY: H. J. [ ] DATE: 10-15-63

BRIDGE DEPARTMENT DESIGN SECTION	
Section Supervisor	R. R. [ ]
REGION	VI, S.B. 161
DETAILS	[ ]
QUANTITIES	[ ]


STATE OF CALIFORNIA DEPARTMENT OF PUBLIC WORKS DIVISION OF HIGHWAYS			
CHESEBRO ROAD OVERCROSSING			
FOUNDATION PLAN			
SCALE	BRIDGE	FILE	DRAWING
1"=20'	53-1678	15	C-531678-3
PREL. DRAWING NO. P. 531678-3			

Drawn By H.R. Mariscal 6-26-61  
 Checked By S.G. [ ] 6-27-61

I HEREBY CERTIFY THAT THIS IS A TRUE AND ACCURATE COPY OF THE ABOVE DOCUMENT TAKEN UNDER MY DIRECTION AND CONTROL OF THIS DATE IN SACRAMENTO, CALIFORNIA PURSUANT TO AUTHORIZATION BY THE DIRECTOR OF PUBLIC WORKS.  
 DATE 11/22 SIGNATURE [ ] TITLE [ ]

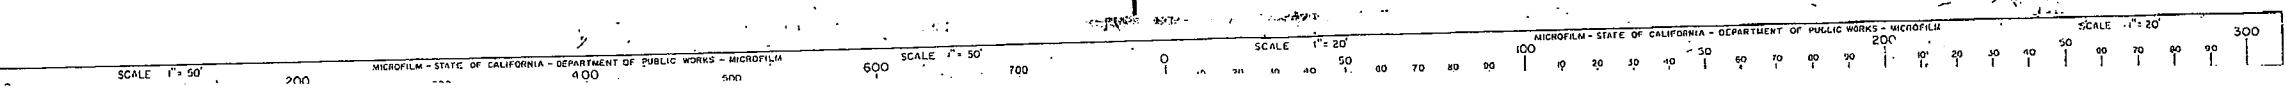

59

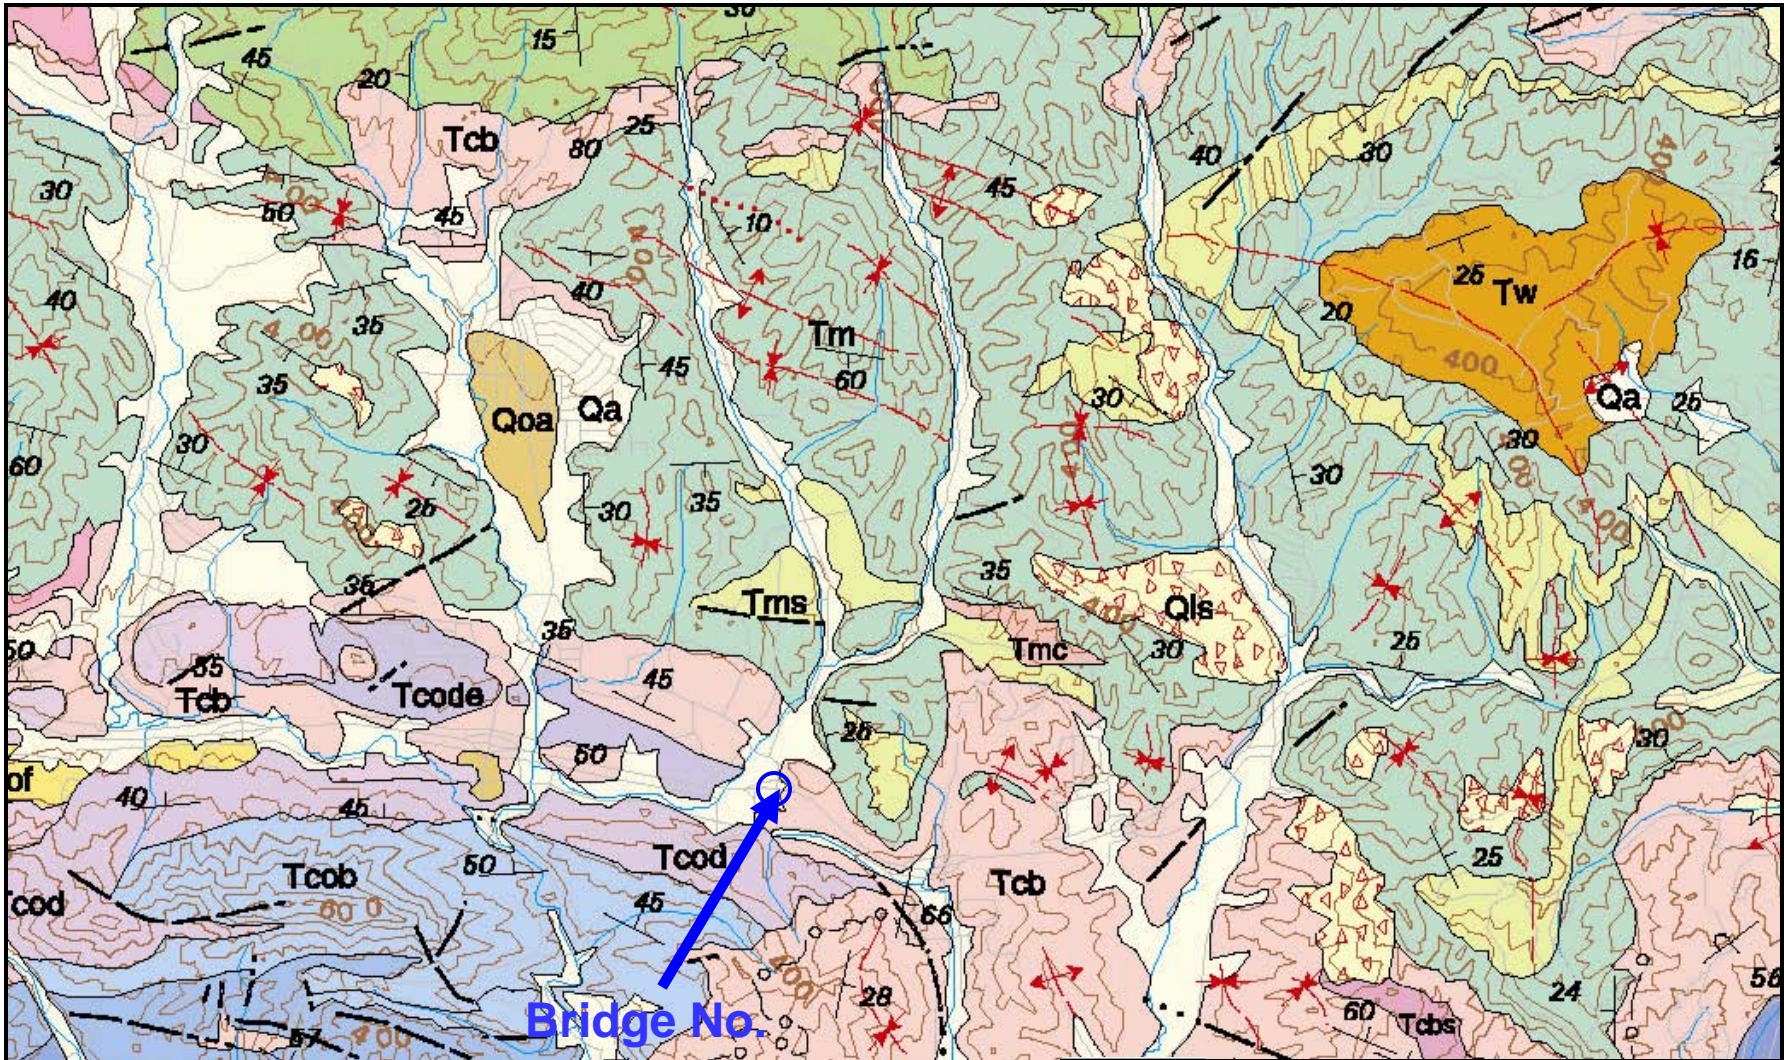

Bridge No.  
53-1678



GDC Project No. L-783

Palo Comado OC (a.k.a. Chesebro Rd. OC)  
Improvements  
Agoura Hills, CA

**GEOLOGY MAP**  
Figure 5


FED. ROAD DIST. NO.	STATE	PROJECT NO.	FISCAL YEAR	SHEET NO.	TOTAL SHEETS
7	CAL.			1	1

DIST.	COUNTY	PROJECT	SHEET NO.	TOTAL SHEETS
VII	LA	5	1	1

DATE APPROVED: 2/20/63  
 DATE: 2/20/63

**BENCH MARK #335-2LAC-58**  
 Fd 1, 47 in middle West edge of D1 on E. Ven. at Sta 335+62.91  
 P.O.T. 100' ± E. Chesebro Rd. pointed "TR 197"

ELEV. 907.95

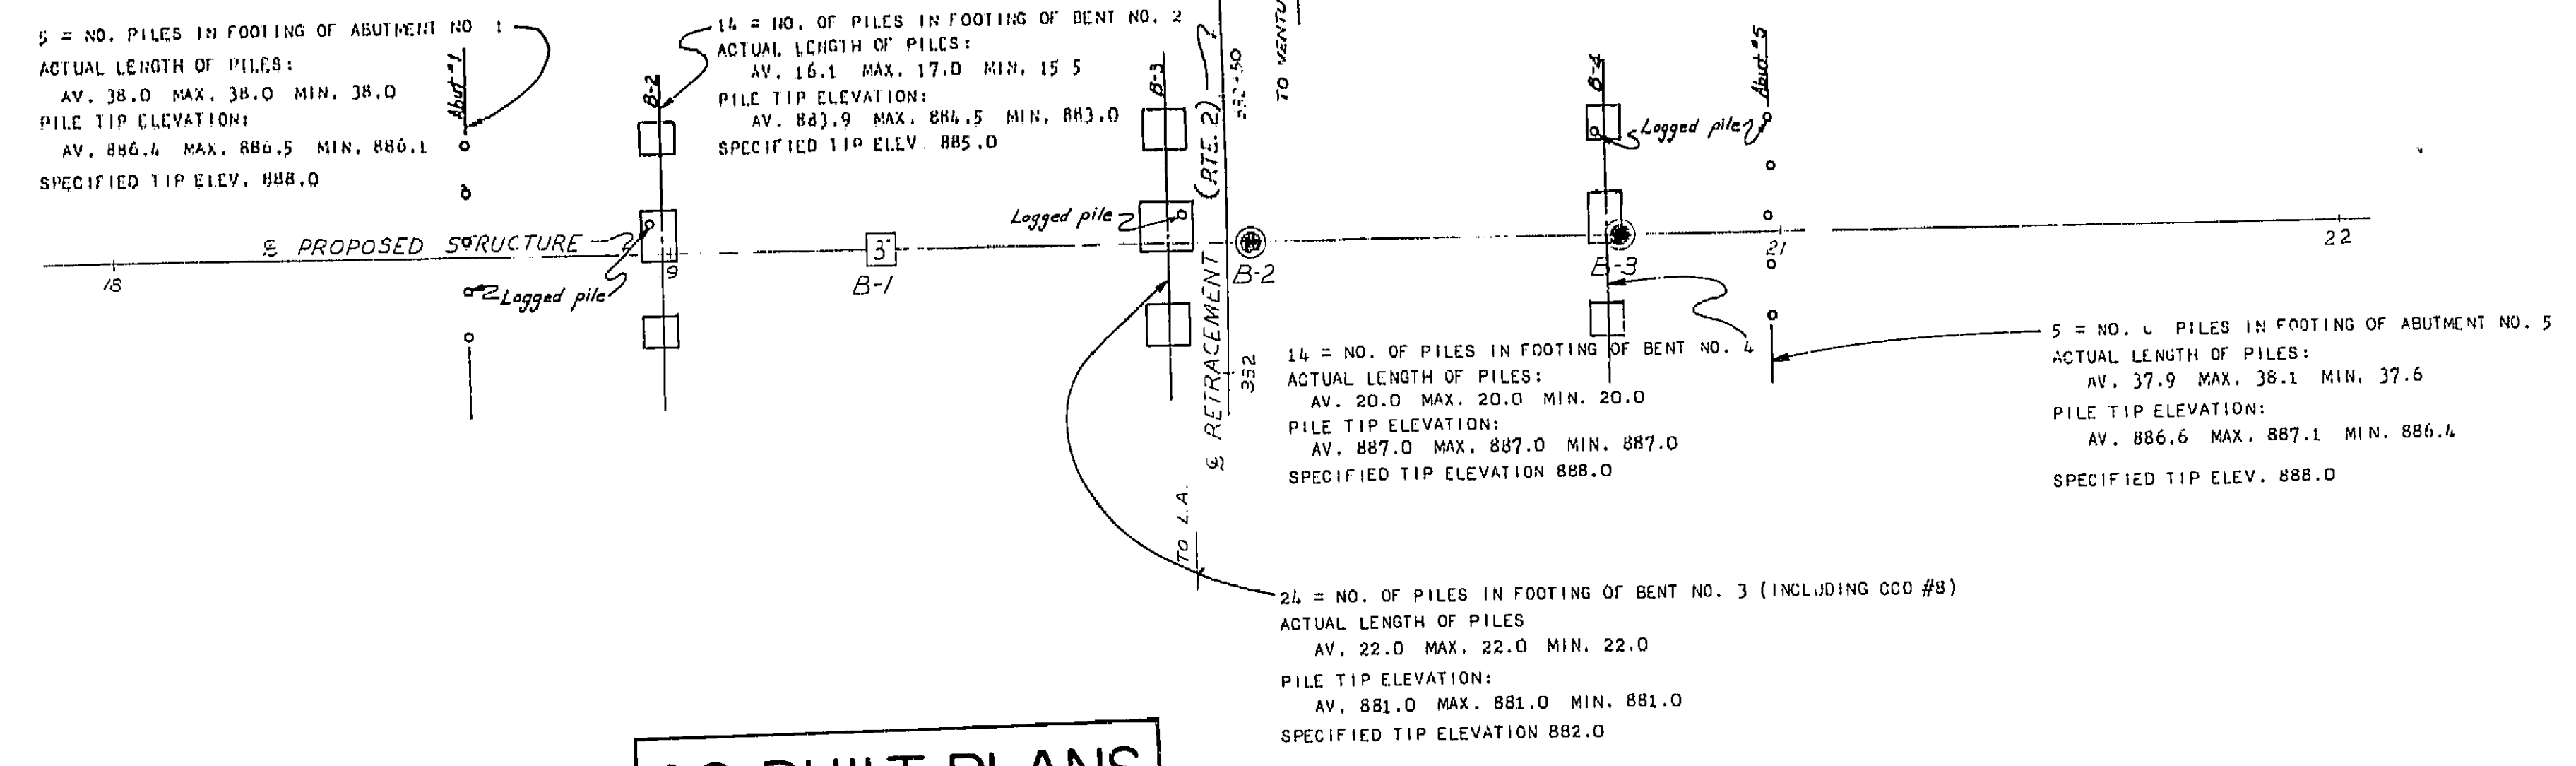

**AS BUILT PLANS**  
 Contract No. 63-7V13C58  
 Date Completed \_\_\_\_\_  
 Document No. 70002373

**PILE DATA**

TYPE OF PILE - C.I.D.H.  
 HAMMER DATA -  
 PILE DIAMETER: TIP 16" BUTT 15"  
 PILE DESIGN LOAD = 45 TONS  
 FOR THE STRUCTURE:  
 NUMBER OF PILES = 55 + 7 IN CCO #8  
 EST. LENGTH OF PILING = 1,213 L.F.  
 ACTUAL LENGTH OF PILING = 1,259.2 + 154.0 L.F. CCO #8

THIS SET OF PLANS HAS BEEN CORRECTED TO CORRESPOND TO THE "AS BUILT" PRINTS DATED 3-22-63 AS SUBMITTED BY RESIDENT ENGINEER Fred G. Michaels, B.O.R. TRACINGS CORRECTED BY: M.J.R. DATE: 10-29-63

NO GROUND WATER ENCOUNTERED DURING THIS INVESTIGATION BY BRIDGE DEPT. GEOLOGY SECTION DATE: June 1961



**NOTES**

The contractor's attention is directed to Section 2, Article (c) of the Standard Specifications and to the Special Provisions accompanying this set of plans. Classification of earth material as shown on this sheet is based upon field inspection and is not to be construed to imply mechanical analysis.

STATE OF CALIFORNIA  
 DEPARTMENT OF PUBLIC WORKS  
 DIVISION OF HIGHWAYS


**CHESEBRO RD. OVERCROSSING**  
**LOG OF TEST BORINGS**

Scale: Horiz 1"=20', Vert 1"=10'  
 BRIDGE 53-1678 FILE DRAWING C-531678-15  
 P.E.L. DRAWING P-531678-15

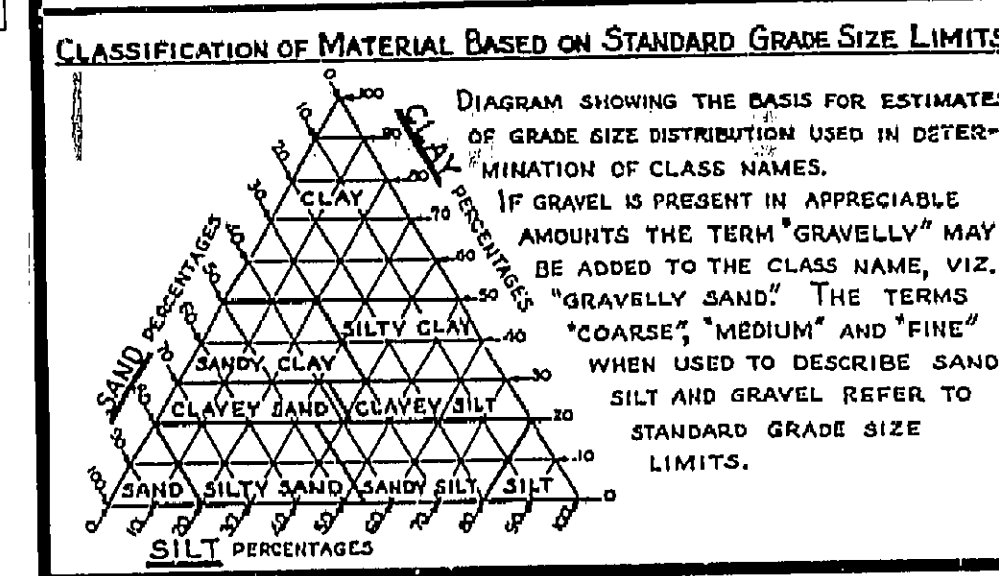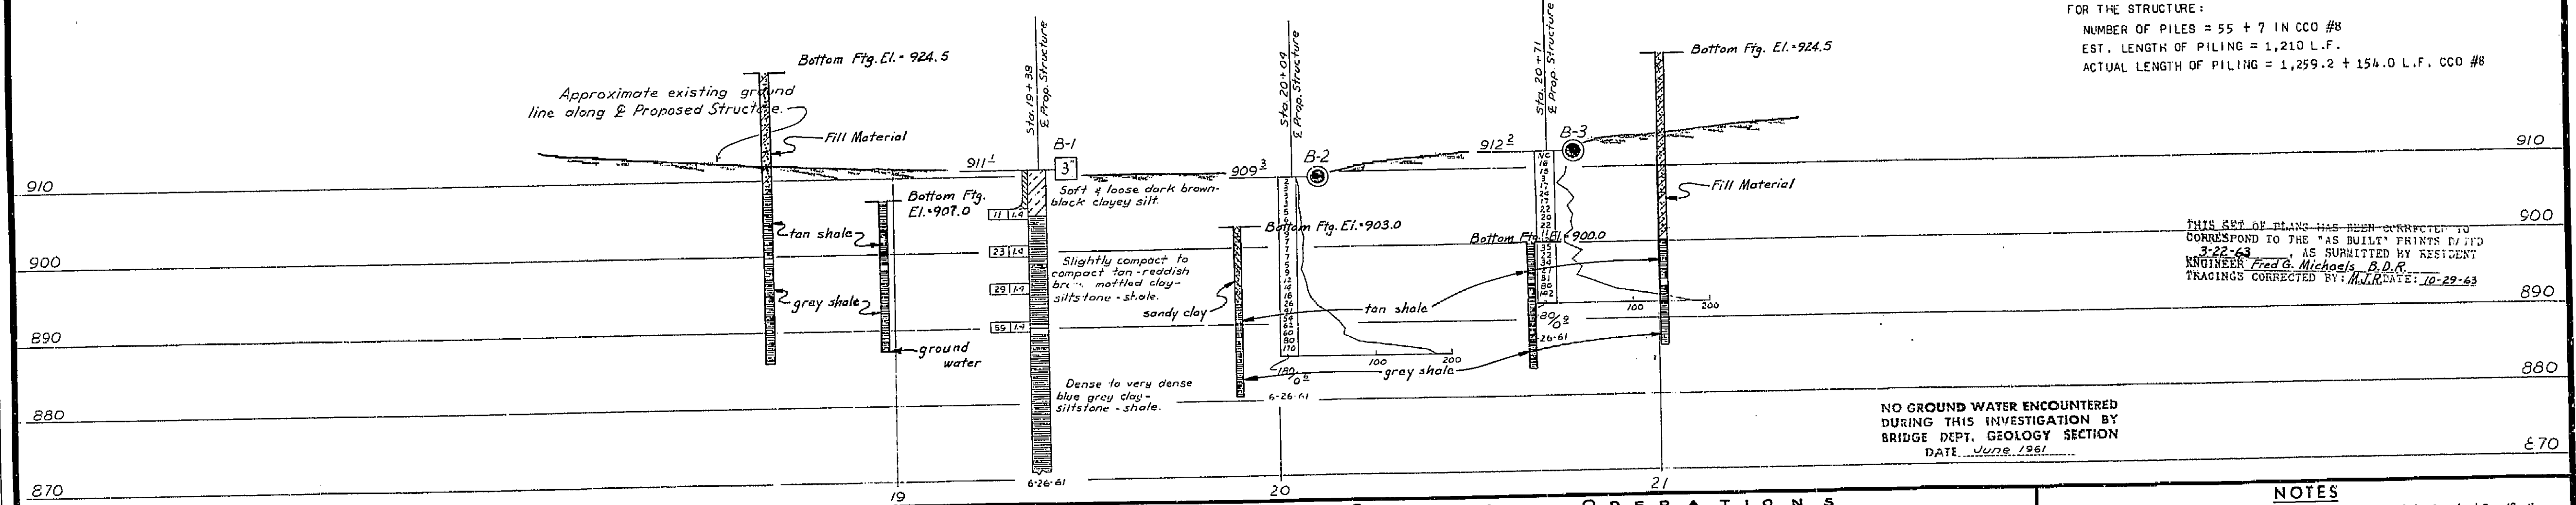


**LEGEND OF EARTH MATERIALS**


GRAVEL	SILTY CLAY OR CLAYEY SILT
SAND	PEAT AND/OR ORGANIC MATTER
SILT	FILL MATERIAL
CLAY	IGNEOUS ROCK
SANDY CLAY OR CLAYEY SAND	SEDIMENTARY ROCK
SANDY SILT OR SILTY SAND	METAMORPHIC ROCK

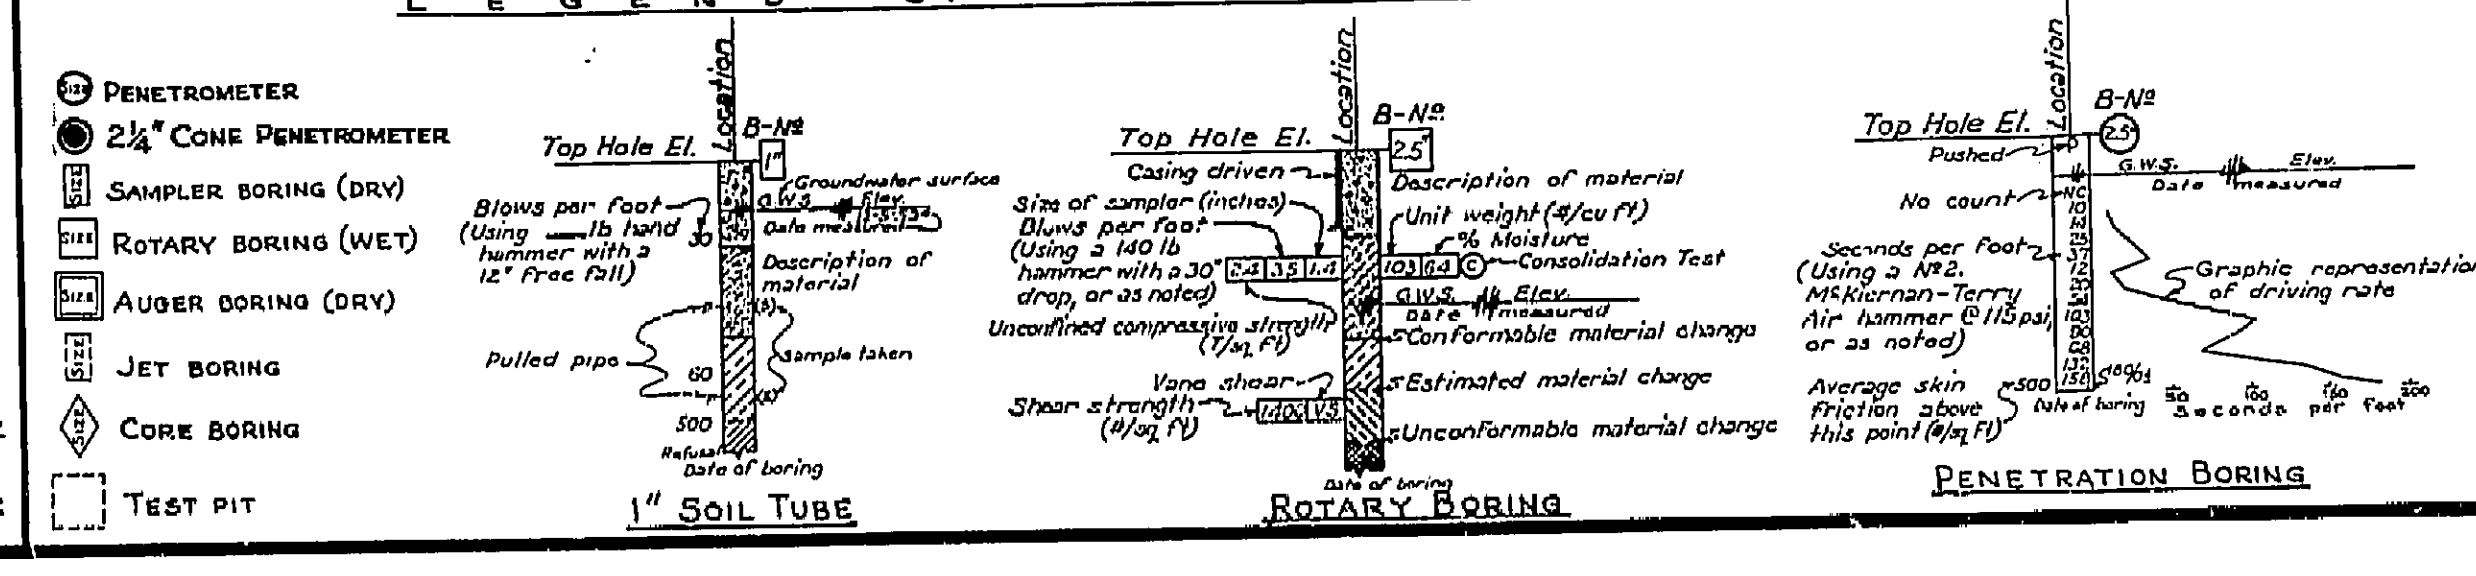

I HEREBY CERTIFY THAT THIS IS A TRUE AND ACCURATE COPY OF THE ABOVE DOCUMENT TAKEN UNDER MY DIRECTION AND CONTROL ON THIS DATE IN SACRAMENTO, CALIFORNIA PURSUANT TO AUTHORIZATION BY THE DIRECTOR OF PUBLIC WORKS.  
 DATE \_\_\_\_\_ SIGNATURE \_\_\_\_\_ TITLE \_\_\_\_\_

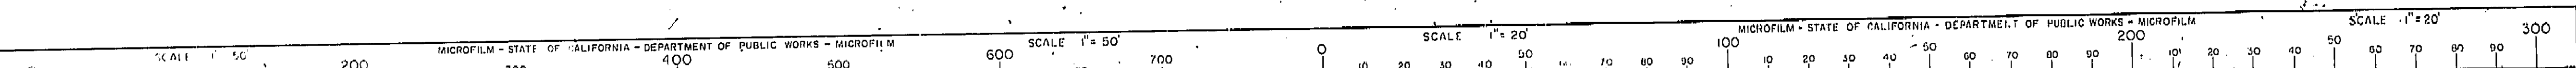



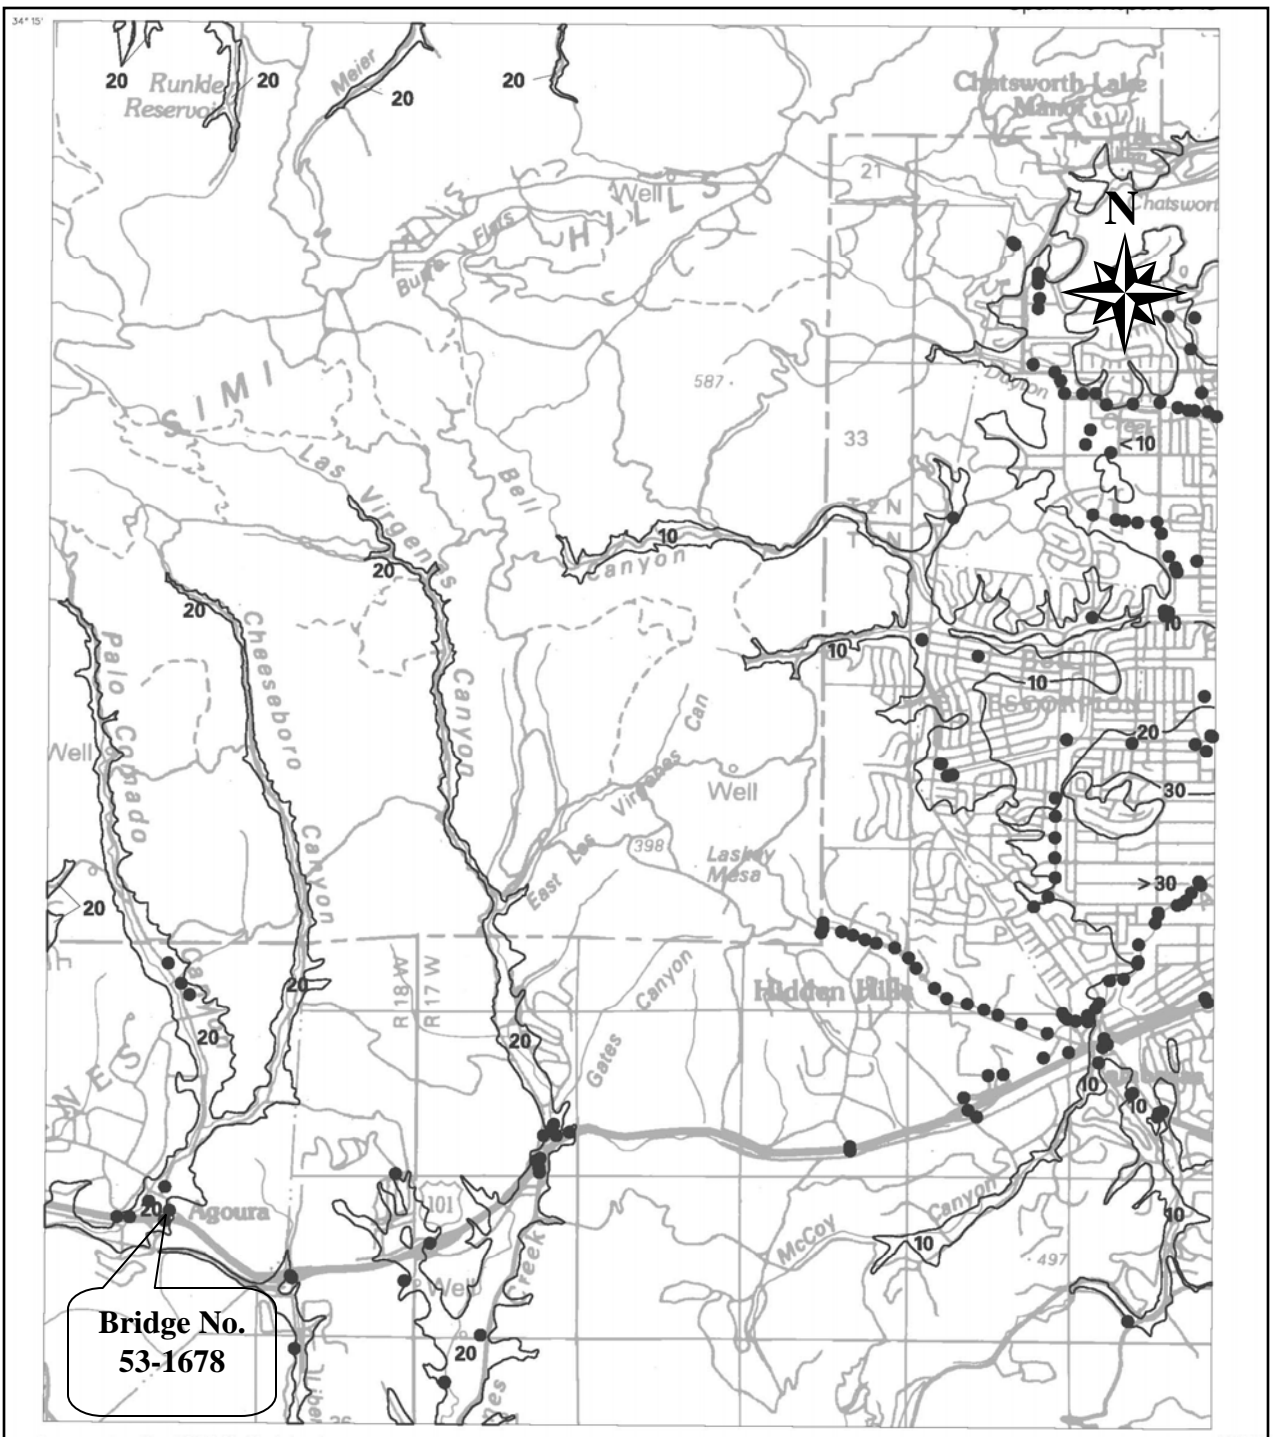

Base map enlarged from U.S.G.S. 30 x 60-minute series

34° 07' 30"

118° 37' 30"

Plate 1.2 Depth to historically high ground water, and locations of boreholes used in this study, Calabasas 7.5-minute Quadrangle, California

● Borehole Site

— 30 — Depth to ground water in feet


ONE MILE  
SCALE

NOTE: GRAPHIC SCALE AS SHOWN




**Palo Comado OC**  
**a.k.a. Chesebro Road OC (Widen)**  
**Agoura Hills, CA**  
**GDC PROJECT NO. L-783**

**FIGURE 7**  
**HISTORICALLY**  
**HIGHEST**  
**GROUNDWATER MAP**

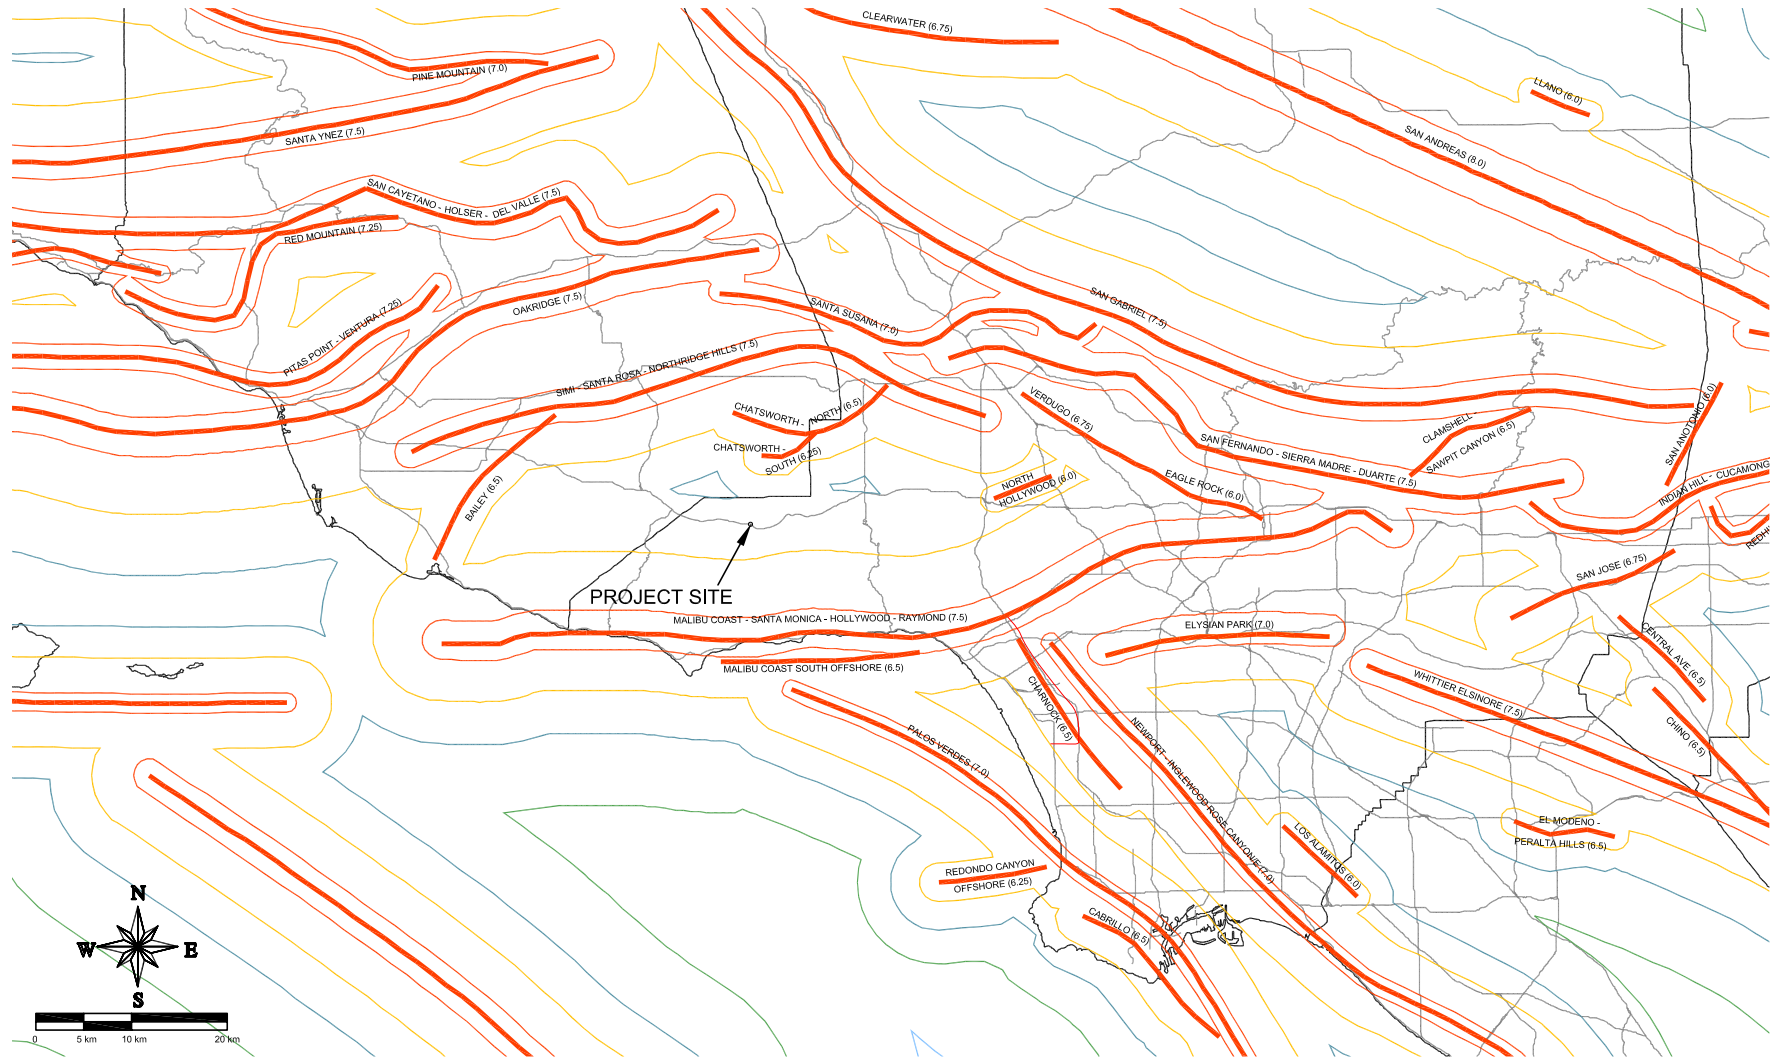

PROJECT SITE

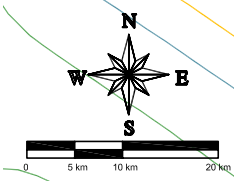

- LEGEND
- 0.7g Peak Acceleration Contour
  - 0.6g Peak Acceleration Contour
  - 0.5g Peak Acceleration Contour
  - 0.4g Peak Acceleration Contour
  - 0.3g Peak Acceleration Contour
  - 0.2g Peak Acceleration Contour
  - 0.1g Peak Acceleration Contour

REF. : MUALCHIN, L. 1996, "CALIFORNIA SEISMIC HAZARD MAP 1996" CALIFORNIA DEPARTMENT OF TRANSPORTATION



GDC PROJECT NO. L783  
 Palo Comado OC  
 a.k.a. Cheseboro Road OC  
 Improvements  
**Caltrans Fault and PBA Map**  
 Figure 8


118°43'

DIVISION OF MINES AND GEOLOGY  
JAMES F. DAVIS, STATE GEOLOGIST

STATE OF CALIFORNIA-PETE WILSON, GOVERNOR  
THE RESOURCE AGENCY-DOUGLAS P. WHEELER, SECRETARY  
DEPARTMENT OF CONSERVATION-LAWRENCE J. GOLDBAND, DIRECTOR

SEISMIC HAZARDS ZONES MAP  
Calabasas Quadrangle

118°37'00"

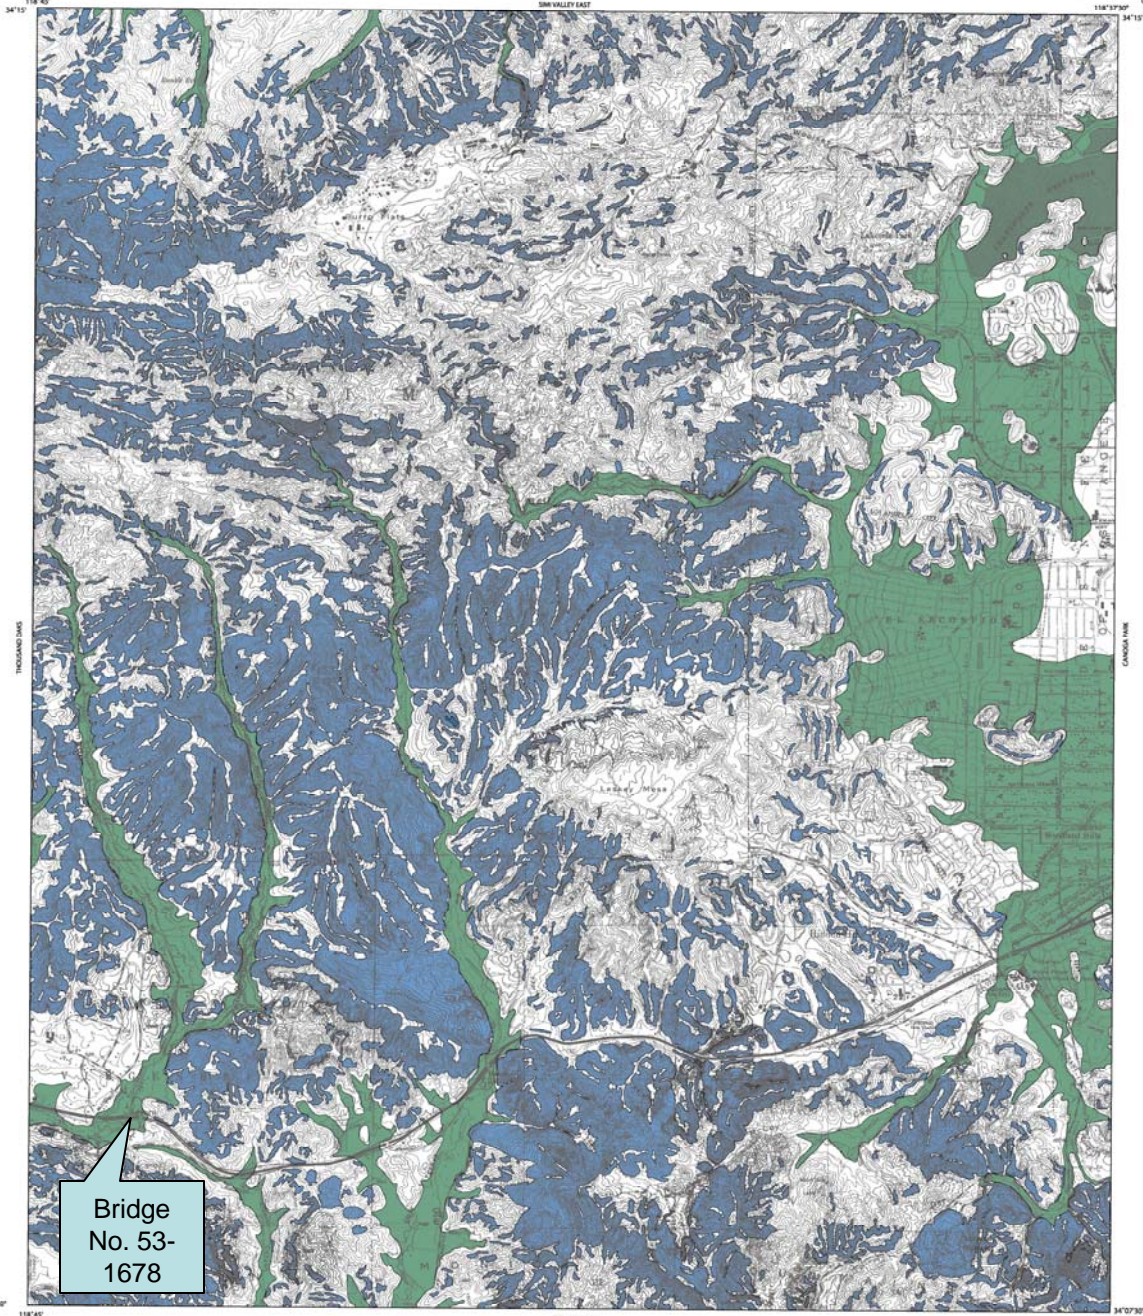

34°10'30"

Base Map prepared by U.S. Geological Survey, 1952, photorevised 1967

SCALE 1:24,000



**PURPOSE OF MAP**

This map will assist cities and counties in fulfilling their responsibilities for protecting the public safety from the effects of earthquake triggered ground failure as required by the Seismic Hazard Mapping Act Public Resources Code Sections 26950-26956.

For information regarding the scope and recommended methods to be used in conducting the required site investigations, see DMG Special Publication 115, Guidelines for Evaluating and Mitigating Seismic Hazards in California.

For a general description of the Seismic Hazard Mapping Program, the Seismic Hazard Mapping Act and regulations, and related information, please refer to the draft User's Guide (see <http://www.cons.ca.gov/dmg/shepp/usersguide.html>).

Production of this map was funded by the Federal Emergency Management Agency's Hazard Mitigation Program and the Department of Conservation in cooperation with the Governor's Office of Emergency Services.

**IMPORTANT - PLEASE NOTE**

1) This map may not show all areas that have the potential for liquefaction, landsliding, strong earthquake ground shaking or other earthquake and geologic hazards. Also, a single earthquake capable of causing liquefaction or triggering landslide failure will not uniformly affect the entire area shown.

2) Liquefaction zones may also contain areas susceptible to the effects of earthquake-induced landslides. This situation typically exists at or near the toe of existing landslides, downslope from scolded or debris flow source areas, or adjacent to steep stream banks.

3) This map does not show Alquist-Priolo earthquake fault zones, if any, that may exist in this area. Please refer to the latest official map of earthquake fault zones for disclosures and other actions that are required by the Alquist-Priolo Earthquake Fault Zoning Act. For more information on this subject and index to available maps, see DMG Special Publication 42.

4) Landslide zones on this map were determined, in part, by adapting methods first developed by the U.S. Geological Survey (USGS). A new generation of landslide hazard maps being prepared by the USGS (Lisboa and Harp, in preparation) uses an experimental approach designed to explore new methods to assess earthquake-induced landslide hazards. Although aspects of this new methodology may be incorporated in future seismic hazard zone maps, the experimental USGS maps should not be used as substitutes for these official earthquake-induced landslide zone maps.

5) U.S. Geological Survey base map standards provide that 90 percent of cultural features be located within 40 feet (horizontal accuracy) at the scale of this map. The identification and location of liquefaction and earthquake-induced landslide zones are based on available data. However, the quality of data used is varied. The zone boundaries depicted have been drawn as accurately as possible at this scale.

6) Information on this map is not sufficient to serve as a substitute for the geologic and geotechnical site investigations required under Chapters 7.5 and 7.6 of Division 2 of the Public Resources Code.

7) **DISCLAIMER:** The State of California and the Department of Conservation make no representation or warranty regarding the accuracy of the data from which these maps were derived, neither the State nor the Department shall be liable under any circumstances for any direct, indirect, special, incidental or consequential damages with respect to any claim by any user or any third party on account of or arising from the use of this map.

**STATE OF CALIFORNIA  
SEISMIC HAZARD ZONES**

Delineated in compliance with  
Chapter 7.6, Division 2 of the California Public Resources Code  
(Seismic Hazard Mapping Act)



**CALABASAS QUADRANGLE**

**OFFICIAL MAP**  
Released: February 1, 1998

*James F. Davis*  
STATE GEOLOGIST

**MAP EXPLANATION**

**Zones of Required Investigation:**

-  **Liquefaction**  
Areas where historic occurrence of liquefaction, or local geotechnical and groundwater conditions indicate a potential for permanent ground displacements such that mitigation as defined in Public Resources Code Section 26953(c) would be required.
-  **Earthquake-Induced Landslides**  
Areas where previous occurrence of landslide movement, or local topographic, geological, geotechnical and subsurface water conditions indicate a potential for permanent ground displacements such that mitigation as defined in Public Resources Code Section 26953(c) would be required.

**DATA AND METHODOLOGY USED TO DEVELOP THIS MAP ARE PRESENTED IN THE FOLLOWING:**

Seismic Hazard Evaluation of the Calabasas 7.5-minute quadrangle, Los Angeles and Ventura Counties, California, California Department of Conservation Division of Mines and Geology Open File Report 97-13.

For additional information on seismic hazards in this map area, the rationale used for zoning, and additional references consulted, refer to DMG's World Wide Web site (<http://www.cons.ca.gov/dmg/>).

Copyright © 1998 by the California Department of Conservation, Division of Mines and Geology. All rights reserved.

Figure 8



*APPENDIX A*  
*AS-BUILT PLANS (ORIGINAL CONSTRUCTION)*

---


FED. ROAD DIST. NO.	STATE	PROJECT NO.	FISCAL YEAR	SHEET NO.	TOTAL SHEETS
7	CAL.			1	1

DIST.	COUNTY	PROJECT	SHEET NO.	TOTAL SHEETS
VII	LA	5	1	1

DATE APPROVED: 2/20/63

**BENCH MARK #335-2LAC-58**  
 Fd 1, 47 in middle West edge of D1 on E. Ven. at Sta 335+62.91  
 P.O.T. 100' ± E. Chesebro Rd. pointed "TR 197"

ELEV. 907.95

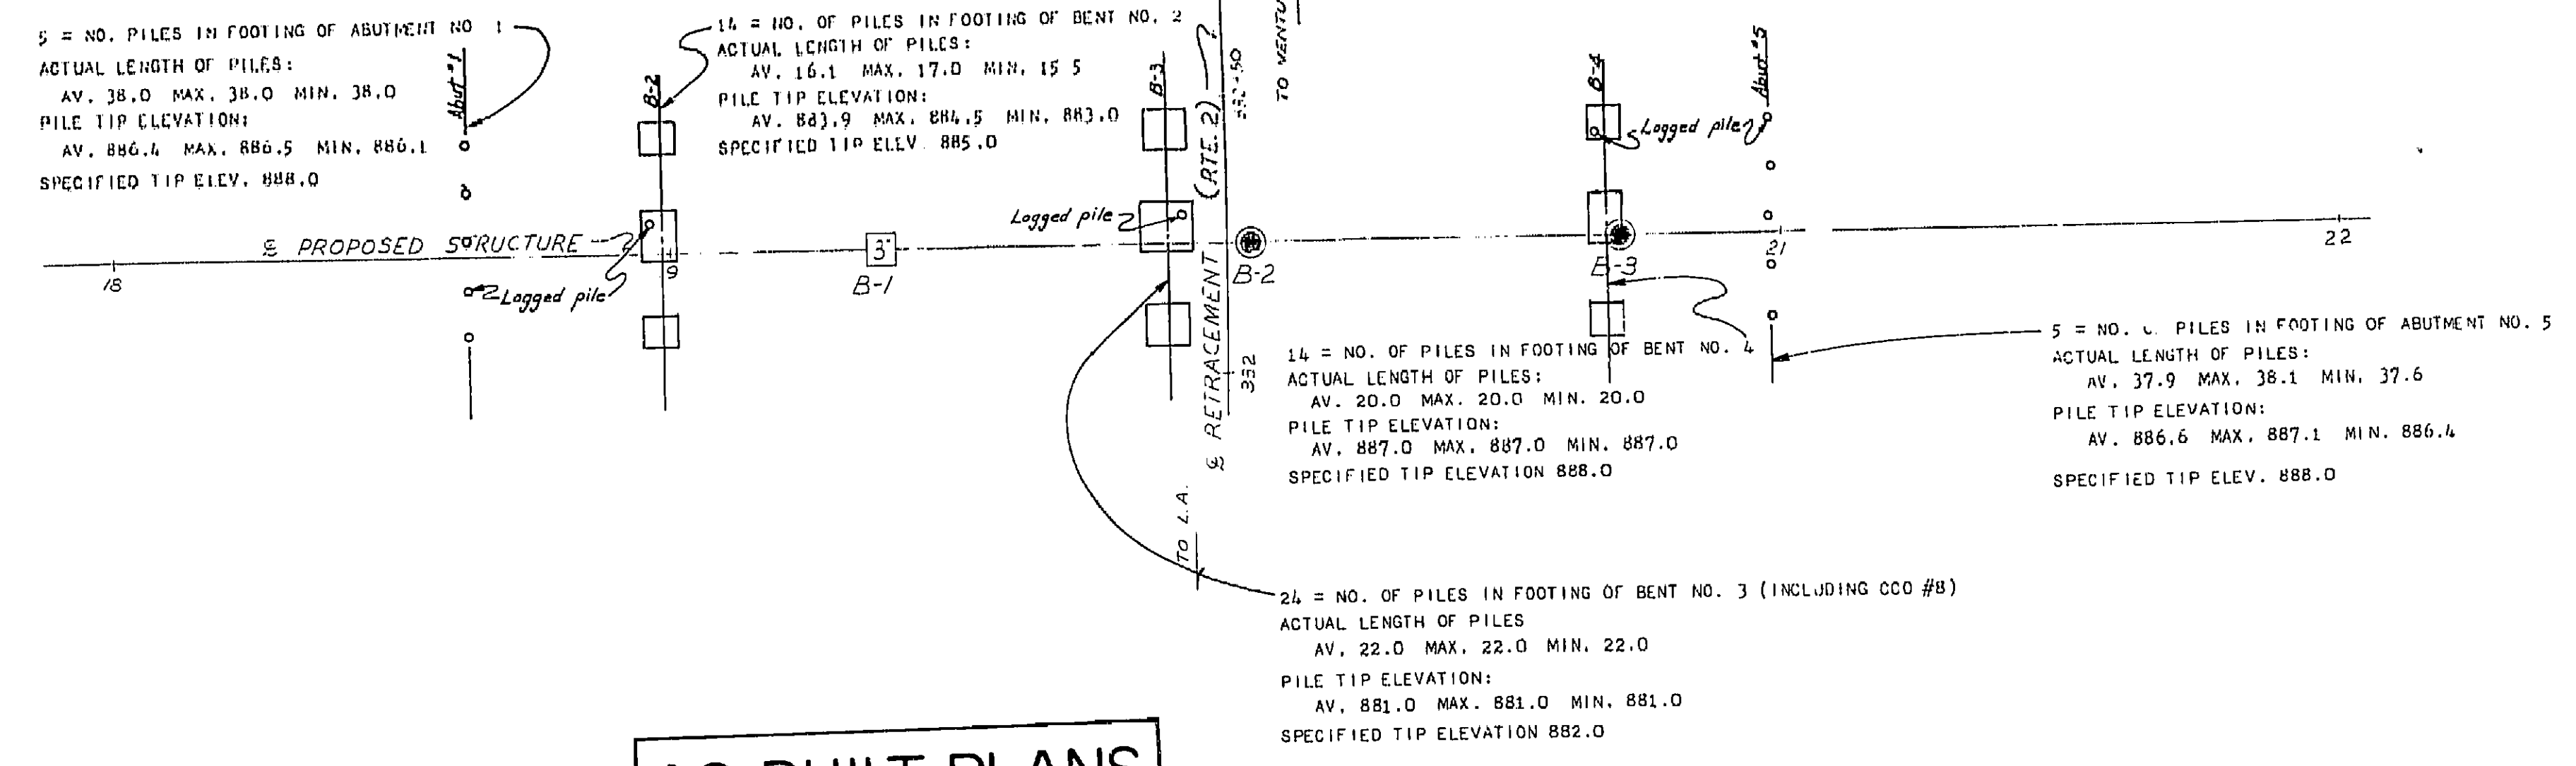

**AS BUILT PLANS**  
 Contract No. 63-7V13C58  
 Date Completed \_\_\_\_\_  
 Document No. 70002373

**PILE DATA**

TYPE OF PILE - C.I.D.H.  
 HAMMER DATA -  
 PILE DIAMETER: TIP 16" BUTT 15"  
 PILE DESIGN LOAD = 45 TONS  
 FOR THE STRUCTURE:  
 NUMBER OF PILES = 55 + 7 IN CCO #8  
 EST. LENGTH OF PILING = 1,213 L.F.  
 ACTUAL LENGTH OF PILING = 1,259.2 + 154.0 L.F. CCO #8

THIS SET OF PLANS HAS BEEN CORRECTED TO CORRESPOND TO THE "AS BUILT" PRINTS DATED 3-22-63 AS SUBMITTED BY RESIDENT ENGINEER Fred G. Michaels, B.O.E. TRACINGS CORRECTED BY: M.J.R. DATE: 10-29-63

NO GROUND WATER ENCOUNTERED DURING THIS INVESTIGATION BY BRIDGE DEPT. GEOLOGY SECTION DATE: June 1961



**NOTES**

The contractor's attention is directed to Section 2, Article (c) of the Standard Specifications and to the Special Provisions accompanying this set of plans. Classification of earth material as shown on this sheet is based upon field inspection and is not to be construed to imply mechanical analysis.

STATE OF CALIFORNIA  
 DEPARTMENT OF PUBLIC WORKS  
 DIVISION OF HIGHWAYS

**CHESEBRO RD. OVERCROSSING**  
**LOG OF TEST BORINGS**

Scale: Horiz 1"=20', Vert 1"=10'  
 BRIDGE 53-1678 FILE DRAWING C-531678-15  
 P.E.L. DRAWING P-531678-15

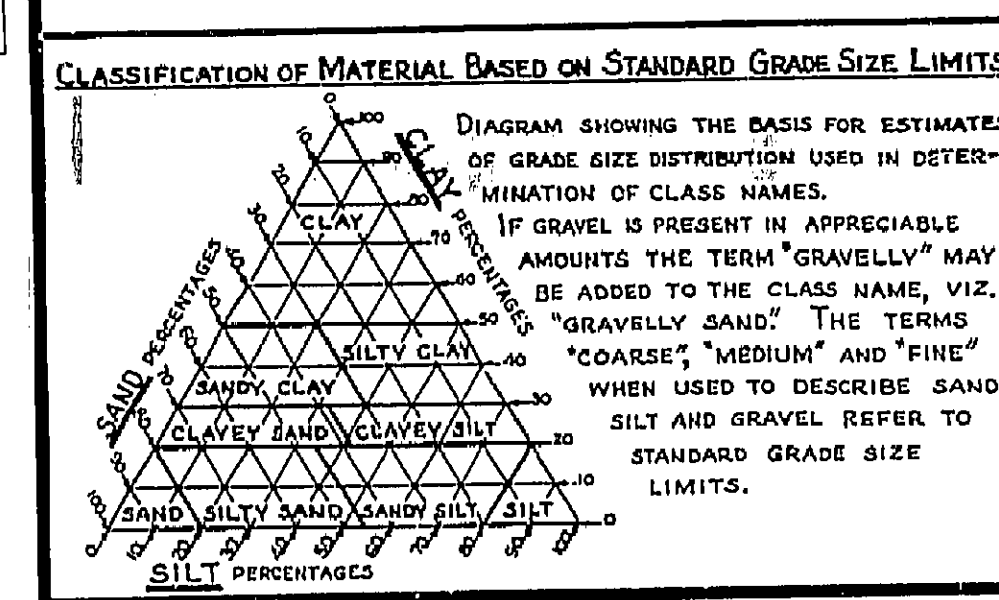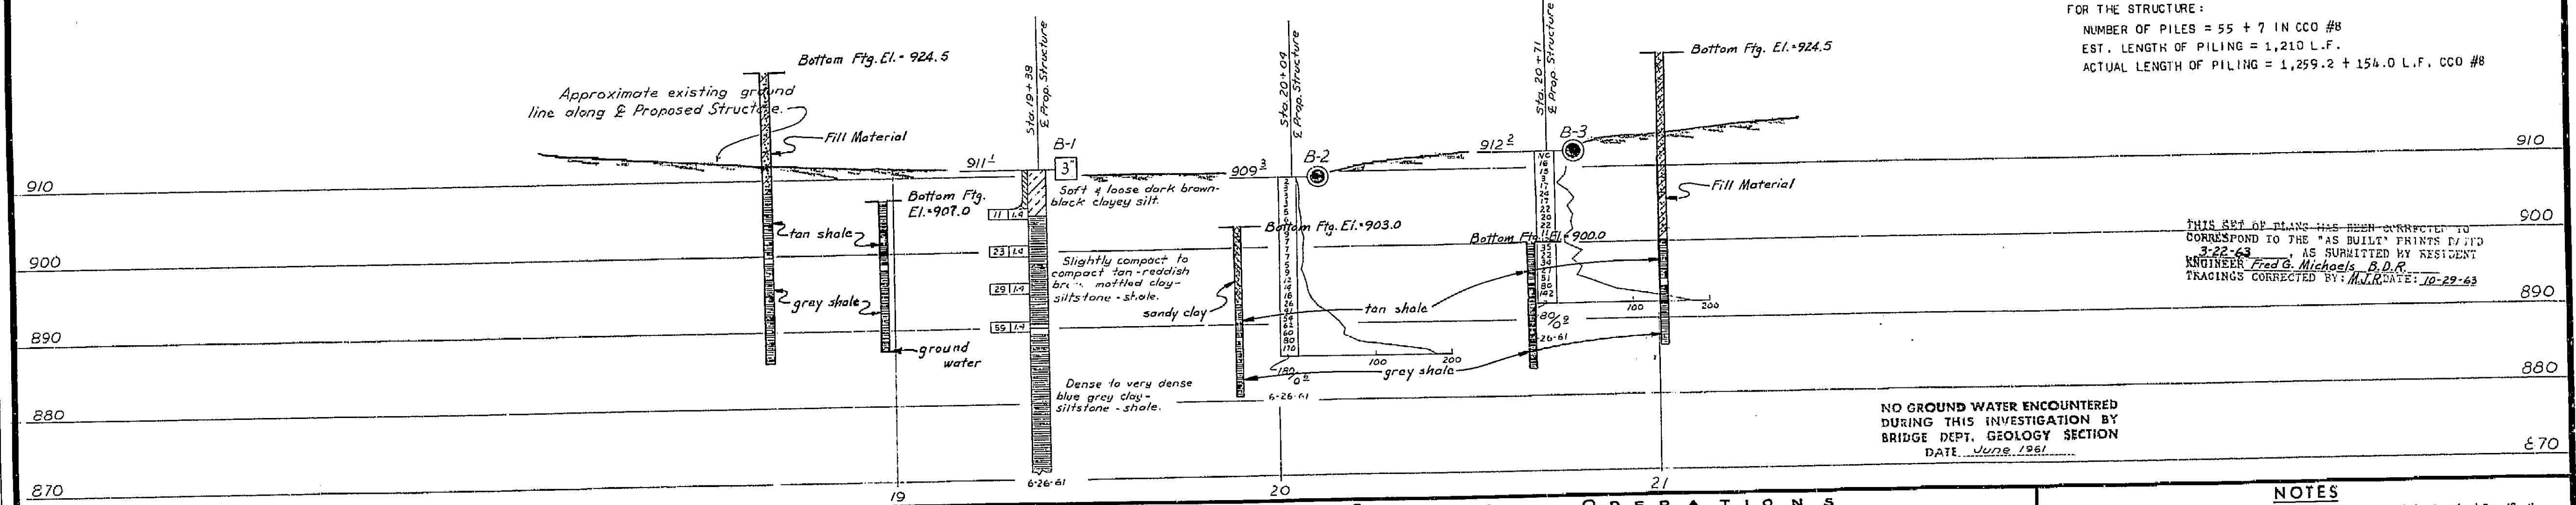


**LEGEND OF EARTH MATERIALS**

GRAVEL	SILTY CLAY OR CLAYEY SILT
SAND	PEAT AND/OR ORGANIC MATTER
SILT	FILL MATERIAL
CLAY	IGNEOUS ROCK
SANDY CLAY OR CLAYEY SAND	SEDIMENTARY ROCK
SANDY SILT OR SILTY SAND	METAMORPHIC ROCK

**LEGEND OF BORING OPERATIONS**

PENETROMETER	2 1/4" CONE PENETROMETER
SAMPLER BORING (DRY)	ROTARY BORING (WET)
AUGER BORING (DRY)	JET BORING
CORE BORING	TEST PIT


I HEREBY CERTIFY THAT THIS IS A TRUE AND ACCURATE COPY OF THE ABOVE DOCUMENT TAKEN UNDER MY DIRECTION AND CONTROL ON THIS DATE IN SACRAMENTO, CALIFORNIA PURSUANT TO AUTHORIZATION BY THE DIRECTOR OF PUBLIC WORKS.  
 DATE \_\_\_\_\_ SIGNATURE \_\_\_\_\_ TITLE \_\_\_\_\_

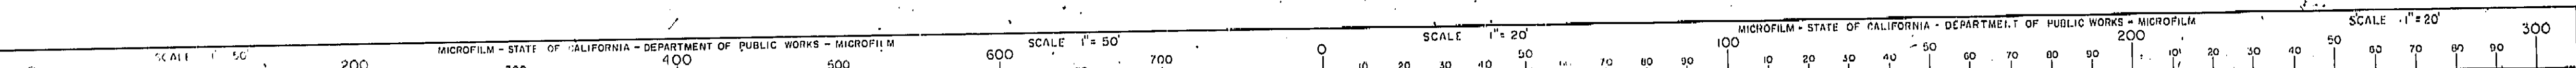

FED. ROAD DIST. NO.	STATE	PROJ. NO.	SHEET NO.	TOTAL SHEETS
7	CALIF.		57	151

DIST.	COUNTY	ROUTE	SECTION	SHEET NO.	TOTAL SHEETS
VII	LA	5		57	151


101  
 J. M. Maloney  
 CIVIL ENGINEER  
 DATE: 10/22/63  
 PROJECT: 63-7V13C58

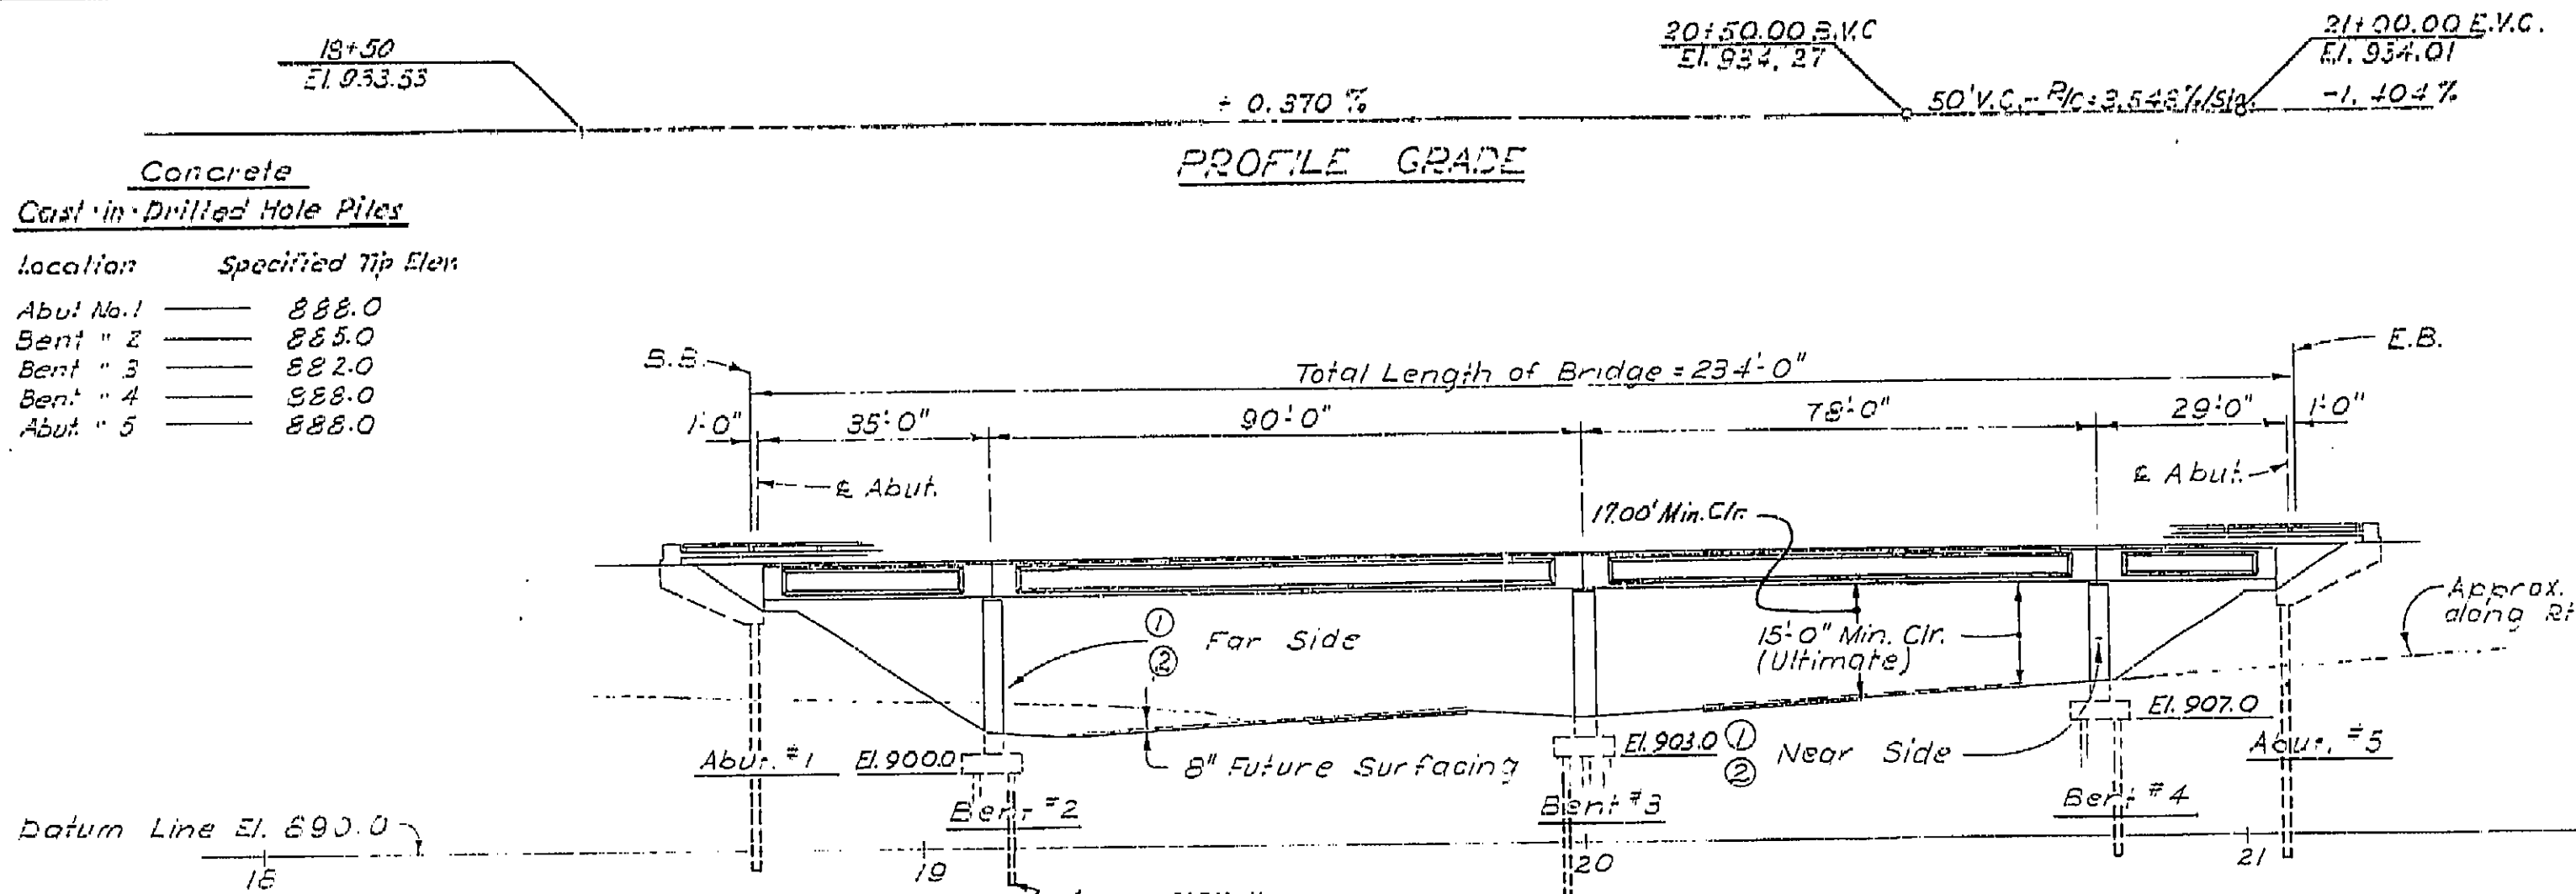

**Concrete Cast-in-Drilled Hole Piles**  
 location Specified Tip Elev.  
 Abut. #1 888.0  
 Bent #2 885.0  
 Bent #3 882.0  
 Bent #4 888.0  
 Abut. #5 888.0

**ELEVATION**  
 Scale: 1" = 20'-0"

① = Point Bridge No. & Date  
 ② = Point Chesebro Rd. O.C.  
 ⊙ Indicates point of minimum vertical clearance.

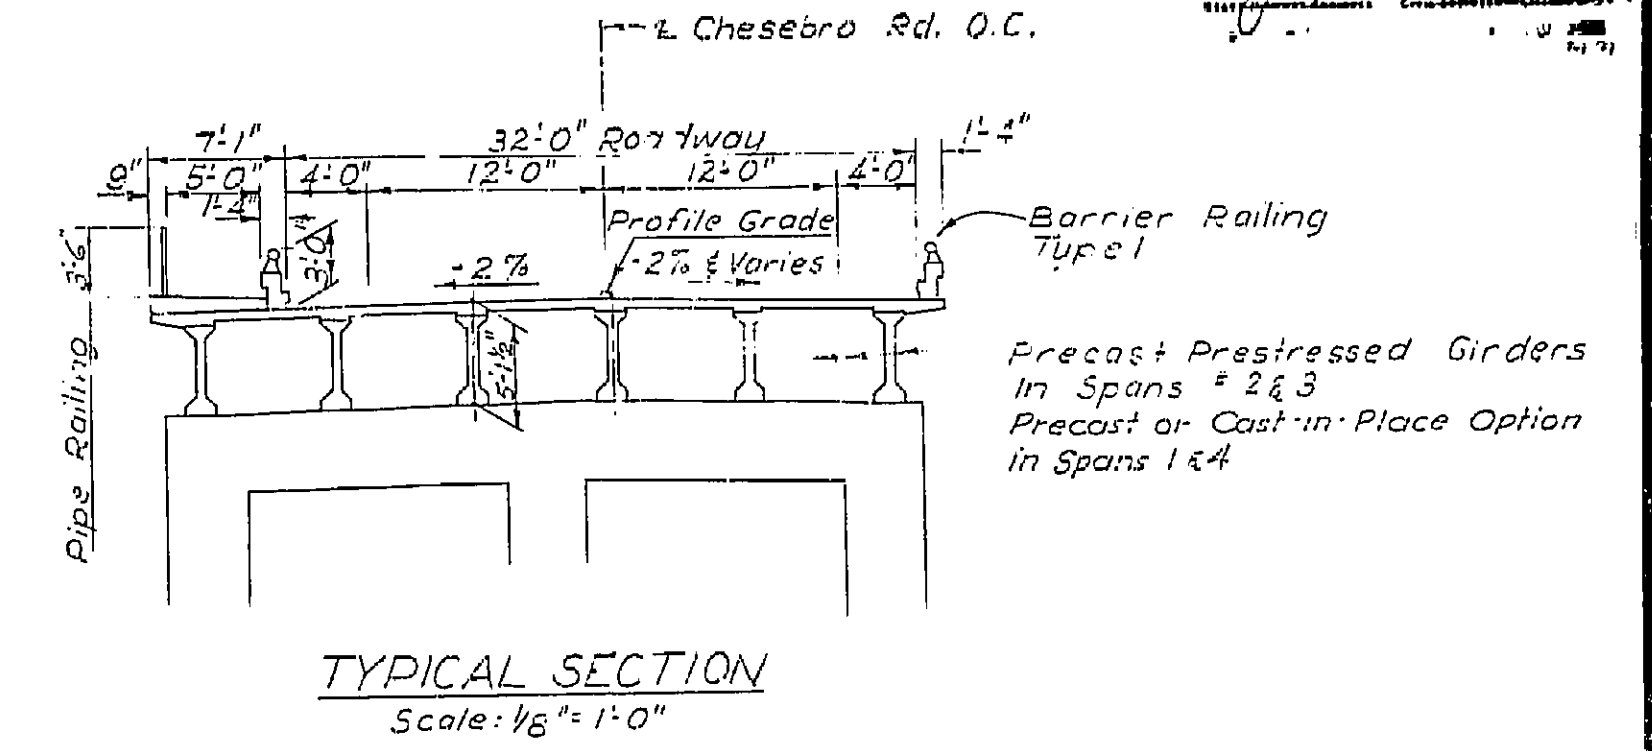


**TYPICAL SECTION**  
 Scale: 1/8" = 1'-0"

**INDEX TO PLANS**

Sheet No.	Title
1	General Plan
2	Grid Grades
3	Foundation Plan
4	Abutment Details
5	Bent Details
6	Typical Sections
7	Girder Layout
8	Girder Details Spans 1 & 4 - Precast Alternative
9	Girder Details Spans 1 & 4 - Cast-in-Place Alternative
10	Girder Details Spans 2 & 3
11	Diaphragm Details
12	Barrier Railing Sheet 1
13	Barrier Railing Sheet 2
14	Pipe Railing
15	Log of Test Borings

**AS BUILT PLANS**  
 Contract No. 63-7V13C58  
 Date Completed  
 Document No. 7000 2373

THIS SET OF PLANS HAS BEEN CORRECTED TO CORRESPOND TO THE "AS BUILT" PRINTS DATED 9-4-63 AS SUBMITTED BY RESIDENT ENGINEER Fred G. Michaels, O.R.R. TRACINGS CORRECTED BY: M.J.R. DATE: 10-24-63

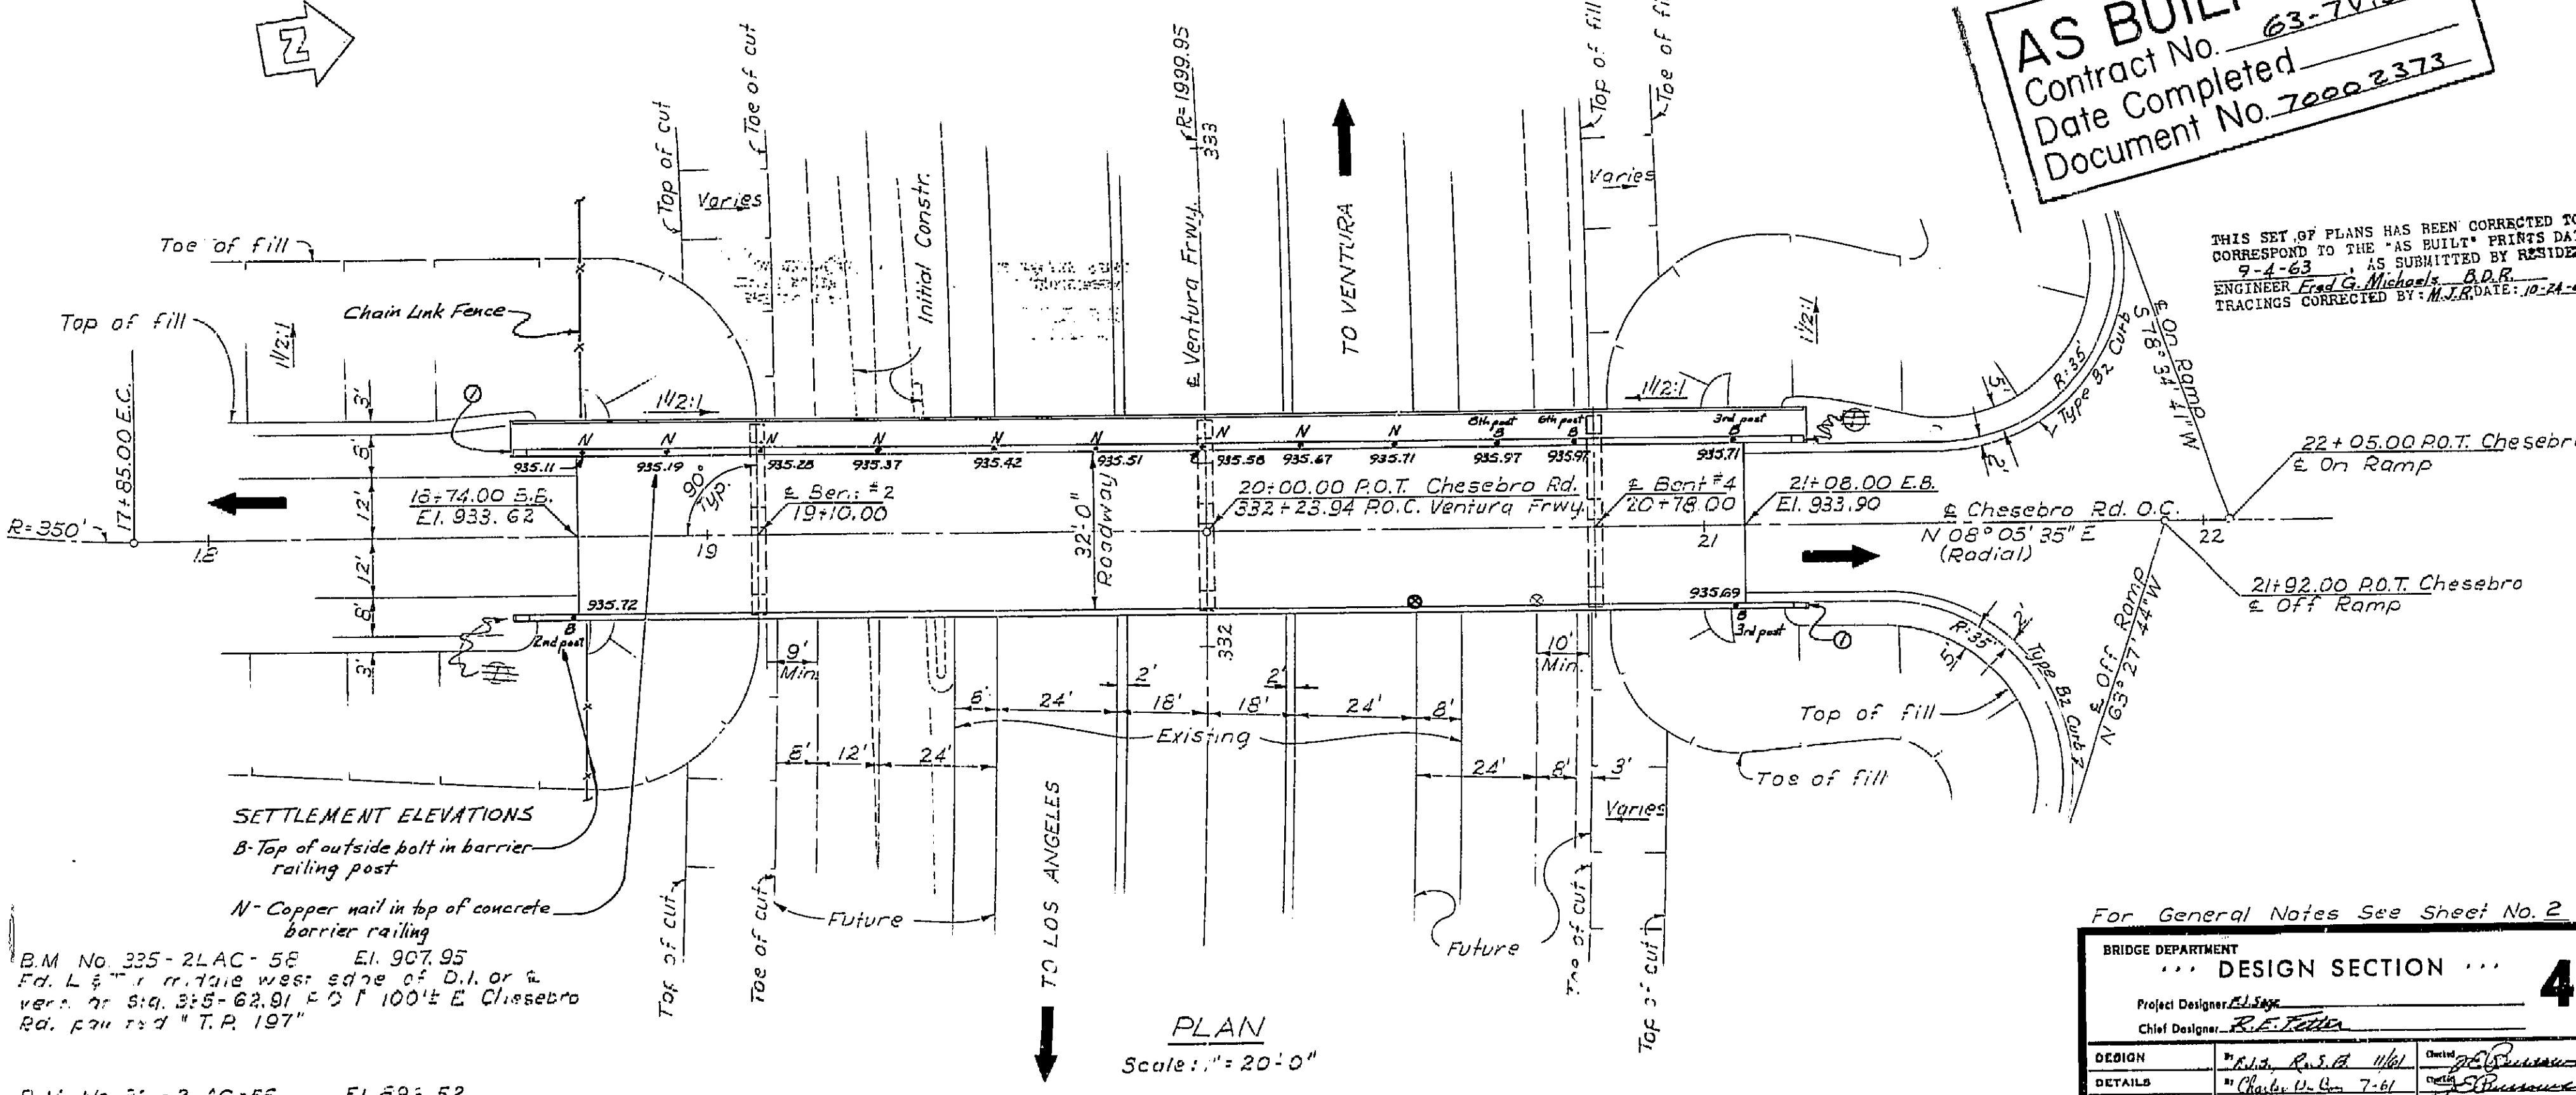

**PLAN**  
 Scale: 1" = 20'-0"

**APPROXIMATE QUANTITIES**

*STRUCTURE EXCAVATION (BRIDGE)	310 C.Y.
*STRUCTURE BACKFILL (BRIDGE)	180 C.Y.
16" C.I.D.H. CONCRETE PILING	1,210 L.F.
FURNISHING PC/PS CONCRETE GIRDERS (90'-0")	6 EA.
FURNISHING PC/PS CONCRETE GIRDERS (78'-0")	6 EA.
ERECTING PC/PS CONCRETE GIRDERS	12 EA.
*CLASS "A" CONCRETE (BRIDGE)	540 C.Y.
RUBBER WATERSTOPS	128 L.F.
JOINT SEALER	128 L.F.
*BAR REINFORCING STEEL (BRIDGE)	109,000 LBS.
MISCELLANEOUS METAL (BRIDGE)	400 LBS.
BARRIER RAILING (TYPE 1)	528 L.F.
PIPE BRIDGE RAILING (3'-6")	262 L.F.

\*FINAL QUANTITIES  
 Contract # 63-7V13C58  
 Note: Route Change (VII-LA-5)

**VENTURA FREEWAY**

For General Notes See Sheet No. 2

BRIDGE DEPARTMENT		DESIGN SECTION		4	
Project Designer: E. L. Lipp					
Chief Designer: R. J. Lipp					
DESIGN	R. J. Lipp	Checked	R. J. Lipp	Checked	R. J. Lipp
DETAILS	R. J. Lipp	Checked	R. J. Lipp	Checked	R. J. Lipp
QUANTITIES	R. J. Lipp	Checked	R. J. Lipp	Checked	R. J. Lipp
SPECIFICATIONS	R. J. Lipp	Checked	R. J. Lipp	Checked	R. J. Lipp
Approval Recommended by: R. J. Lipp					


STATE OF CALIFORNIA DEPARTMENT OF PUBLIC WORKS DIVISION OF HIGHWAYS			
CHESEBRO ROAD OVERCROSSING			
LOCATED ABOUT 400 FEET EAST OF THE INTERSECTION OF EXISTING CHESEBRO RD. AND VENTURA FWY IN LOS ANGELES COUNTY			
GENERAL PLAN			
SCALE AS NOTED	BRIDGE 53-1878	FILE	DRAWING C-531678-1

B.M. No. 335-2-LAC-58 El. 907.95  
 Fd. L. 1/2" from west edge of D.I. or a vert. or sta. 335-62.91 ± 3' 100' ± E. Chesebro Rd. from T.P. 197'

B.M. No. 221-2-LAC-55 El. 893.52  
 Fd. on top of T.P. in cor. 0.2' below F.L. Median strip or a vert. or sta. 321-39.63 B.C.

L.L. = H20-S6-44 & Alternatives




I HEREBY CERTIFY THAT THIS IS A TRUE AND ACCURATE COPY OF THE ABOVE DOCUMENT TAKEN UNDER MY DIRECTION AND CONTROL ON THIS DATE IN SACRAMENTO, CALIFORNIA PURSUANT TO AUTHORIZATION BY THE DIRECTOR OF PUBLIC WORKS.  
 DATE: 11/22 SIGNATURE: TITLE:

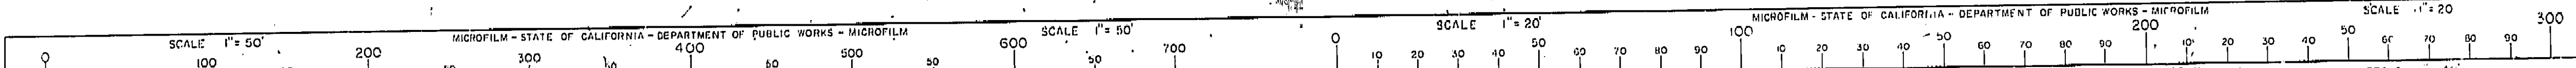

FED. ROAD DIST. NO.	STATE	F. A. PROJECT NO.	SHEET NO.	TOTAL SHEETS
7	CALIF.		53	71


DIST.	COUNTY	ROUTE	SECTION	SHEET NO.	TOTAL SHEETS
VII	LA	8		2	15

DATE APPROVED: *Dr. Robert S. Dyer* 5/12/62

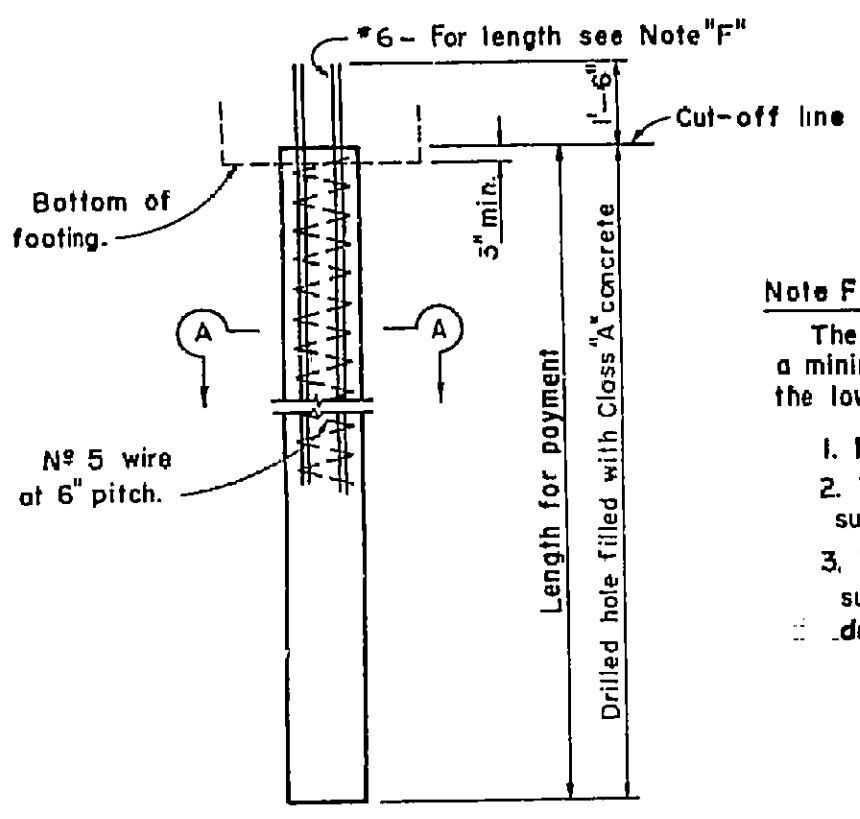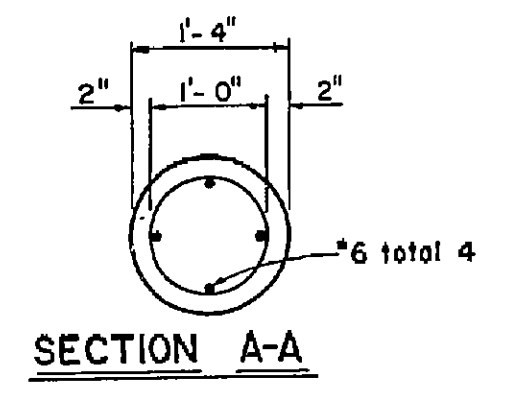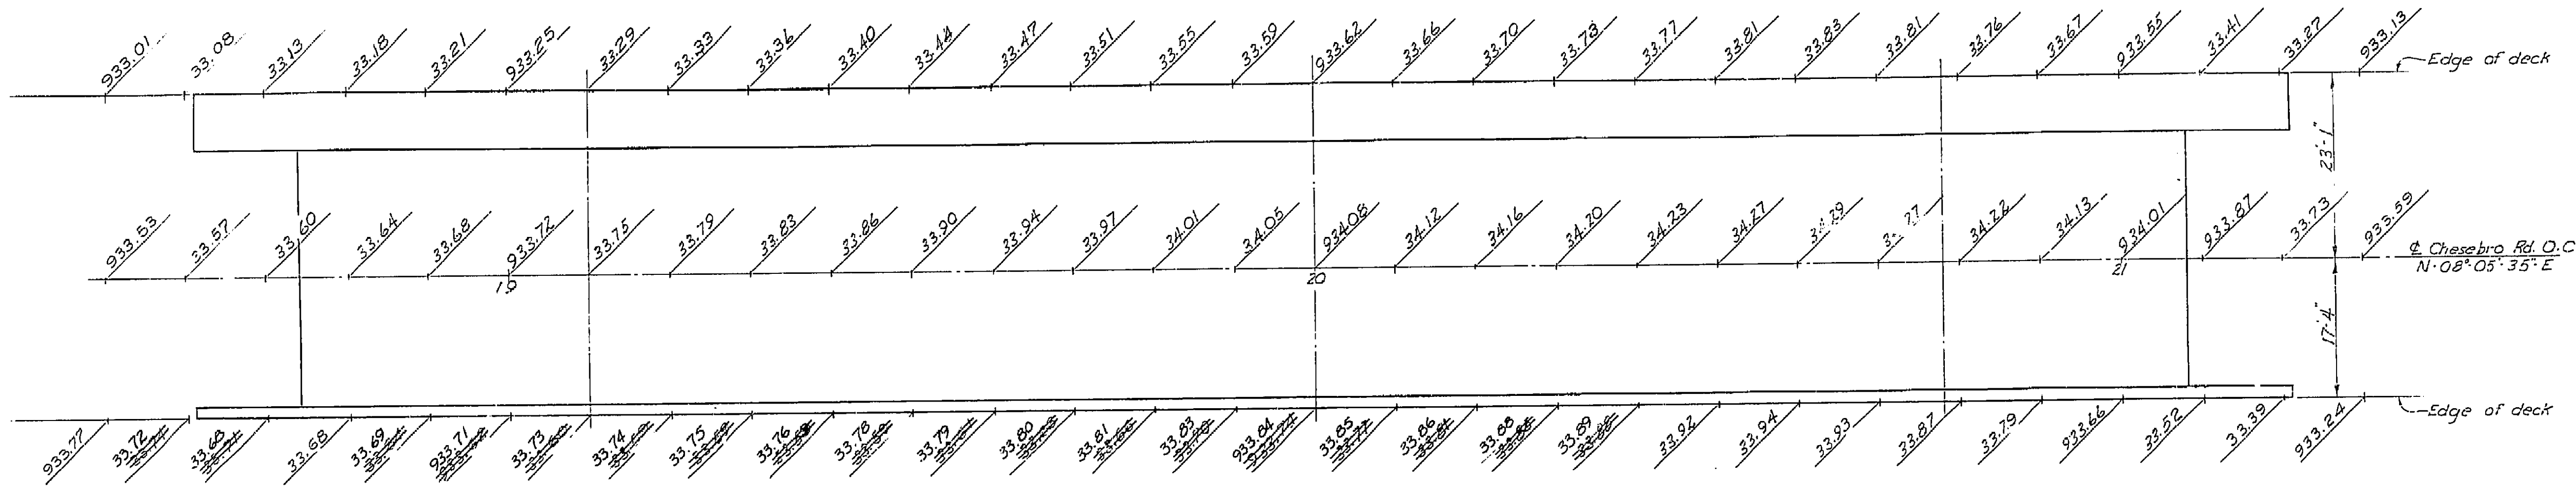

**Note F**  
The #6 bars shall extend a minimum of 12\"/>

- Bottom of footing.
- Top of final ground surface.
- Top of original ground surface when piles are drilled through fill.

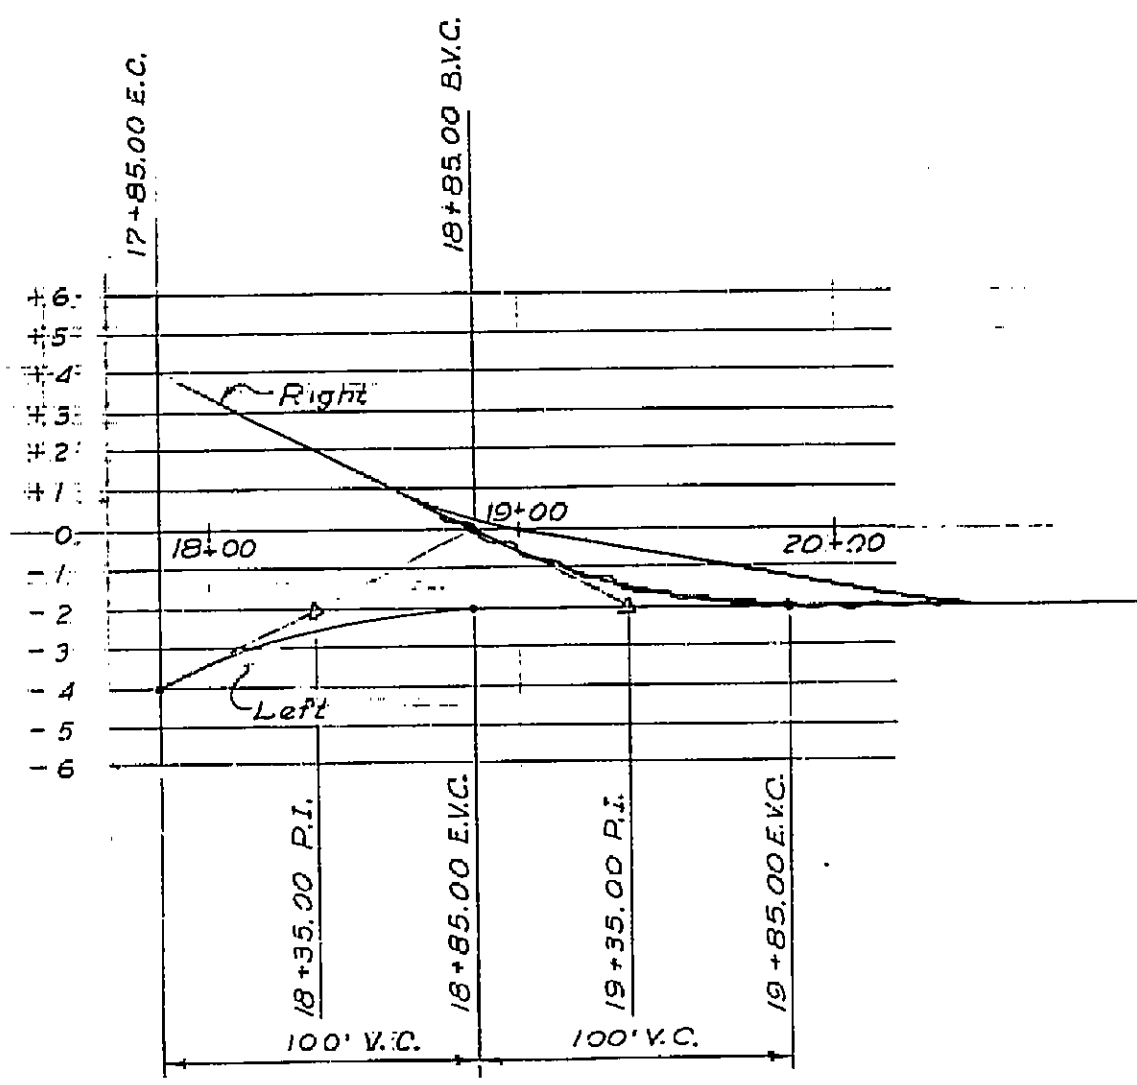

**GENERAL NOTES**

**SPECIFICATIONS:**

DESIGN: A.A.S.H.O. DATED 1957 WITH REVISIONS AND AS SUPPLEMENTED BY BRIDGE PLANNING AND DESIGN MANUAL.

CONSTRUCTION: STANDARD SPECIFICATIONS, DIVISION OF HIGHWAYS, DATED JANUARY 1960 AND THE SPECIAL PROVISIONS.

LIVE LOADING: H20-S16-44 AND ALTERNATIVE

UNIT STRESSES:

REINFORCED CONCRETE:  $F_s = 20,000$  P.S.I.,  $N = 10$   
 $F_c = 1,200$  P.S.I.

PILE LOADING: 45 TONS TYPE: C.I.D.H.


THIS SET OF PLANS HAS BEEN CORRECTED TO CORRESPOND TO THE "AS BUILT" PRINTS DATED 7-16-63, AS SUBMITTED BY RESIDENT ENGINEER *Paul G. Michaels, B.D.P.* TRACINGS CORRECTED BY: *M.T.R.* DATE: 10-24-63

**AS BUILT PLANS**  
Contract No. 63-7V13CS8  
Date Completed \_\_\_\_\_  
Document No. 70002373

BRIDGE DEPARTMENT DESIGN SECTION <b>4</b>		STATE OF CALIFORNIA DEPARTMENT OF PUBLIC WORKS DIVISION OF HIGHWAYS	
Section Supervisor: <i>R. E. Feltner</i>	DESIGN: <i>W. H. R. B. 11-61</i>	CHESEBRO ROAD OVERCROSSING	
DETAILS: <i>W. H. R. B. 11-61</i>	QUANTITIES: <i>W. H. R. B. 11-61</i>	GRID GRADES	
SCALE: 1" = 10'		BRIDGE: 53-1619	FILE: DRAWING C-531678-2

I HEREBY CERTIFY THAT THIS IS A TRUE AND ACCURATE COPY OF THE ABOVE DOCUMENT TAKEN UNDER MY DIRECTION AND CONTROL ON THIS DATE IN SACRAMENTO, CALIFORNIA PURSUANT TO AUTHORIZATION BY THE DIRECTOR OF PUBLIC WORKS.

DATE: 11/22 SIGNATURE: [Signature] TITLE: [Title]

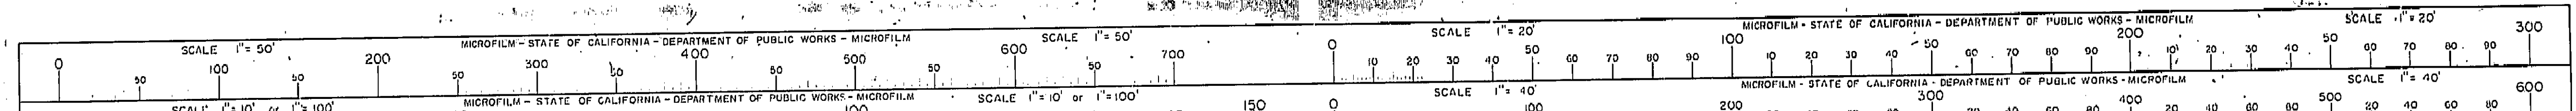

58


772



FED. ROAD DIST. NO.	STATE	F. & PROJECT NO.	SHEET NO.	TOTAL SHEETS
7	CALIF.		53	91

VII LA 5

*J. J. Johnston*  
 DATE APPROVED: Dec 18, 1952

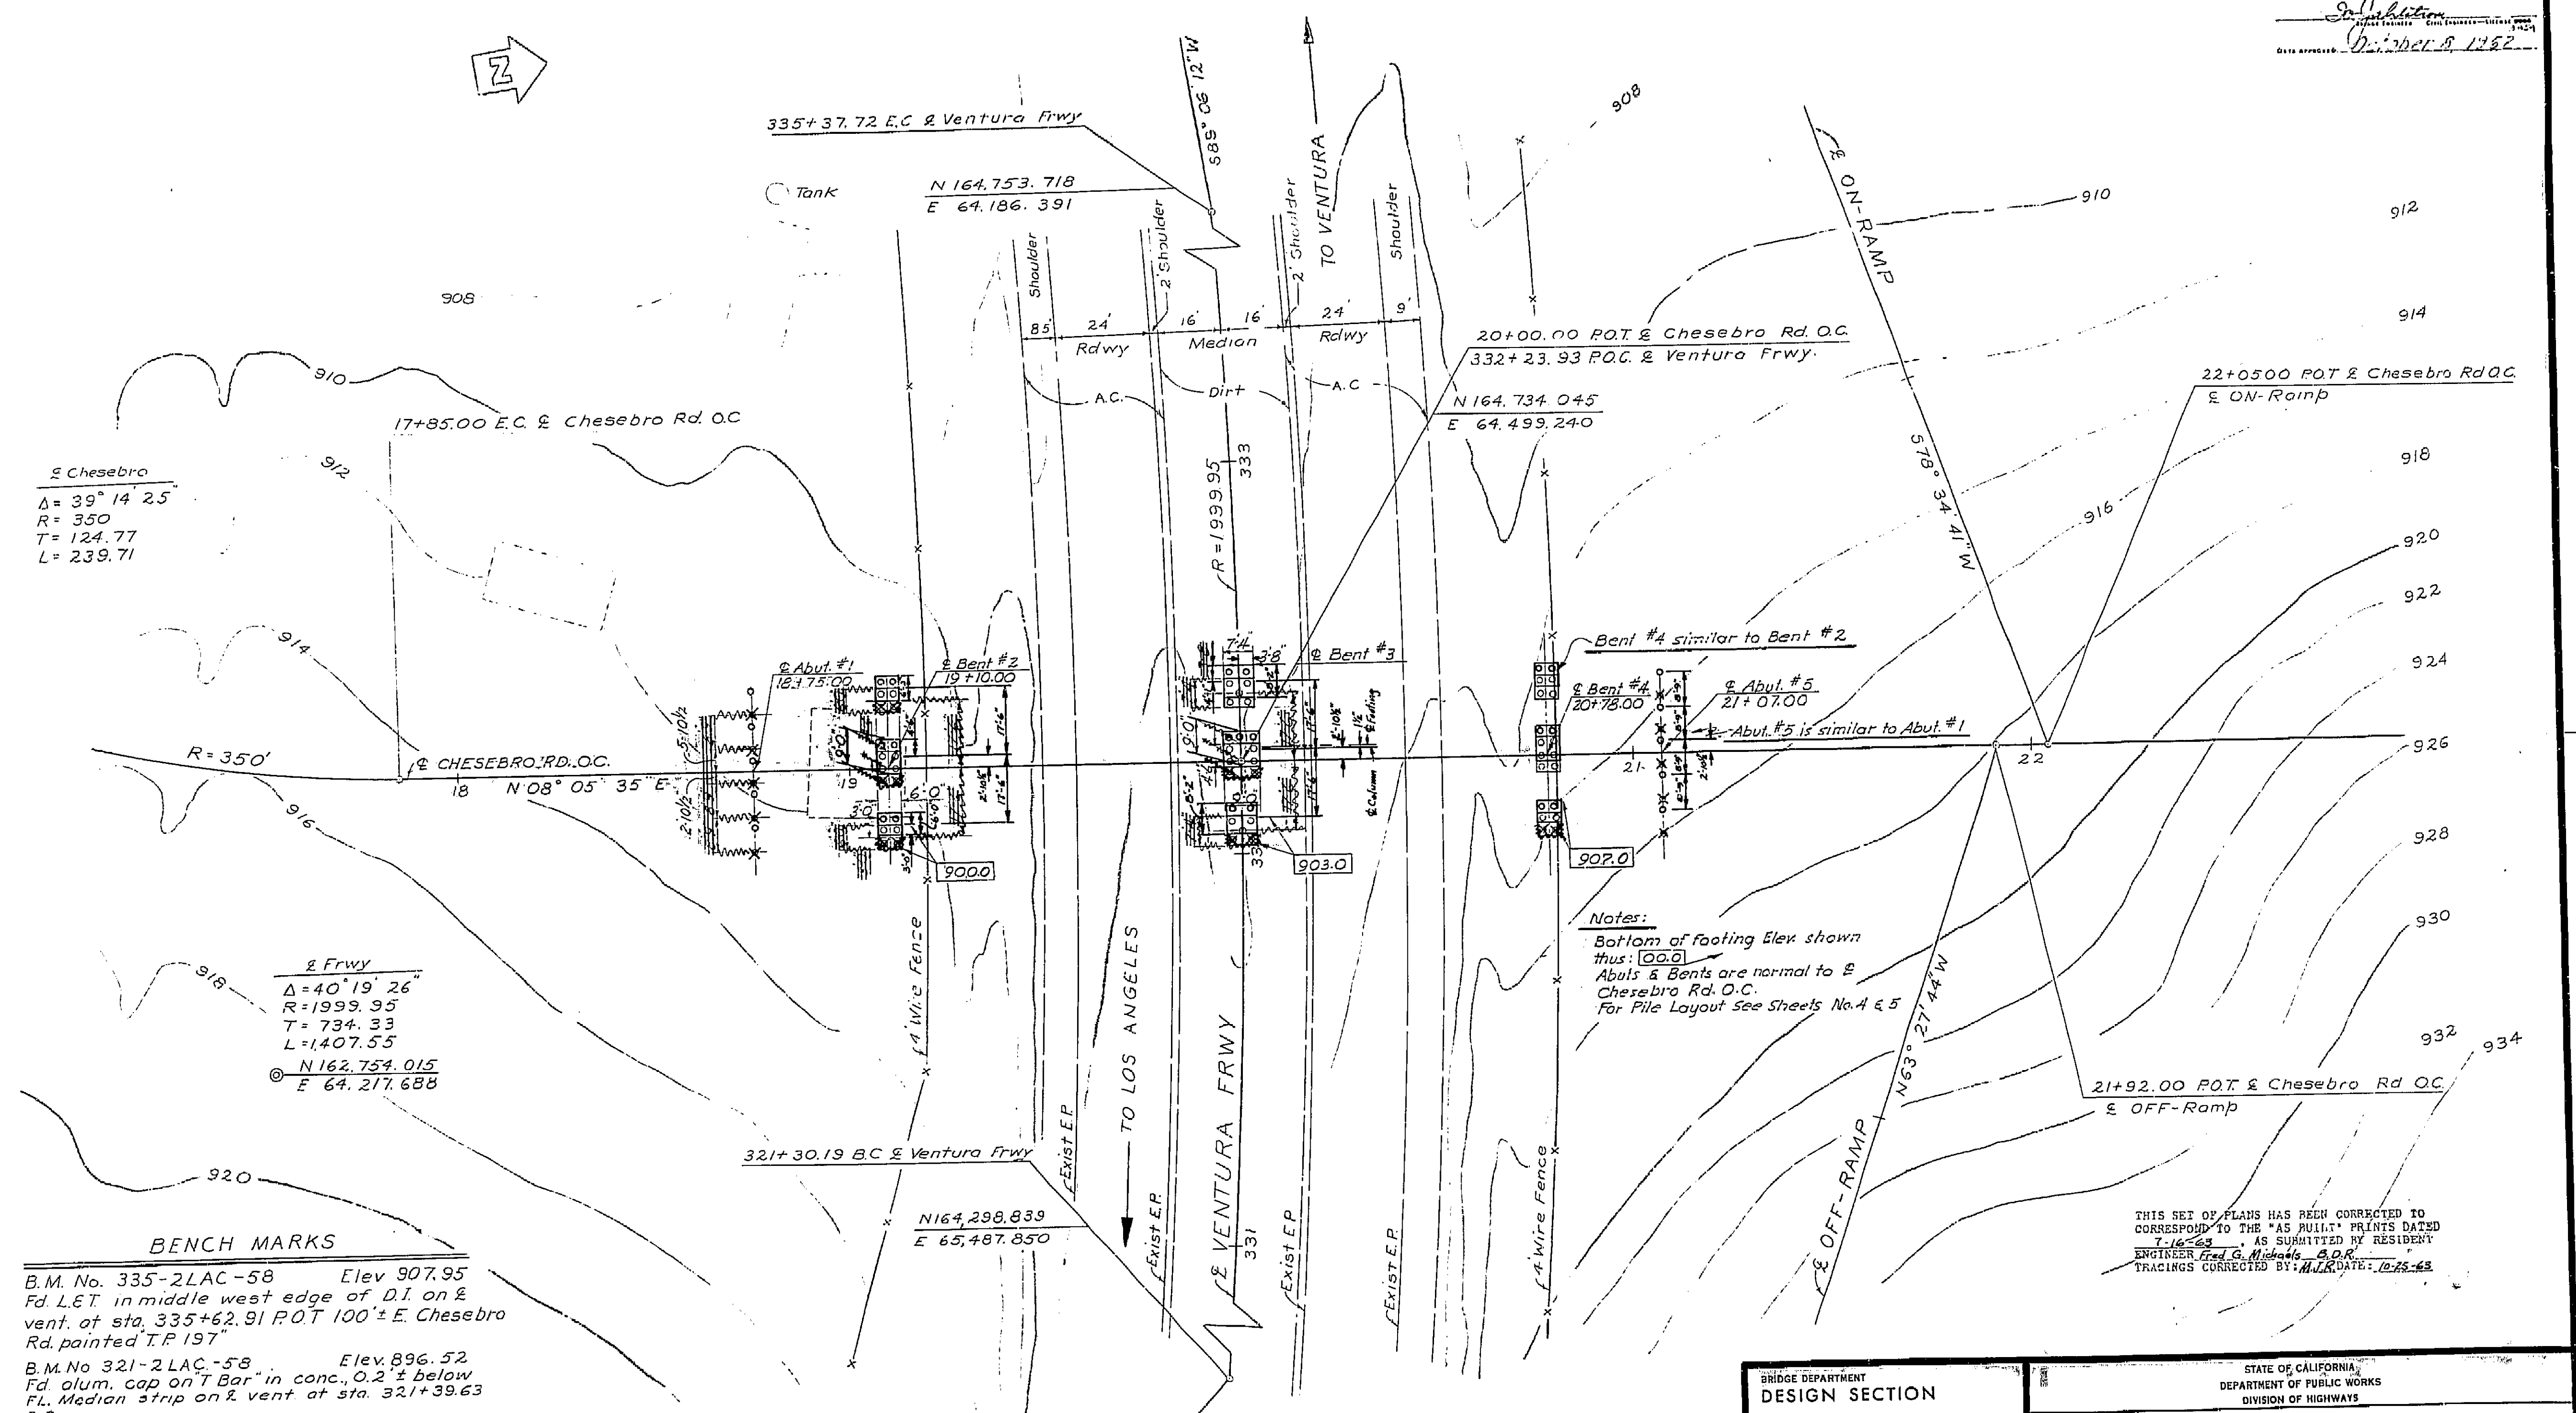

Chesebro  
 $\Delta = 39^\circ 14' 25"$   
 $R = 350$   
 $T = 124.77$   
 $L = 239.71$

Frwy  
 $\Delta = 40^\circ 19' 26"$   
 $R = 1999.95$   
 $T = 734.33$   
 $L = 1407.55$   
 $N 162.754.015$   
 $E 64.217.688$

**BENCH MARKS**  
 B.M. No. 335-2LAC-58 Elev. 907.95  
 Fd. L&T in middle west edge of D.I. on E vent. of sta. 335+62.91 P.O.T. 100' E. Chesebro Rd. painted T.P. 197  
 B.M. No. 321-2LAC-58 Elev. 896.52  
 Fd. alum. cap on T Bar in conc. 0.2' below RL Median strip on E vent. at sta. 321+39.63 B.C.


**AS BUILT PLANS**  
 Contract No. 63-7V13CS8  
 Date Completed \_\_\_\_\_  
 Document No. 7000 2373

CONTOURS CHECKED & VERIFIED IN FIELD  
 Date: June 1961  
 by: J.E.B.

Drawn By H.R. Mariscal 6-26-61  
 Checked By F.C.M.L. 8-5-61

BRIDGE DEPARTMENT DESIGN SECTION		STATE OF CALIFORNIA DEPARTMENT OF PUBLIC WORKS DIVISION OF HIGHWAYS	
Section Supervisor: <i>R. E. Foster</i>	CHESEBRO ROAD OVERCROSSING		
DESIGN: <i>H. R. Mariscal</i>	FOUNDATION PLAN		
DETAILS: <i>H. R. Mariscal</i>	SCALE: 1"=20'	BRIDGE: 53-1676	FILE: 63
QUANTITIES: <i>H. R. Mariscal</i>	DRAWING: C-531678-3		
PREL. DRAWING NO. P. 531678		DRAWING NO. 531678-3	

I HEREBY CERTIFY THAT THIS IS A TRUE AND ACCURATE COPY OF THE ABOVE DOCUMENT TAKEN UNDER MY DIRECTION AND CONTROL ON THIS DATE IN SACRAMENTO, CALIFORNIA PURSUANT TO AUTHORIZATION BY THE DIRECTOR OF PUBLIC WORKS.  
 DATE 1-18-72 SIGNATURE *Jim B. [unclear]* TITLE \_\_\_\_\_







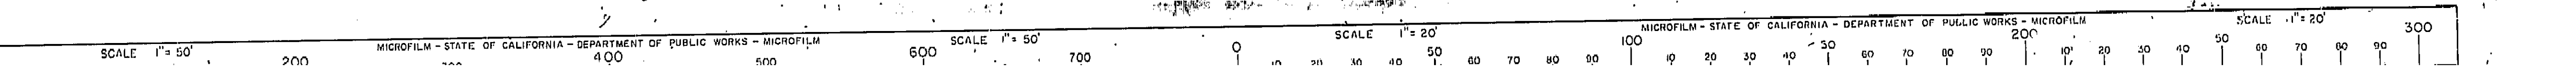


59

FED. ROAD DIST. NO.	STATE	P. A. PROJECT NO.	SHEET NO.	TOTAL SHEETS
7	CALIF.		60	21

DATE	COUNTY	ROUTE	SECTION	POST MILE	TOTAL MILES
11/14	LA	5	3	4	115

DATE APPROVED: *[Signature]*  
 11/14/62

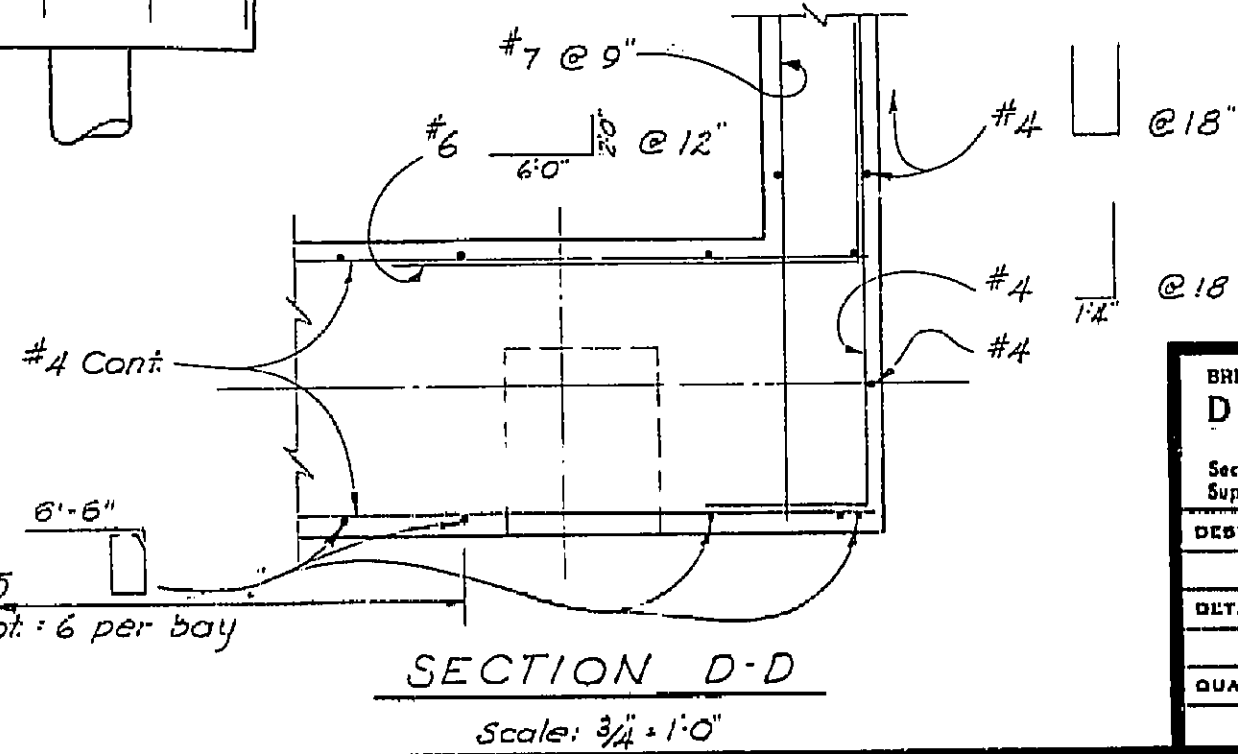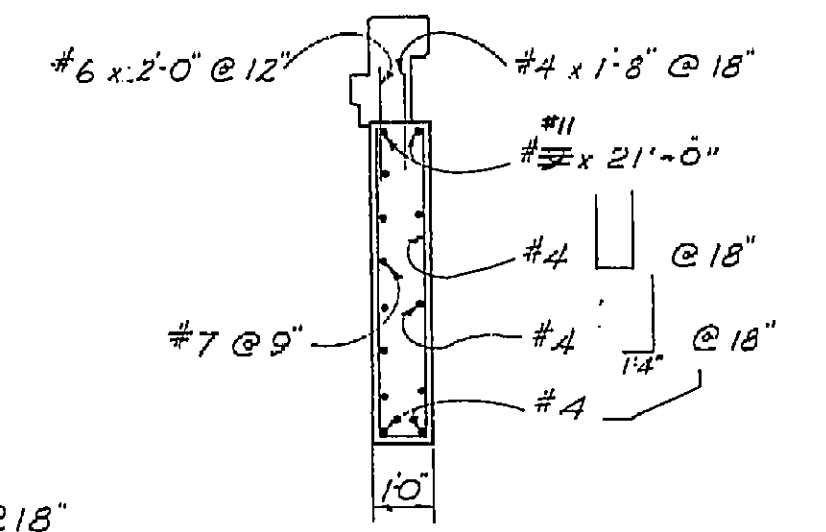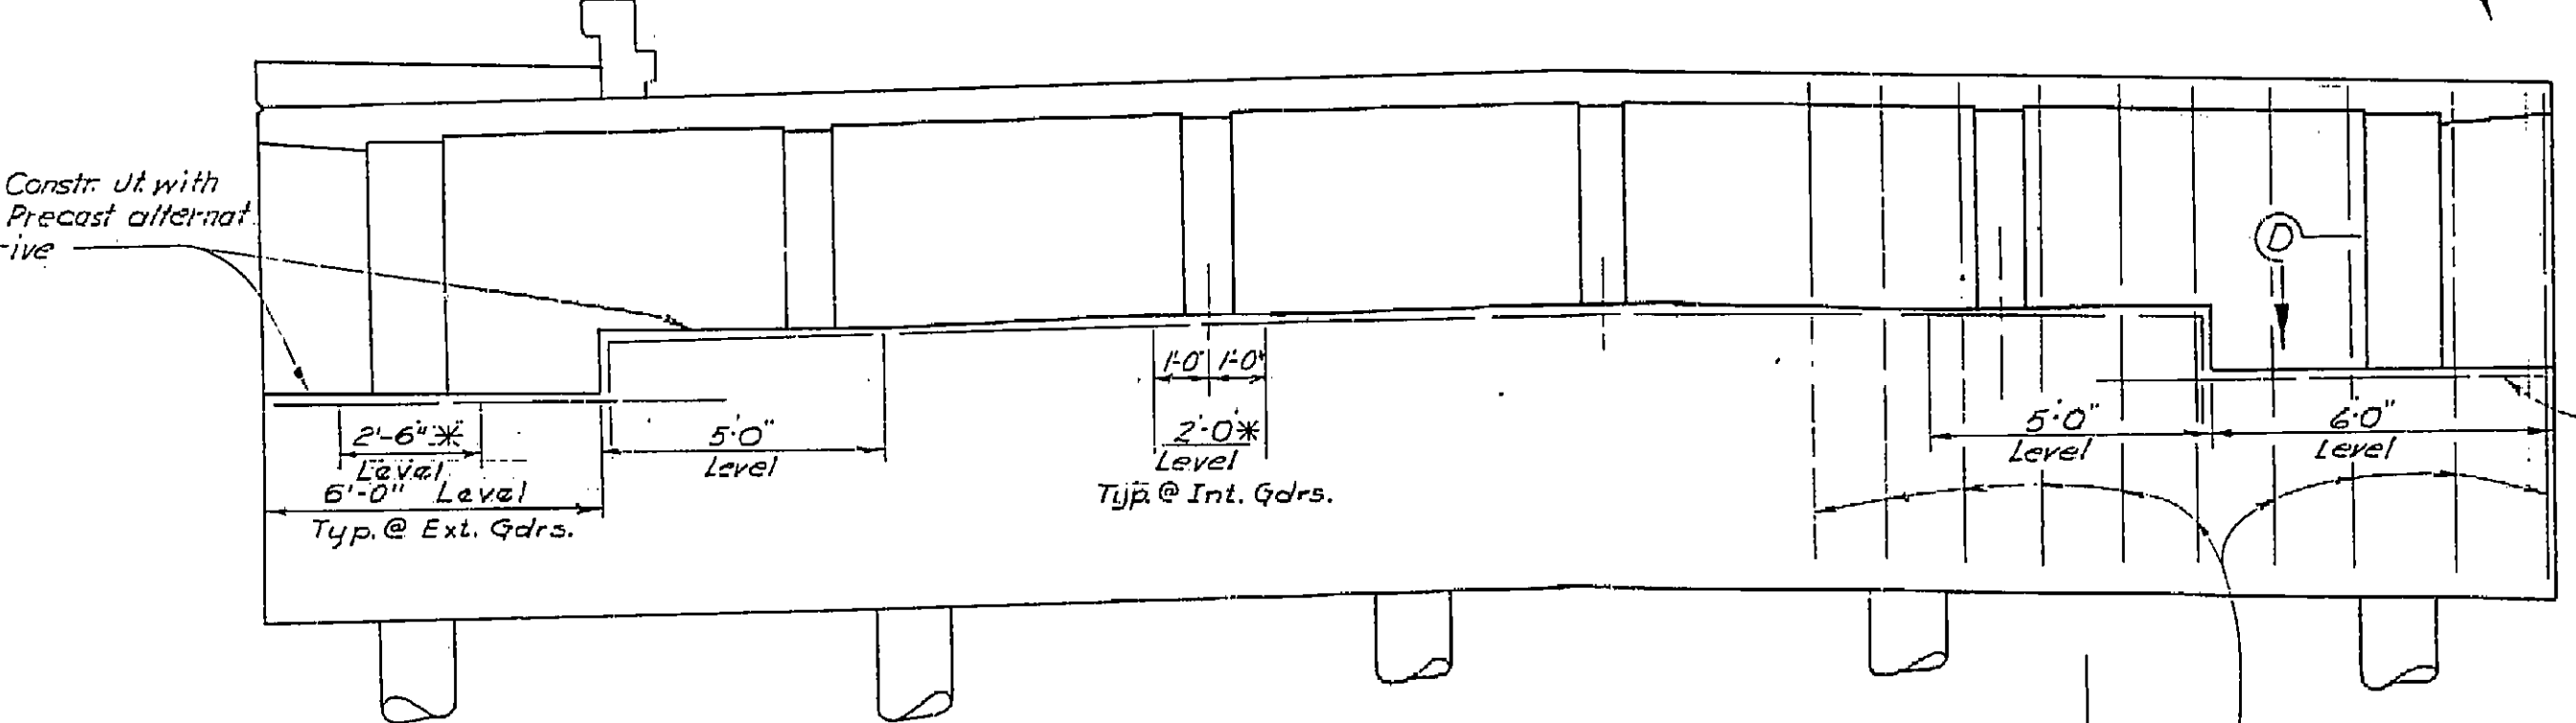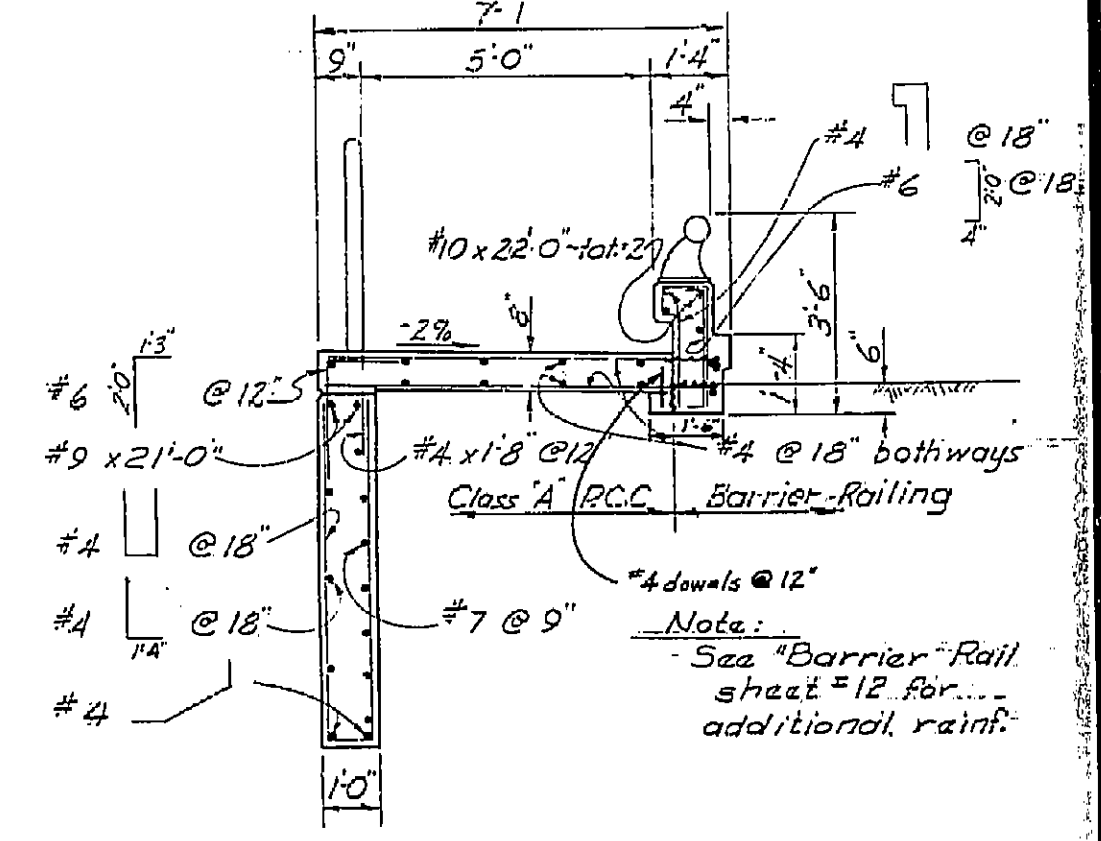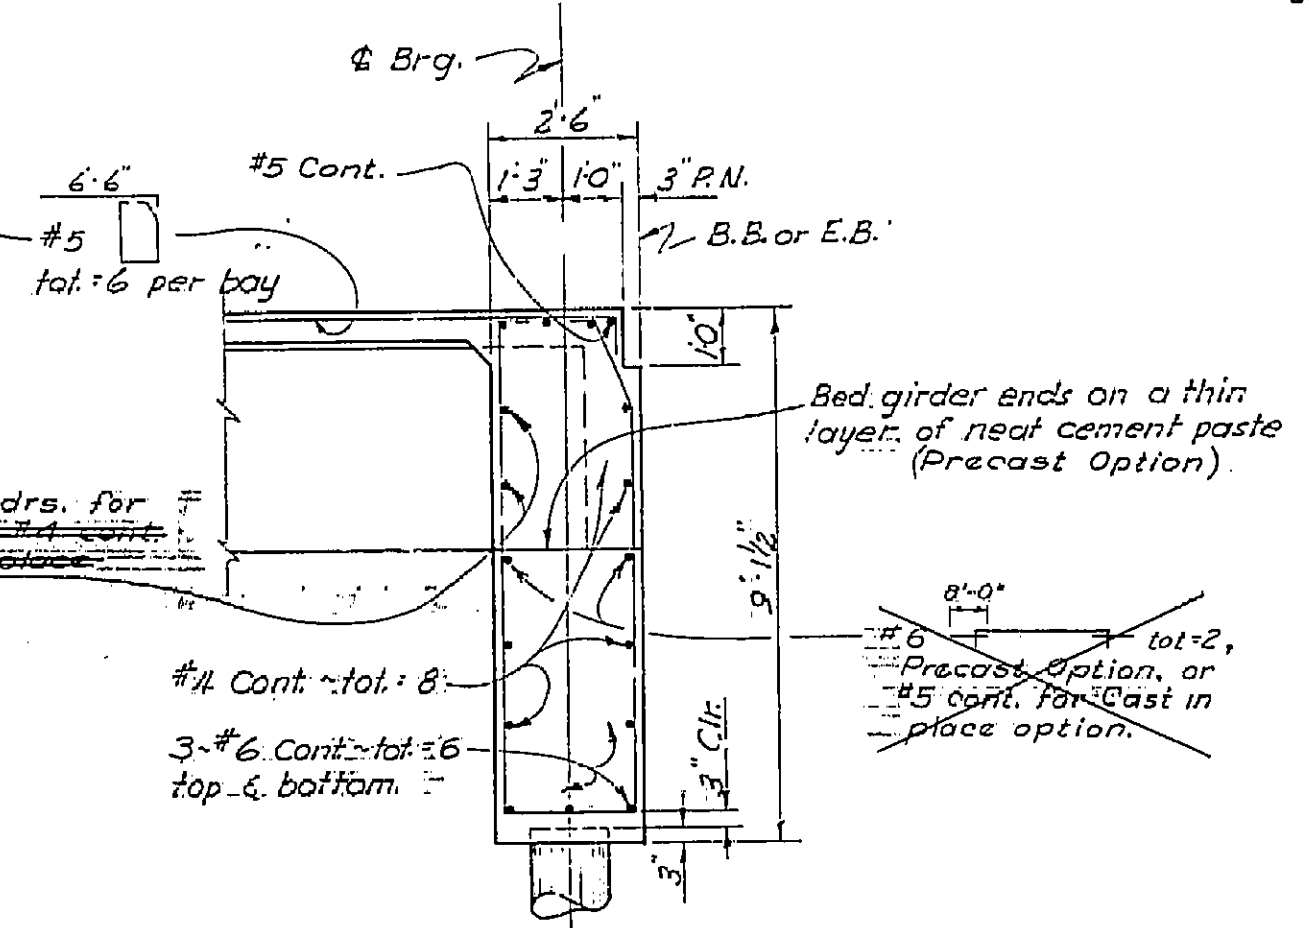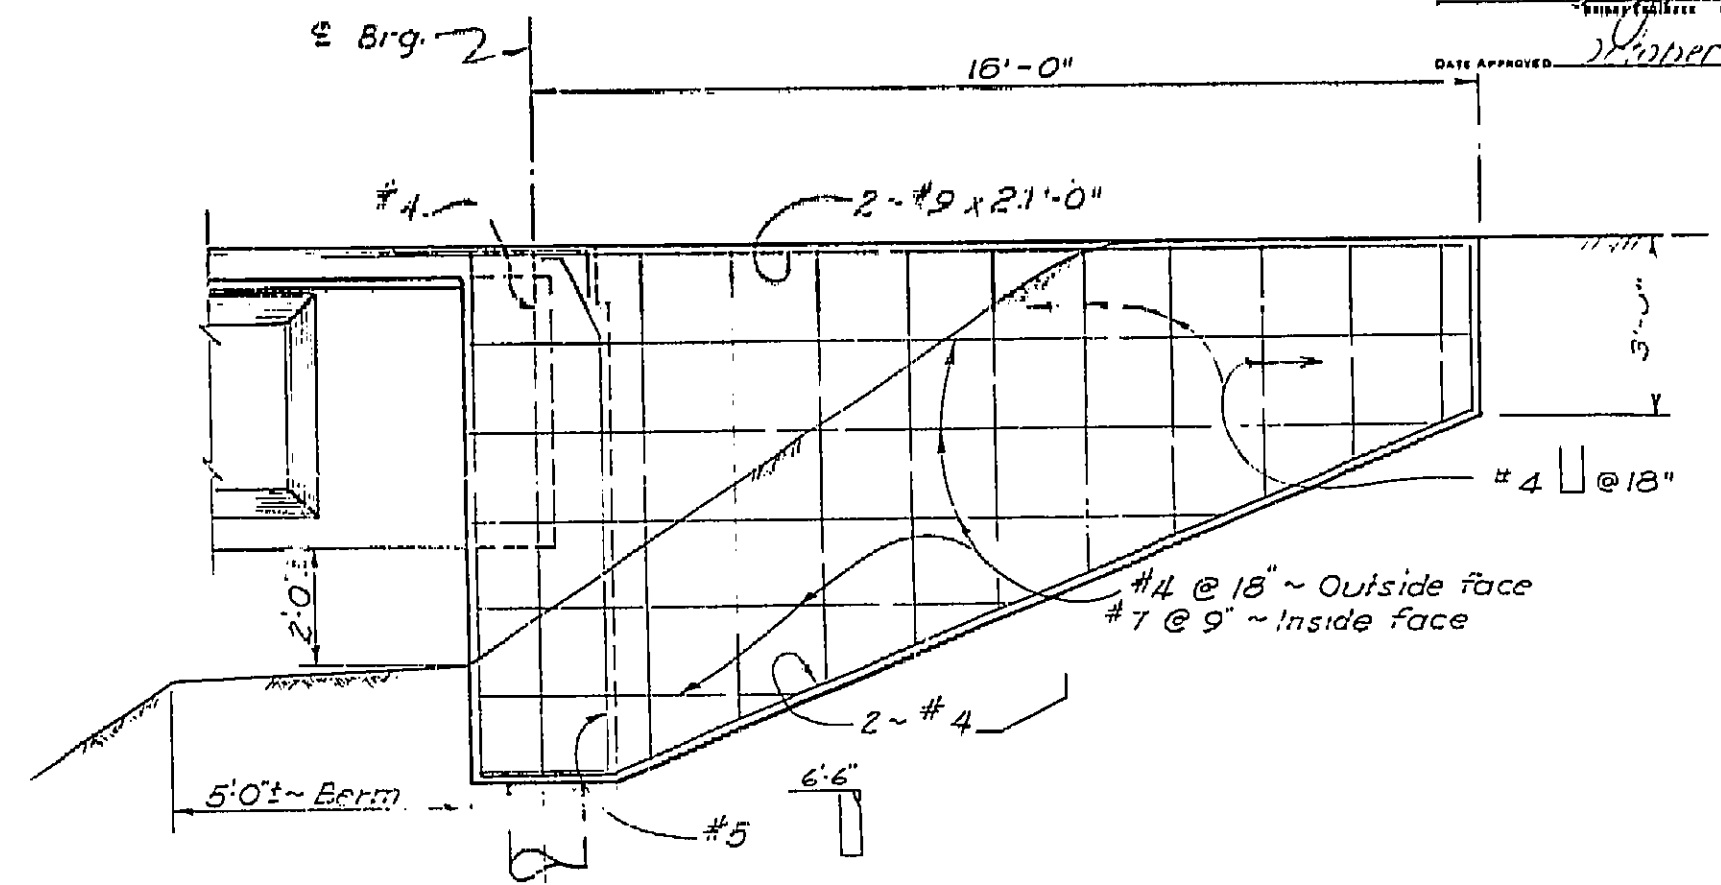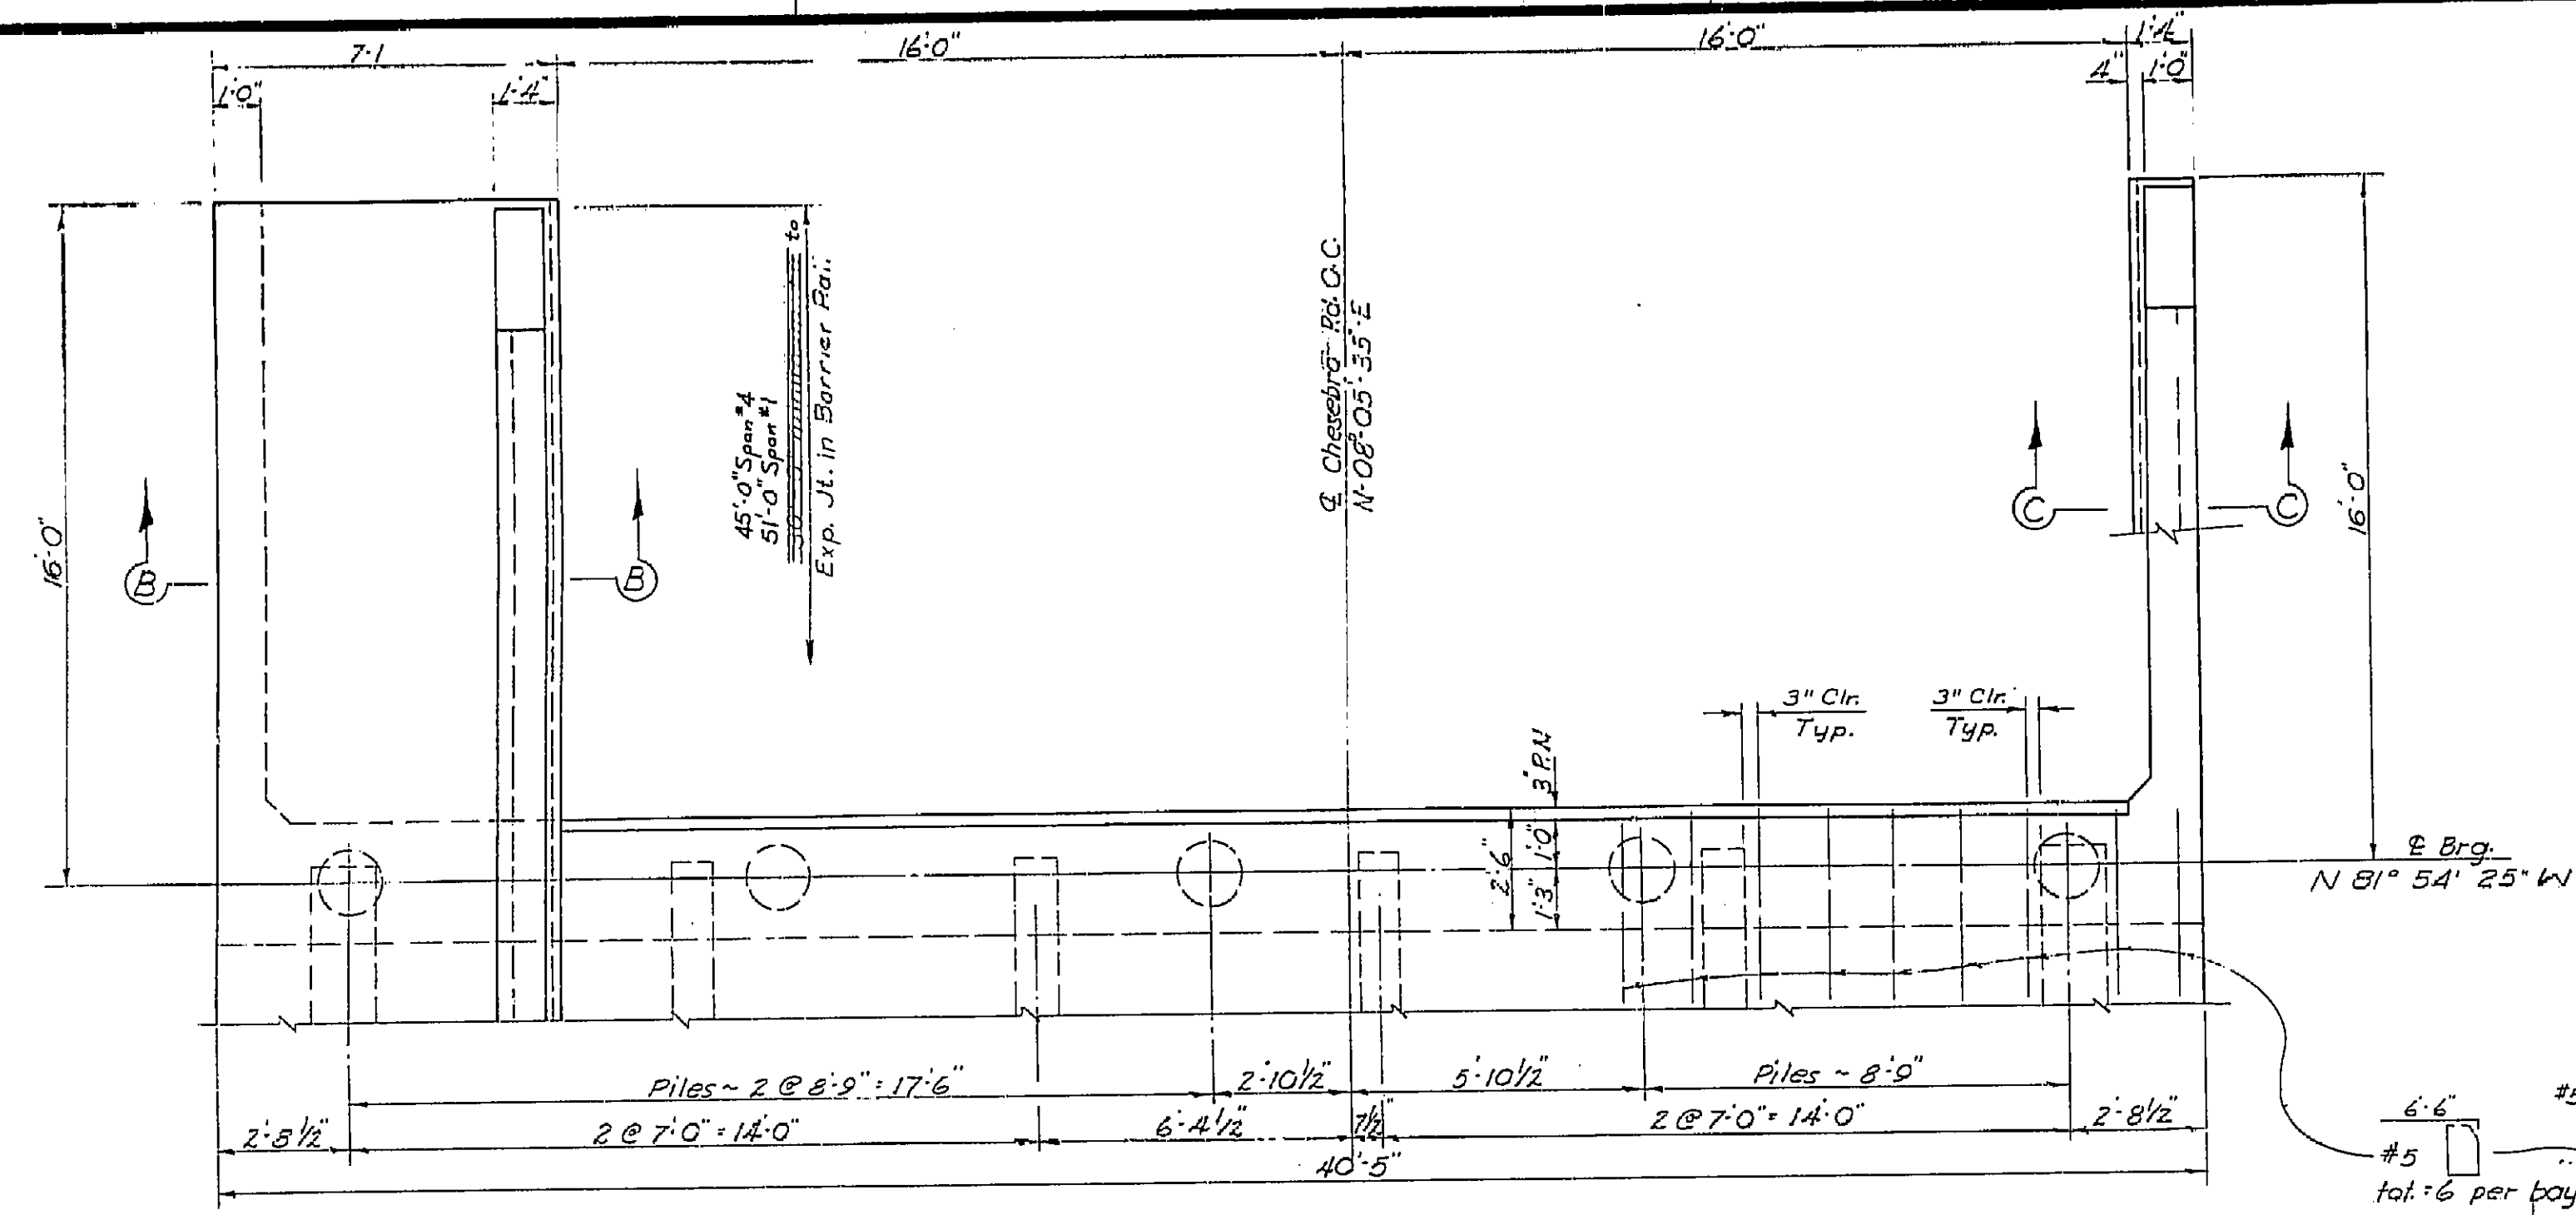

\* For Precast Option - Finish or grind to a smooth surface, (level normal to E. Gdr., and at slope of gdr. length. to W. gdr.) set girders in a thin layer of neat cement grout.

**AS BUILT PLANS**  
 Contract No. 63-7V13C58  
 Date Completed \_\_\_\_\_  
 Document No. 7000 2373


Note:  
 For Barrier Railing Details not shown See Sheets #12 & 13

THIS SET OF PLANS HAS BEEN CORRECTED TO CORRESPOND TO THE "AS BUILT" PRINTS DATED 7-16-63 AS SUBMITTED BY RESIDENT ENGINEER Fred C. Michaels - B.O.R. TRACINGS CORRECTED BY: M.J.C. DATE: 10-25-63

BRIDGE DEPARTMENT	
<b>DESIGN SECTION 4</b>	
Section Supervisor	<i>R.H. Patten</i>
DESIGN	By E.L.S. R.S.B. 11/61
DETAILS	By G.P. [Signature] 11-61
QUANTITIES	By G.P. [Signature] 12/61

STATE OF CALIFORNIA DEPARTMENT OF PUBLIC WORKS DIVISION OF HIGHWAYS			
<b>CHESEBRO ROAD OVERCROSSING</b>			
<b>ABUTMENT DETAILS</b>			
SCALE AS SHOWN	BRIDGE 53-1678	FILE	DRAWING C-531678-4
PRELIMINARY DRAWING NO. P-531678-3		REVISION DATES	

I HEREBY CERTIFY THAT THIS IS A TRUE AND ACCURATE COPY OF THE ABOVE DOCUMENT TAKEN UNDER MY DIRECTION AND CONTROL ON THIS DATE IN SACRAMENTO, CALIFORNIA PURSUANT TO AUTHORIZATION BY THE DIRECTOR OF PUBLIC WORKS.  
 DATE 1-11-72 SIGNATURE *[Signature]* TITLE \_\_\_\_\_

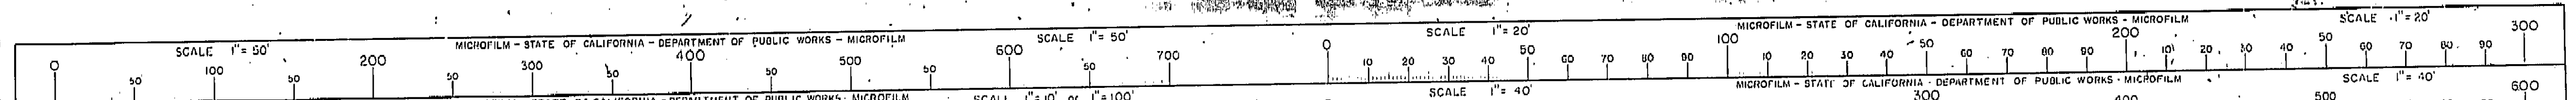





FED. ROAD DIST. NO.	STATE	F. A. PROJECT NO.	SHEET NO.	TOTAL SHEETS
7	CALIF.		36	11



DIST.	COUNTY	ROUTE	SECTION	SHEET NO.	TOTAL SHEETS
VI	LA	5		6	16

Note:  
Anticipated deflection due to placing of deck = 1/2" of midspan of the 90 prestressed girder span & 1/4" at midspan of the 78 prestressed girder span. Final deck grade and camber to be determined by the Engineer.

Note:  
For Barrier Railing Details not shown See Sheets # 12 & 13  
For Precast Prestressed Girder Details See Sht # 10

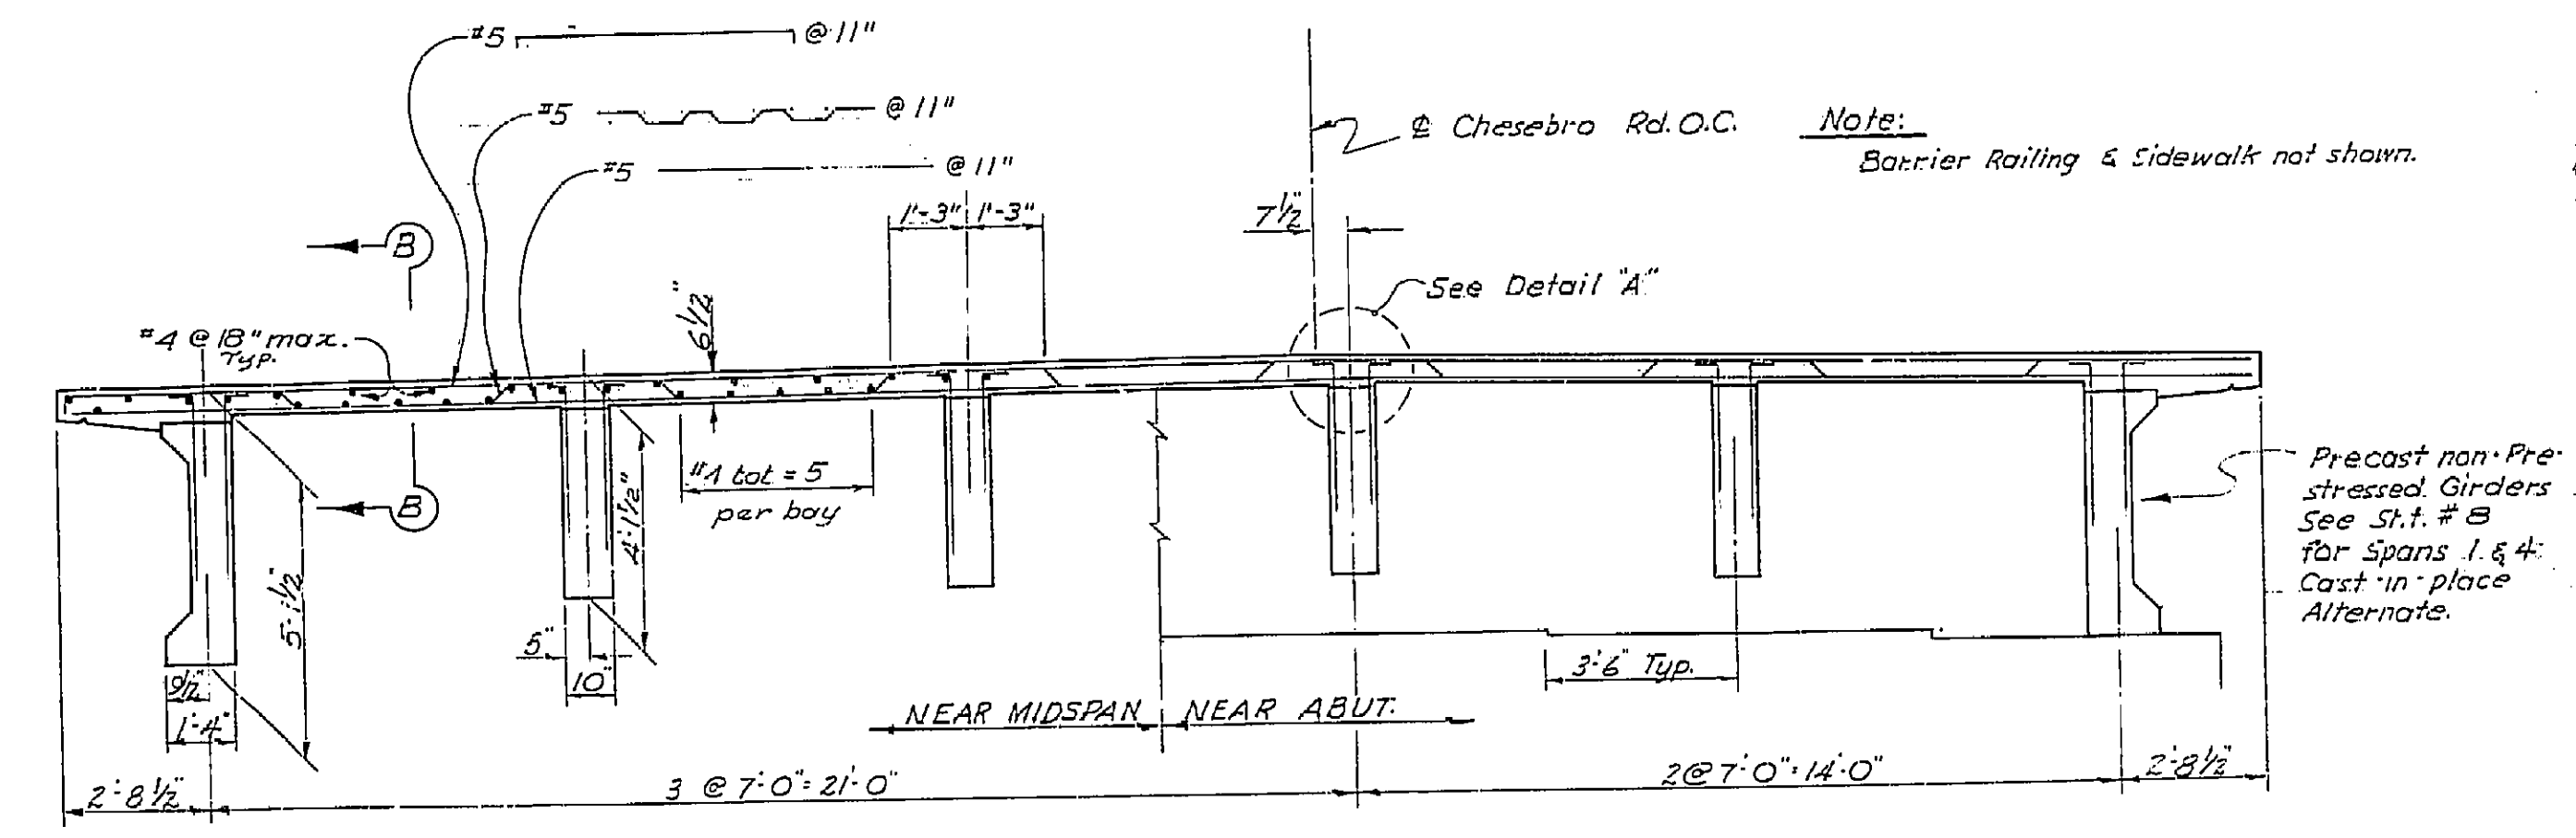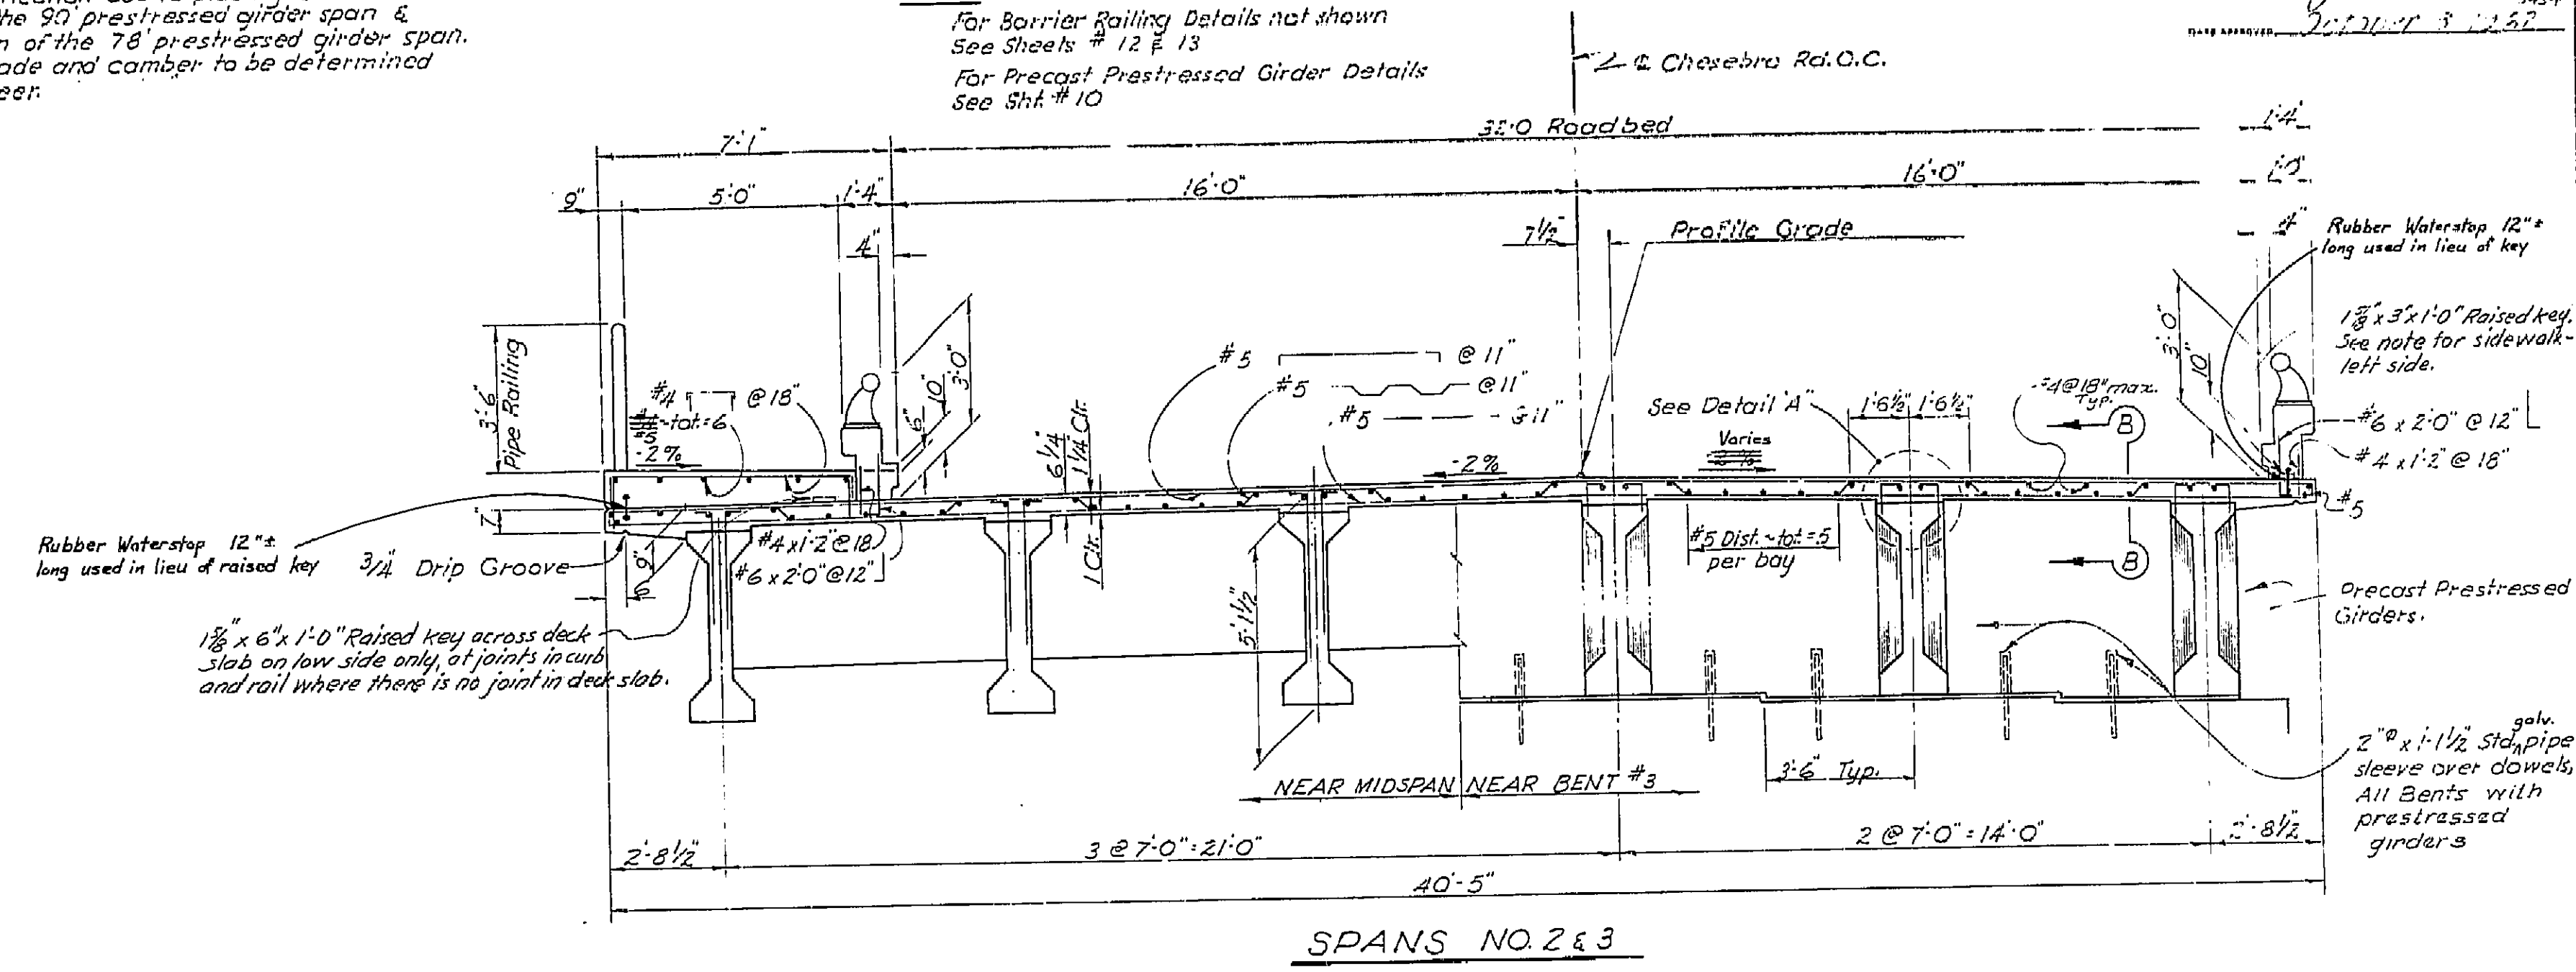

**AS BUILT PLANS**  
Contract No. 63-7V13C58  
Date Completed \_\_\_\_\_  
Document No. 70002373

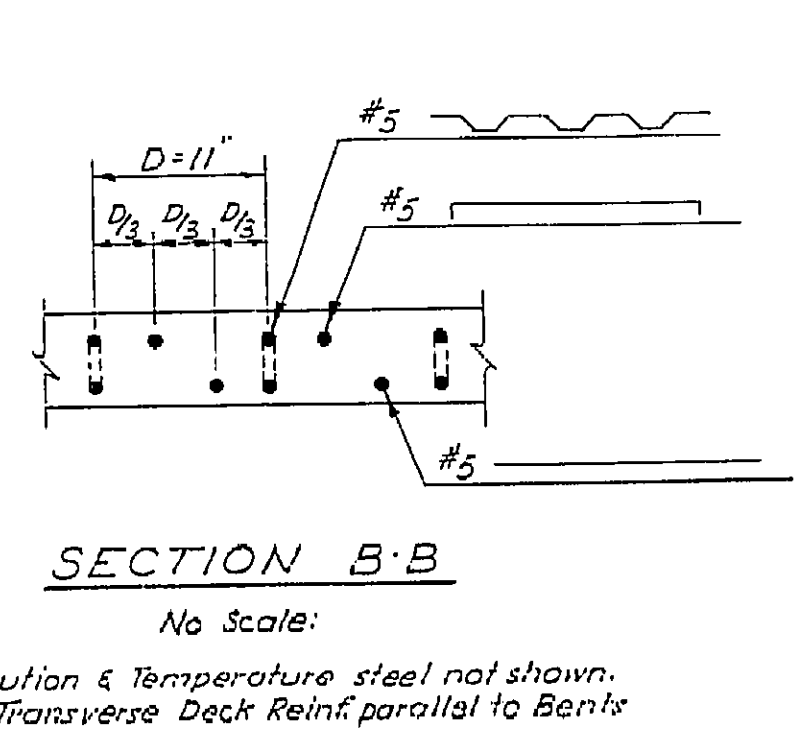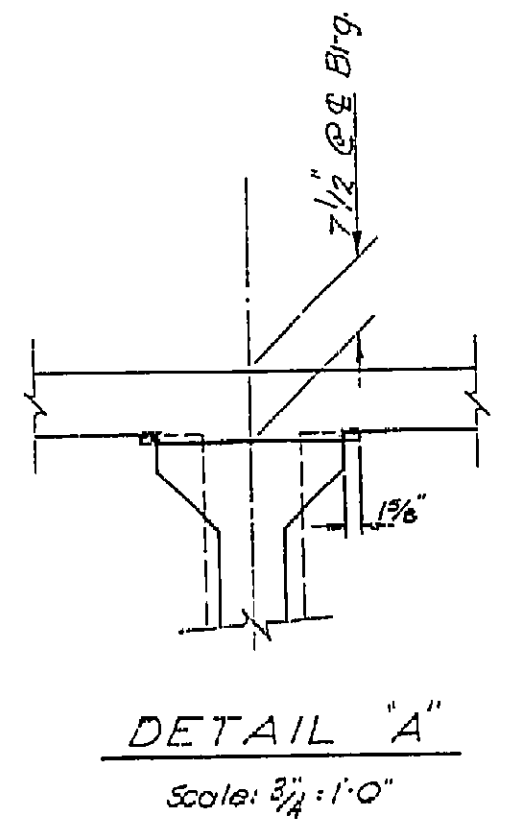


SPANS NO. 1 & 4  
(For Details Not Shown See Spans No. 2 & 3)  
**TYPICAL SECTIONS**  
Scale: 3/8" = 1'-0"

THIS SET OF PLANS HAS BEEN CORRECTED TO CORRESPOND TO THE "AS BUILT" PRINTS DATED 7-18-63 AS SUBMITTED BY RESIDENT ENGINEER Fred G. Michaels, B.O.B. TRACINGS CORRECTED BY: M.L.R. DATE: 10-25-63

BRIDGE DEPARTMENT <b>DESIGN SECTION 4</b>		STATE OF CALIFORNIA DEPARTMENT OF PUBLIC WORKS DIVISION OF HIGHWAYS	
Section Supervisor <i>R. E. [Signature]</i>	DESIGN BY: E.L.S. R.S.B. 11/61	CHESEBRO ROAD OVERCROSSING	
DETAILS BY: [Signature]	QUANTITIES BY: [Signature]	TYPICAL SECTIONS	
SCALE AS SHOWN		BRIDGE 53-1678	FILE
PRELIMINARY DRAWING NO. P-531678-2		DRAWING C-531678-6	

I HEREBY CERTIFY THAT THIS IS A TRUE AND ACCURATE COPY OF THE ABOVE DOCUMENT TAKEN UNDER MY DIRECTION AND CONTROL ON THIS DATE IN SACRAMENTO, CALIFORNIA PURSUANT TO AUTHORIZATION BY THE DIRECTOR OF PUBLIC WORKS.  
DATE 1-15-72 SIGNATURE [Signature] TITLE \_\_\_\_\_

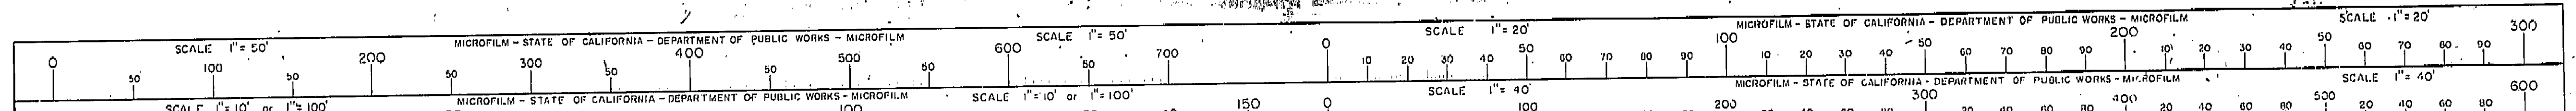


***APPENDIX B  
AS-BUILT PLANS (PRESTRESSED I GIRDER  
REPLACEMENT)***

---

CONTRACT NO: 07-4K3804  
 TRANSFER DATE: 07-12-2007  
 FIELD CORRECTION DATE: 11-15-2006  
 CORRECTIONS TRANSFERRED BY: BEM  
 FIELD CORRECTIONS BY: A. Amboye  
**NO AS BUILT CORRECTIONS**

**STANDARD PLANS DATED JULY 2004**


SHEET NO.	TITLE
A10A	ABBREVIATIONS (A-L)
A10B	ABBREVIATIONS (M-Z)
B0-5	BRIDGE DETAILS
RSP B6-21	JOINT SEALS (MAXIMUM MOVEMENT RATING = 50 MM)

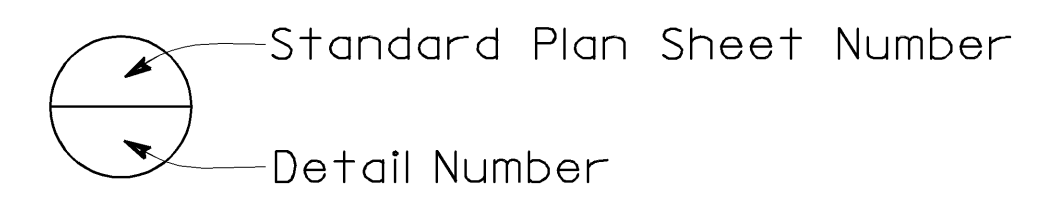

- NOTES:**
- Remove existing Precast P/S Concrete I Girder and install new Precast I/P/S Girder.
  - Remove and install overhead sign and vertical clearance sign.
  - Temporary Railing (Type K), see "ROAD PLANS".
  - Existing Pipe Railing.
  - Existing Barrier Railing Type I.

**INDEX TO PLANS**

SHEET NO.	TITLE
1	GENERAL PLAN
2	DETAILS NO. 1
3	DETAILS NO. 2
4	DETAILS NO. 3
5	PRESTRESSED "I" GIRDER DETAILS
6	BARRIER RAILING TYPE 1 DETAILS
7	SIGN DETAIL

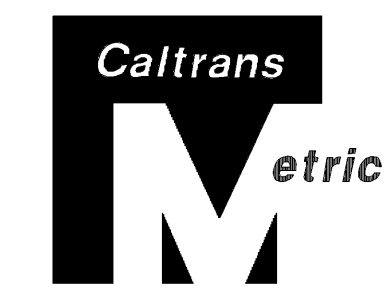


DIST	COUNTY	ROUTE	KILOMETER POST TOTAL PROJECT	SHEET No	TOTAL SHEETS
07	LA	101	54.2	13	19

**Michael J. Lee**  
 REGISTERED CIVIL ENGINEER  
 No. C 42447  
 Exp. 3-31-08  
 CIVIL  
 STATE OF CALIFORNIA


3-20-06  
 PLANS APPROVAL DATE

The State of California or its officers or agents shall not be responsible for the accuracy or completeness of electronic copies of this plan sheet.

Caltrans now has a web site! To get to this site, go to: <http://www.dot.ca.gov>

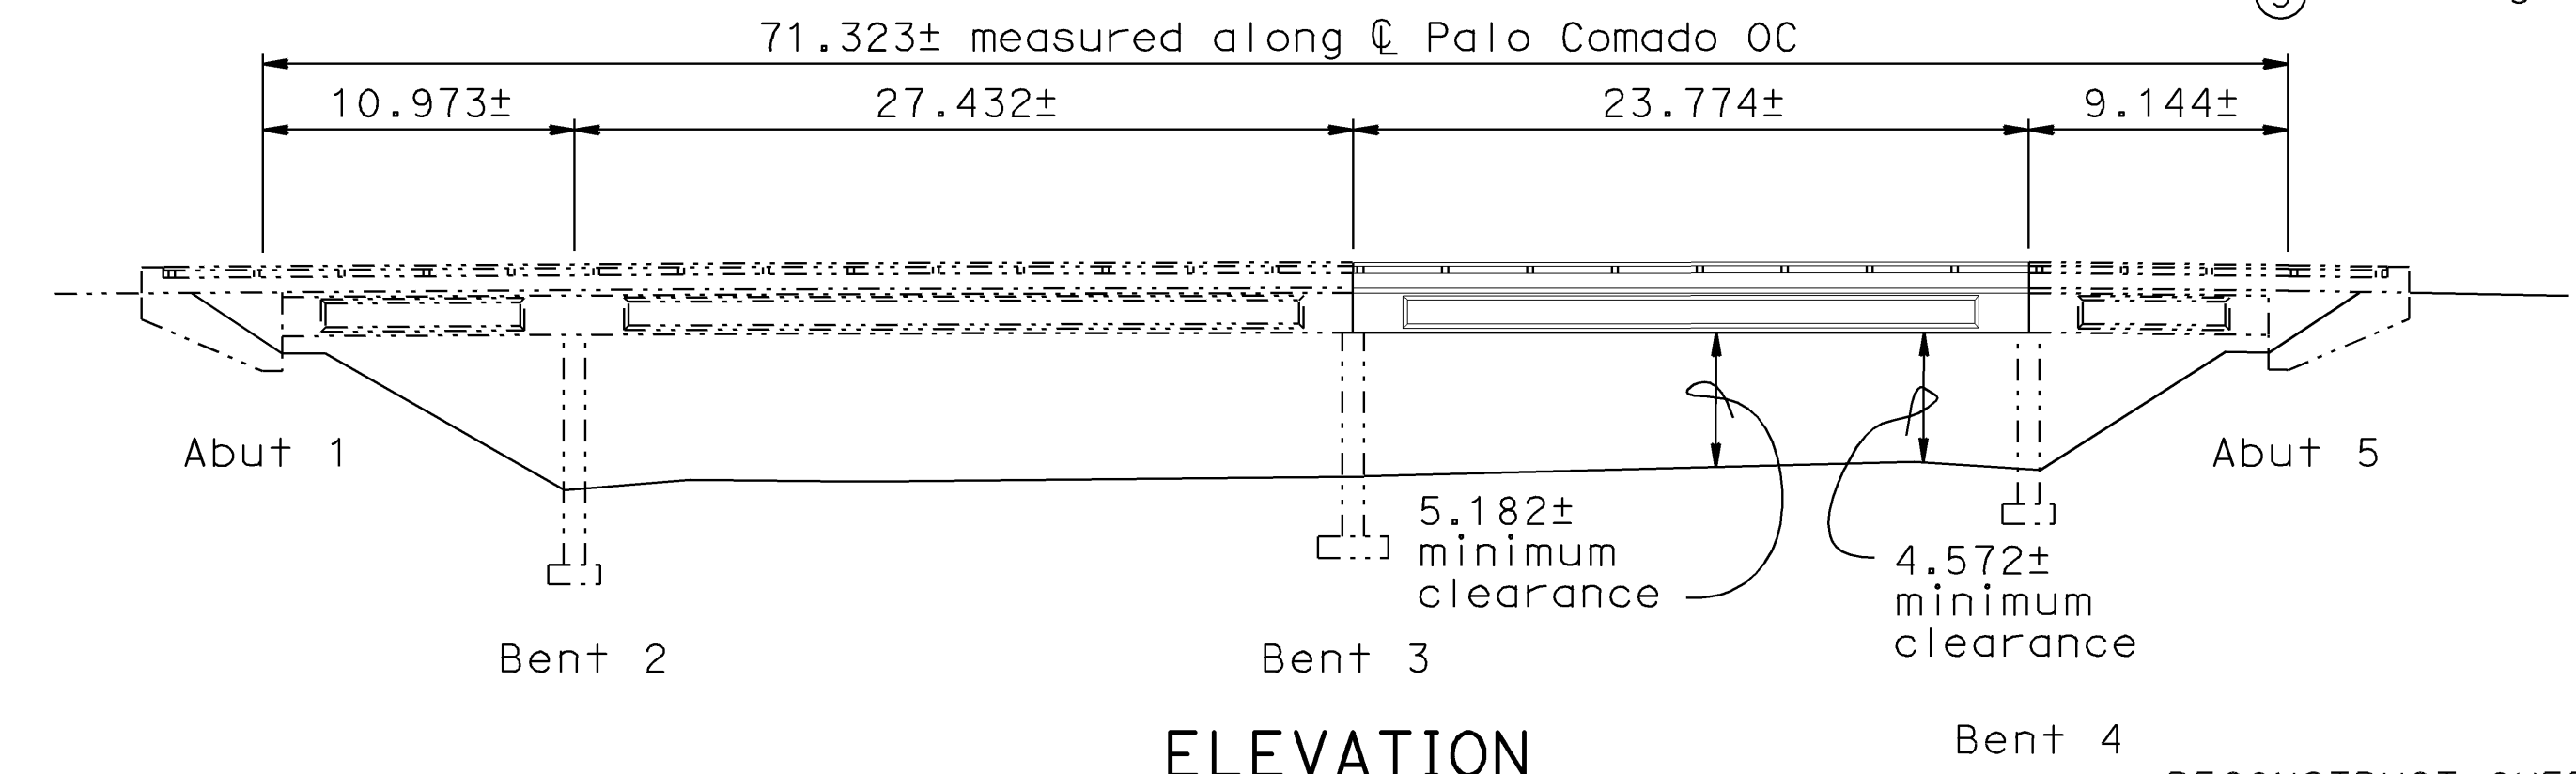

**ELEVATION**  
1:250

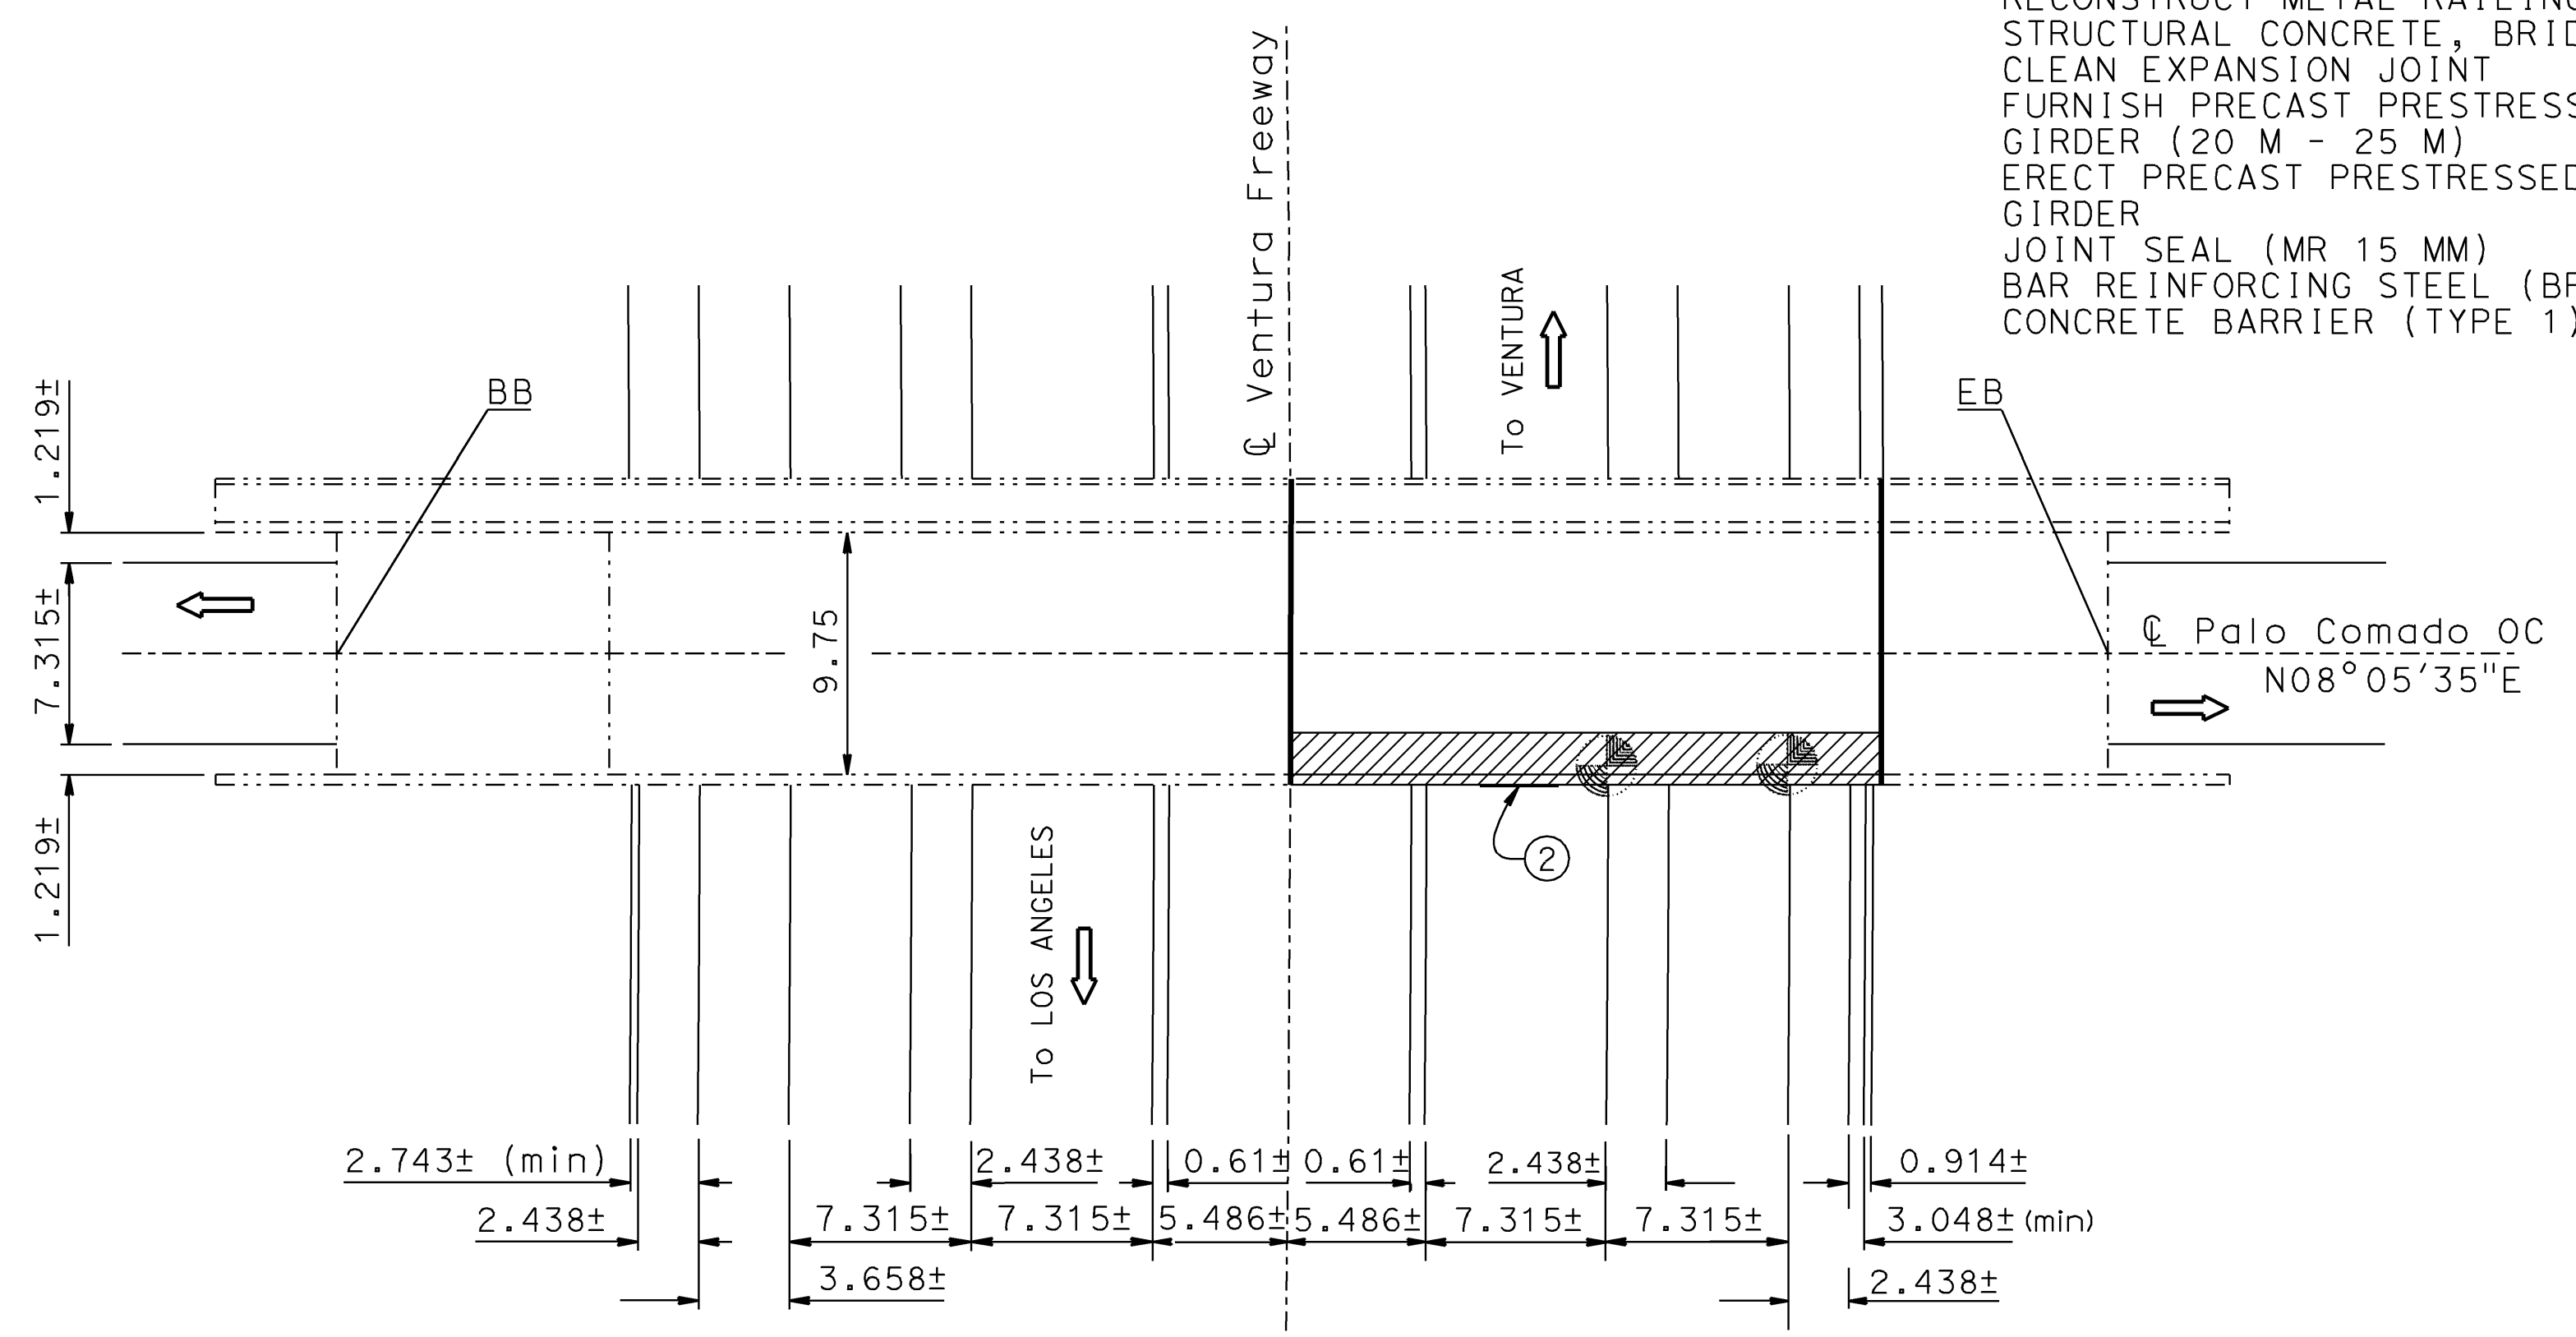

**PLAN**  
1:250


**NOTE:**  
THE CONTRACTOR SHALL VERIFY ALL CONTROLLING FIELD DIMENSIONS BEFORE ORDERING OR FABRICATING ANY MATERIAL.

**QUANTITIES**

RECONSTRUCT OVERHEAD SIGN STRUCTURE (BRIDGE MOUNTED)	
BRIDGE REMOVAL (PORTION)	
RECONSTRUCT METAL RAILING (BRIDGE)	
STRUCTURAL CONCRETE, BRIDGE	
CLEAN EXPANSION JOINT	
FURNISH PRECAST PRESTRESSED CONCRETE GIRDER (20 M - 25 M)	
ERECT PRECAST PRESTRESSED CONCRETE GIRDER	1 EA
JOINT SEAL (MR 15 MM)	24 m
BAR REINFORCING STEEL (BRIDGE)	1 420 kg
CONCRETE BARRIER (TYPE 1)	24 m

**LUMP SUM**

RECONSTRUCT METAL RAILING (BRIDGE)	24 m
STRUCTURAL CONCRETE, BRIDGE	10 m <sup>3</sup>
CLEAN EXPANSION JOINT	24 m
FURNISH PRECAST PRESTRESSED CONCRETE GIRDER (20 M - 25 M)	1 EA
ERECT PRECAST PRESTRESSED CONCRETE GIRDER	1 EA
JOINT SEAL (MR 15 MM)	24 m
BAR REINFORCING STEEL (BRIDGE)	1 420 kg
CONCRETE BARRIER (TYPE 1)	24 m

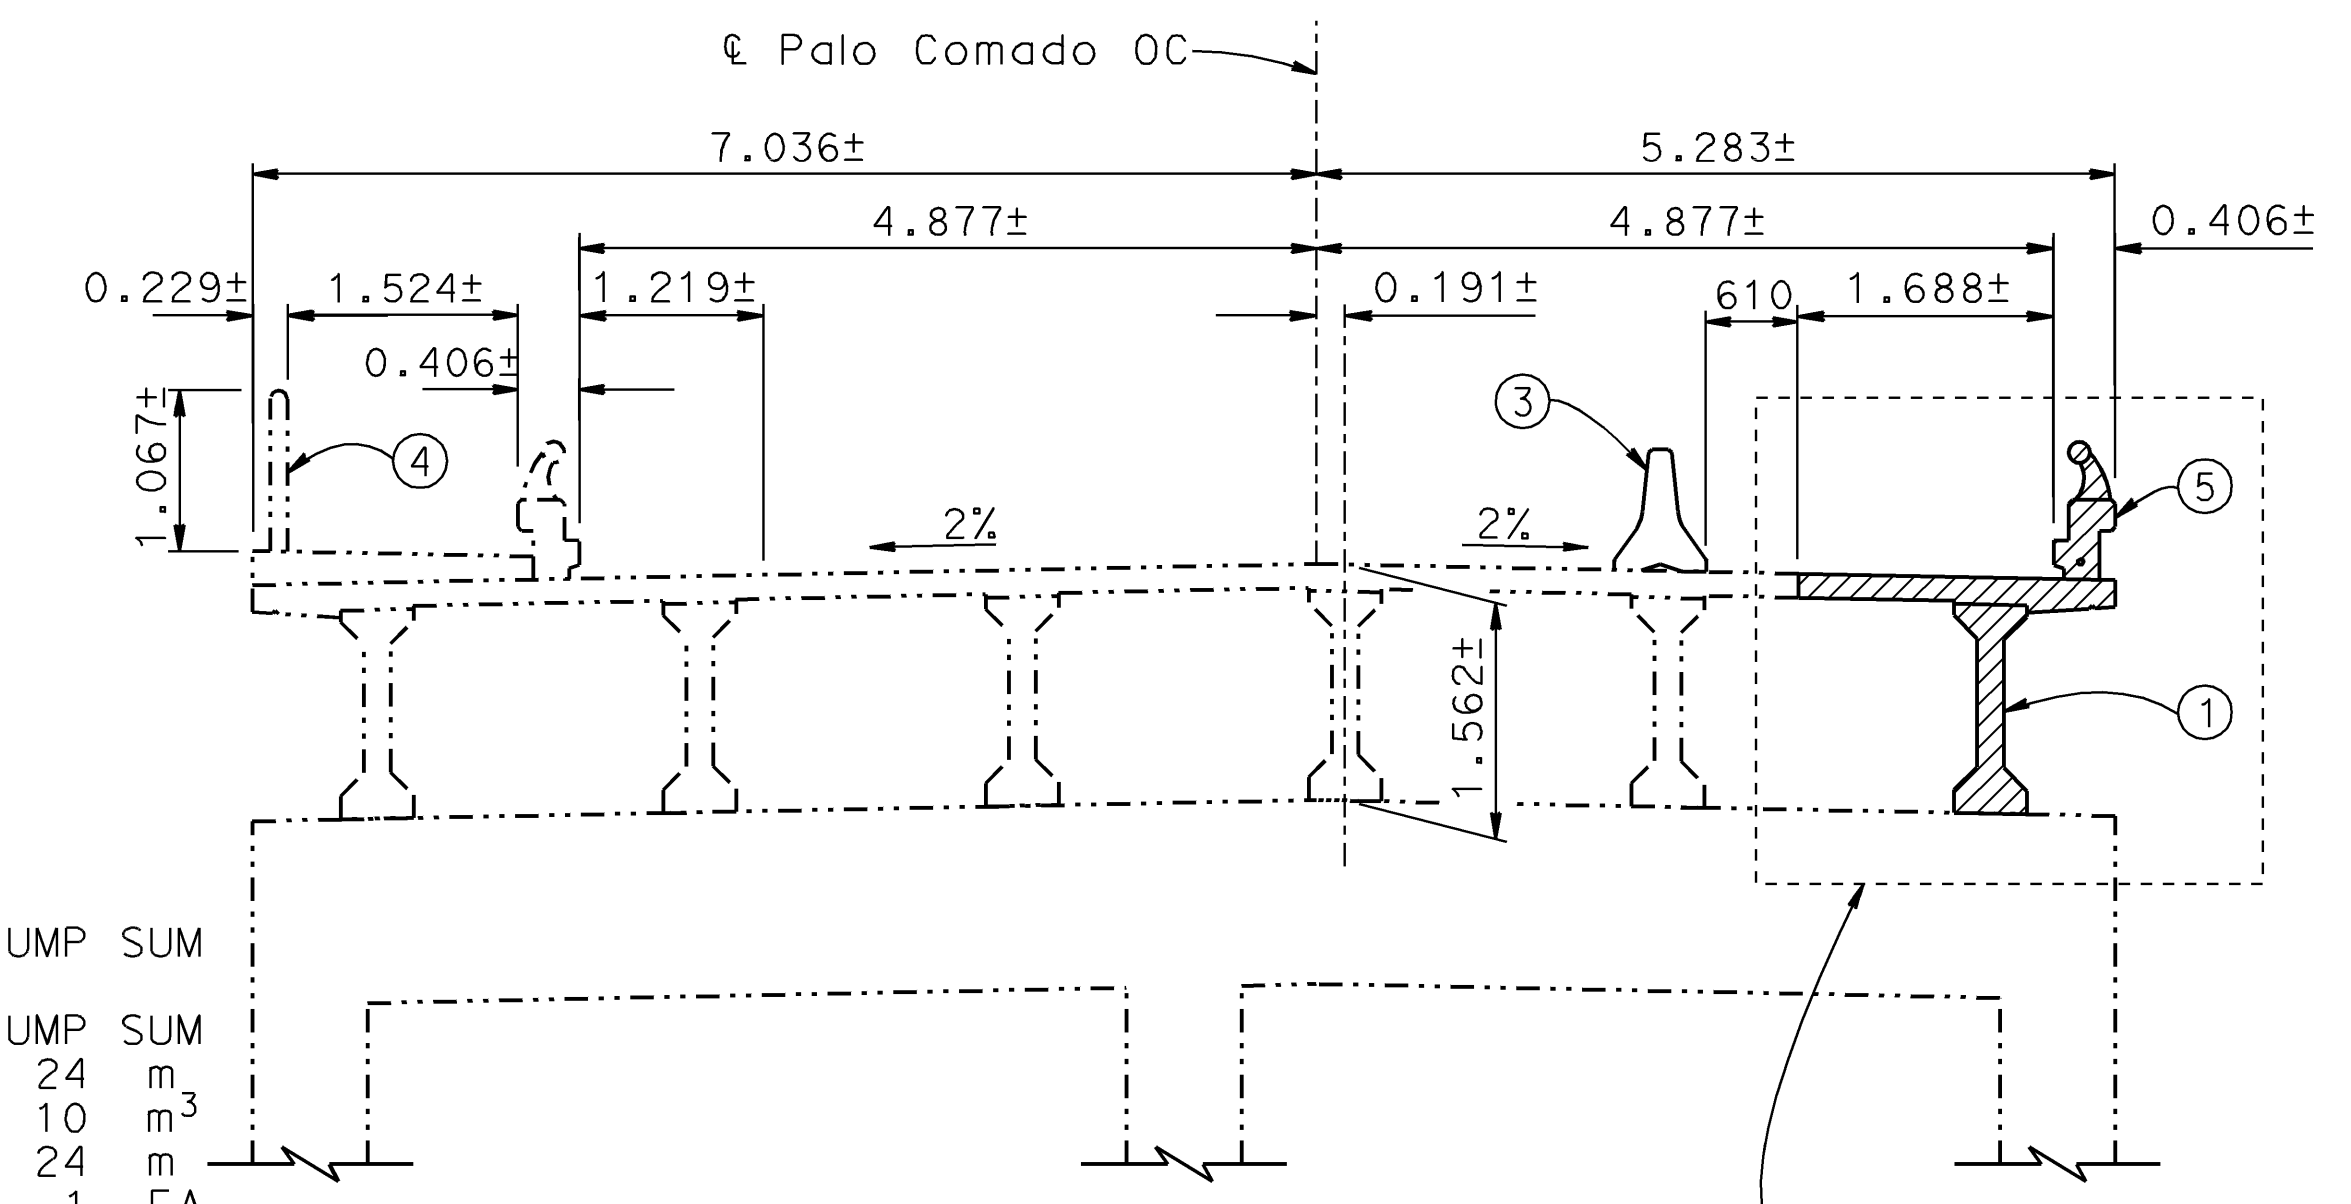

**TYPICAL SECTION**  
1:50

Similar to detail on "DETAILS NO. 1" sheet

**LEGEND:**

- Indicates limits of existing concrete deck, barrier railing and metal tube railing removal and placement of new concrete barrier railing and reinstall existing metal tube railing.
- Indicates existing structure.
- Indicates removal of existing joint seal, clean expansion joint (depth 150± mm) and place new joint seal. There is a waterstop. For details not shown, see RSP B6-21
- Indicates point of Minimum Vertical Clearance.

**GENERAL NOTES**  
**LOAD FACTOR DESIGN**

- DESIGN:** CALTRANS BRIDGE DESIGN SPECIFICATIONS LFD Version April 2000 (1996 AASHTO with Interims and Revision by Caltrans)
- SEISMIC DESIGN:** CALTRANS SEISMIC DESIGN CRITERIA (SDC) Version 1.3, February 2004
- DEAD LOAD:** Includes 1675 Pa for future wearing surface. The deck dead load between the girders has been increased by a factor of 10 percent to allow for the use of steel deck forms.
- LIVE LOAD:** HS20-44 and Alternative and Permit Design Load
- REINFORCED CONCRETE:**  $f_y = 420$  MPa  
 $f'_c = 25$  MPa  
 $n = 8$
- PRESTRESSED CONCRETE:** See "PRESTRESSED "I" GIRDER DETAILS" sheet.
- Transverse Deck Slabs (Working Stress):**  
 $f_s = 137.9$  MPa  
 $f_c = 8.3$  MPa  
 $n = 10$

ALL DIMENSIONS ARE IN METERS UNLESS OTHERWISE SHOWN

 3-20-06 DESIGN ENGINEER	DESIGN	BY Rangina Amir	CHECKED Arlene Frank	LAYOUT	BY Roelina Martinez	CHECKED Arlene Frank
	DETAILS	BY Roelina Martinez	CHECKED Arlene Frank	SPECIFICATIONS	BY Lien Vu	PLANS AND SPECS COMPARED Lien Vu
	QUANTITIES	BY Rangina Amir	CHECKED Arlene Frank			


**STATE OF CALIFORNIA**  
 DEPARTMENT OF TRANSPORTATION

**DIVISION OF MAINTENANCE**  
 STRUCTURE MAINTENANCE DESIGN

BRIDGE NO. 53-1678  
 KILOMETER POST 54.2

**PALO COMADO OC**  
 GENERAL PLAN

SHEET 1 OF 7

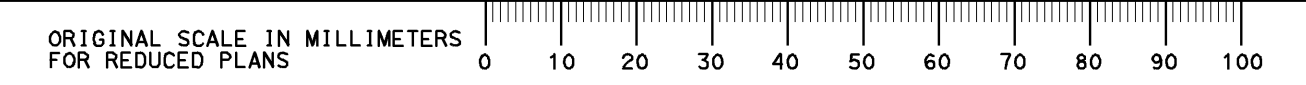


CU 07  
EA 4K3801


REVISION DATES (PRELIMINARY STAGE ONLY)	SHEET	OF
7-25-05 10-02-05 10-05-05	1	7

USERNAME => bml1ter DATE PLOTTED => 25-JUL-2007 TIME PLOTTED => 16:02

**NO AS BUILT CORRECTIONS**  
 CORRECTIONS TRANSFERRED BY: BEM A. Amboye  
 FIELD CORRECTIONS BY:  
 TRANSFER DATE: 07-12-2007  
 FIELD CORRECTION DATE: 11-15-2006  
 CONTRACT NO: 07-4K3804

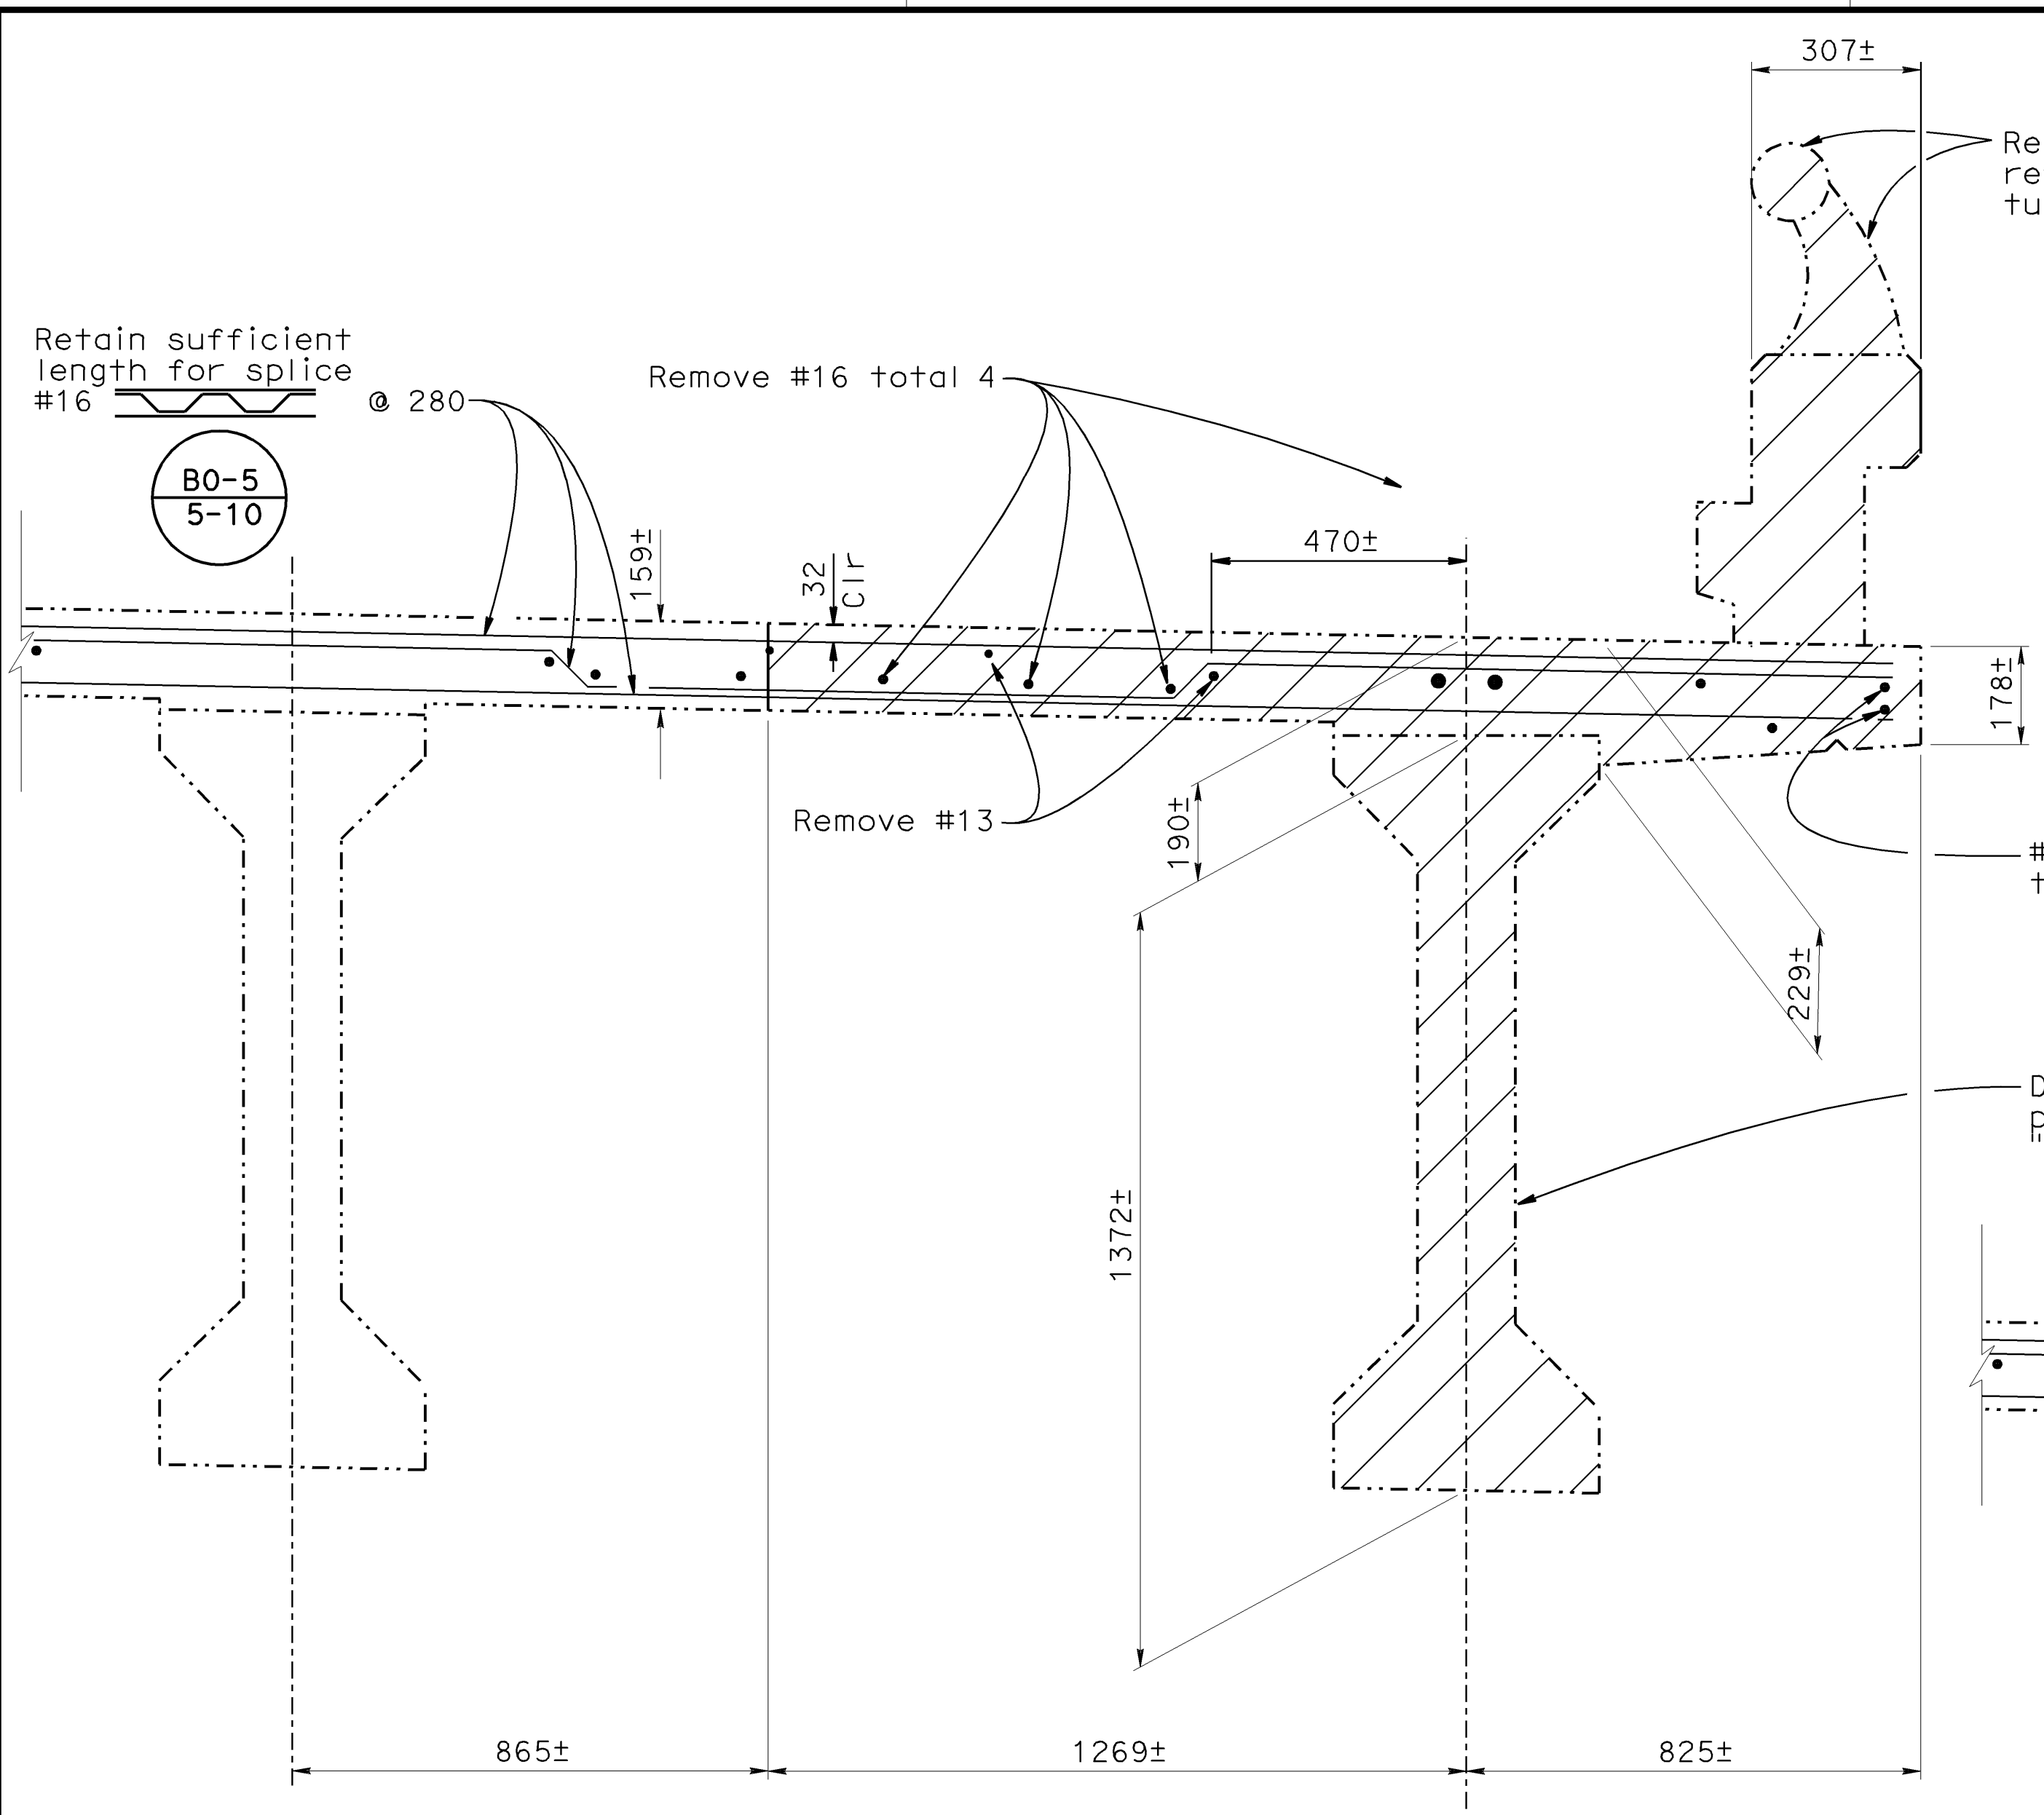

**EXISTING - PARTIAL TYPICAL SECTION**  
1:10

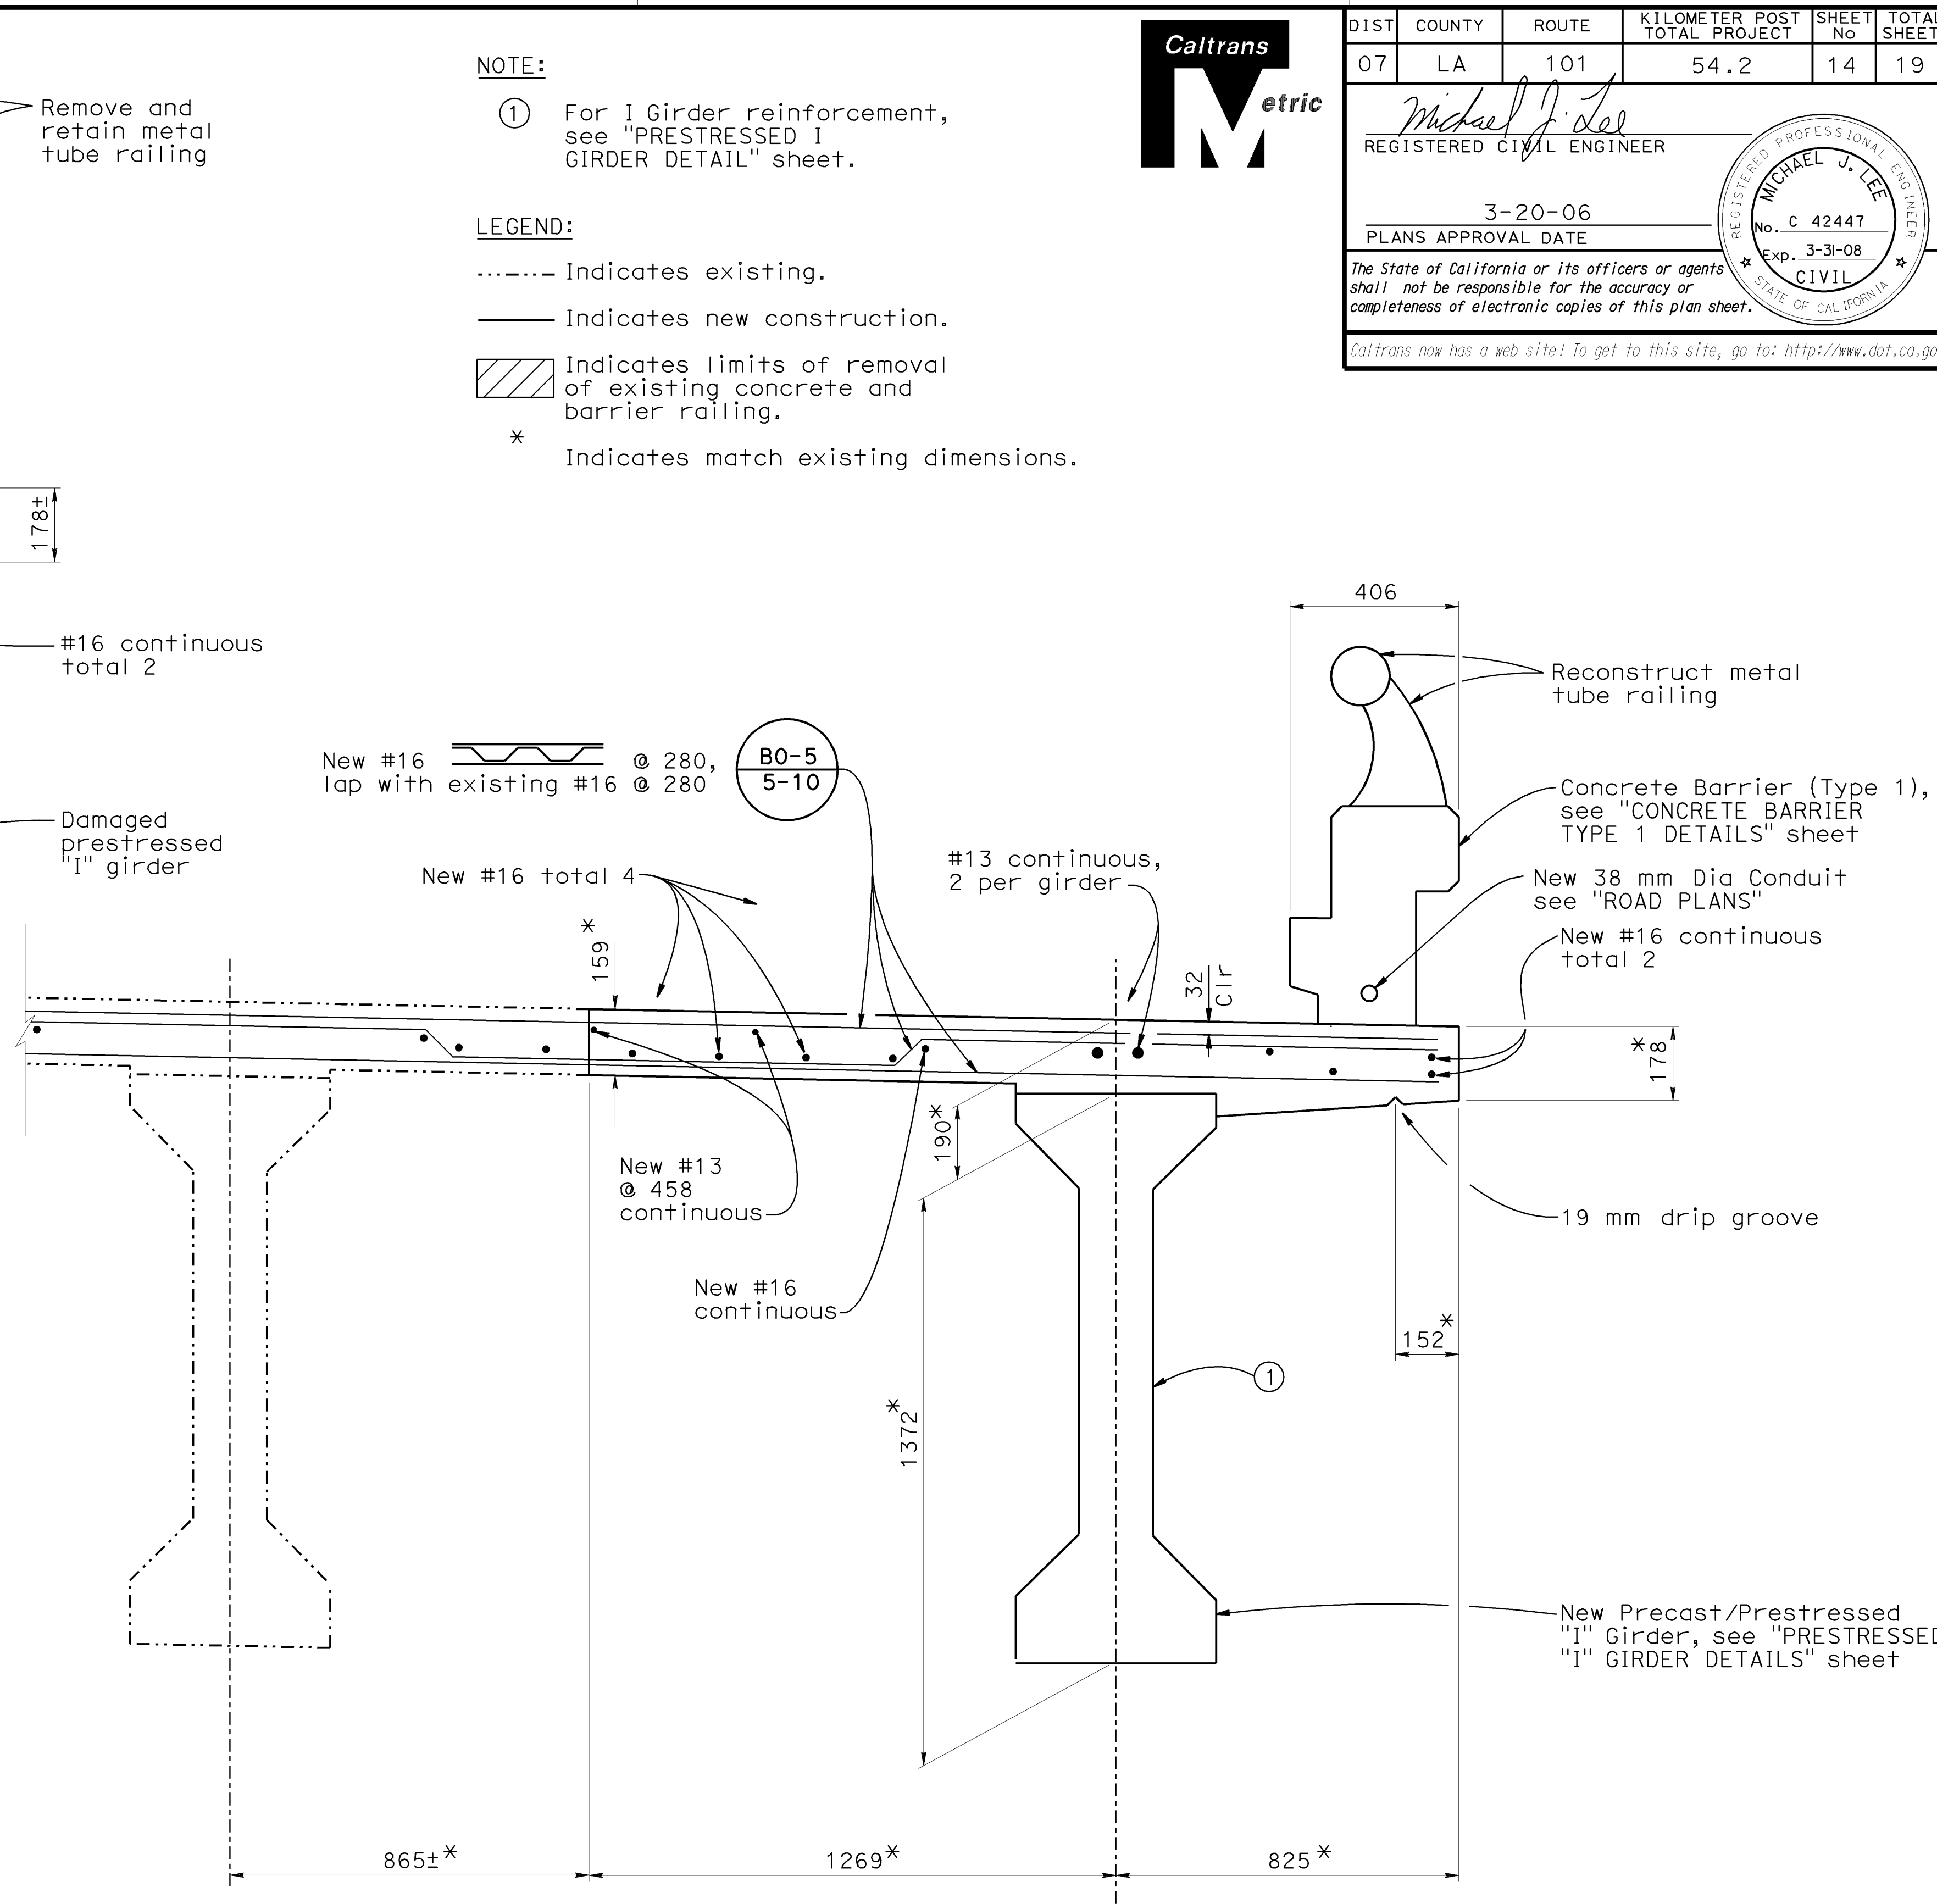

**RECONSTRUCTION - PARTIAL TYPICAL SECTION**  
1:10

**NOTE:**  
 ① For I Girder reinforcement, see "PRESTRESSED I GIRDER DETAIL" sheet.

**LEGEND:**  
 - - - - - Indicates existing.  
 ———— Indicates new construction.  
 [Hatched Area] Indicates limits of removal of existing concrete and barrier railing.  
 \* Indicates match existing dimensions.

**Caltrans**  
**Metric**

DIST	COUNTY	ROUTE	KILOMETER POST TOTAL PROJECT	SHEET No	TOTAL SHEETS
07	LA	101	54.2	14	19

Michael J. Lee  
REGISTERED CIVIL ENGINEER

3-20-06  
PLANS APPROVAL DATE

No. C 42447  
Exp. 3-31-08  
CIVIL  
STATE OF CALIFORNIA

*The State of California or its officers or agents shall not be responsible for the accuracy or completeness of electronic copies of this plan sheet.*

Caltrans now has a web site! To get to this site, go to: <http://www.dot.ca.gov>

**NOTE:**  
 THE CONTRACTOR SHALL VERIFY ALL CONTROLLING FIELD DIMENSIONS BEFORE ORDERING OR FABRICATING ANY MATERIAL.


ALL DIMENSIONS ARE IN MILLIMETERS UNLESS OTHERWISE SHOWN

DESIGN BY Rangina Amir	CHECKED Arlene Frank	STATE OF CALIFORNIA DEPARTMENT OF TRANSPORTATION	DIVISION OF MAINTENANCE STRUCTURE MAINTENANCE DESIGN	BRIDGE NO. 53-1678	PALO COMADO OC DETAILS NO.1
DETAILS BY Roelina Martinez	CHECKED Arlene Frank		KILOMETER POST 54.2		
QUANTITIES BY Rangina Amir	CHECKED Arlene Frank		CU 07 EA 4K3801	DISREGARD PRINTS BEARING EARLIER REVISION DATES	

ORIGINAL SCALE IN MILLIMETERS FOR REDUCED PLANS: 0 10 20 30 40 50 60 70 80 90 100


FILE => 074k38002de+1.dgn

**NO AS BUILT CORRECTIONS**  
 CORRECTIONS TRANSFERRED BY: BEM  
 FIELD CORRECTIONS BY: A. Amoye  
 TRANSFER DATE: 07-12-2007  
 FIELD CORRECTION DATE: 11-15-2006  
 CONTRACT NO: 07-4K3804

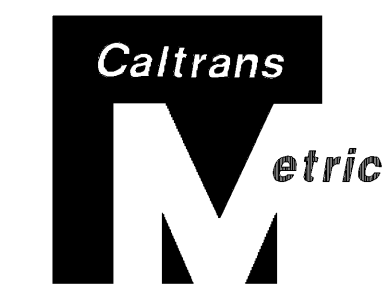


DIST	COUNTY	ROUTE	KILOMETER POST TOTAL PROJECT	SHEET No	TOTAL SHEETS
07	LA	101	54.2	15	19


Michael J. Lee  
 REGISTERED CIVIL ENGINEER  
 3-20-06  
 PLANS APPROVAL DATE  
 No. C 42447  
 Exp. 3-31-08  
 CIVIL  
 STATE OF CALIFORNIA  
 The State of California or its officers or agents shall not be responsible for the accuracy or completeness of electronic copies of this plan sheet.  
 Caltrans now has a web site! To get to this site, go to: <http://www.dot.ca.gov>

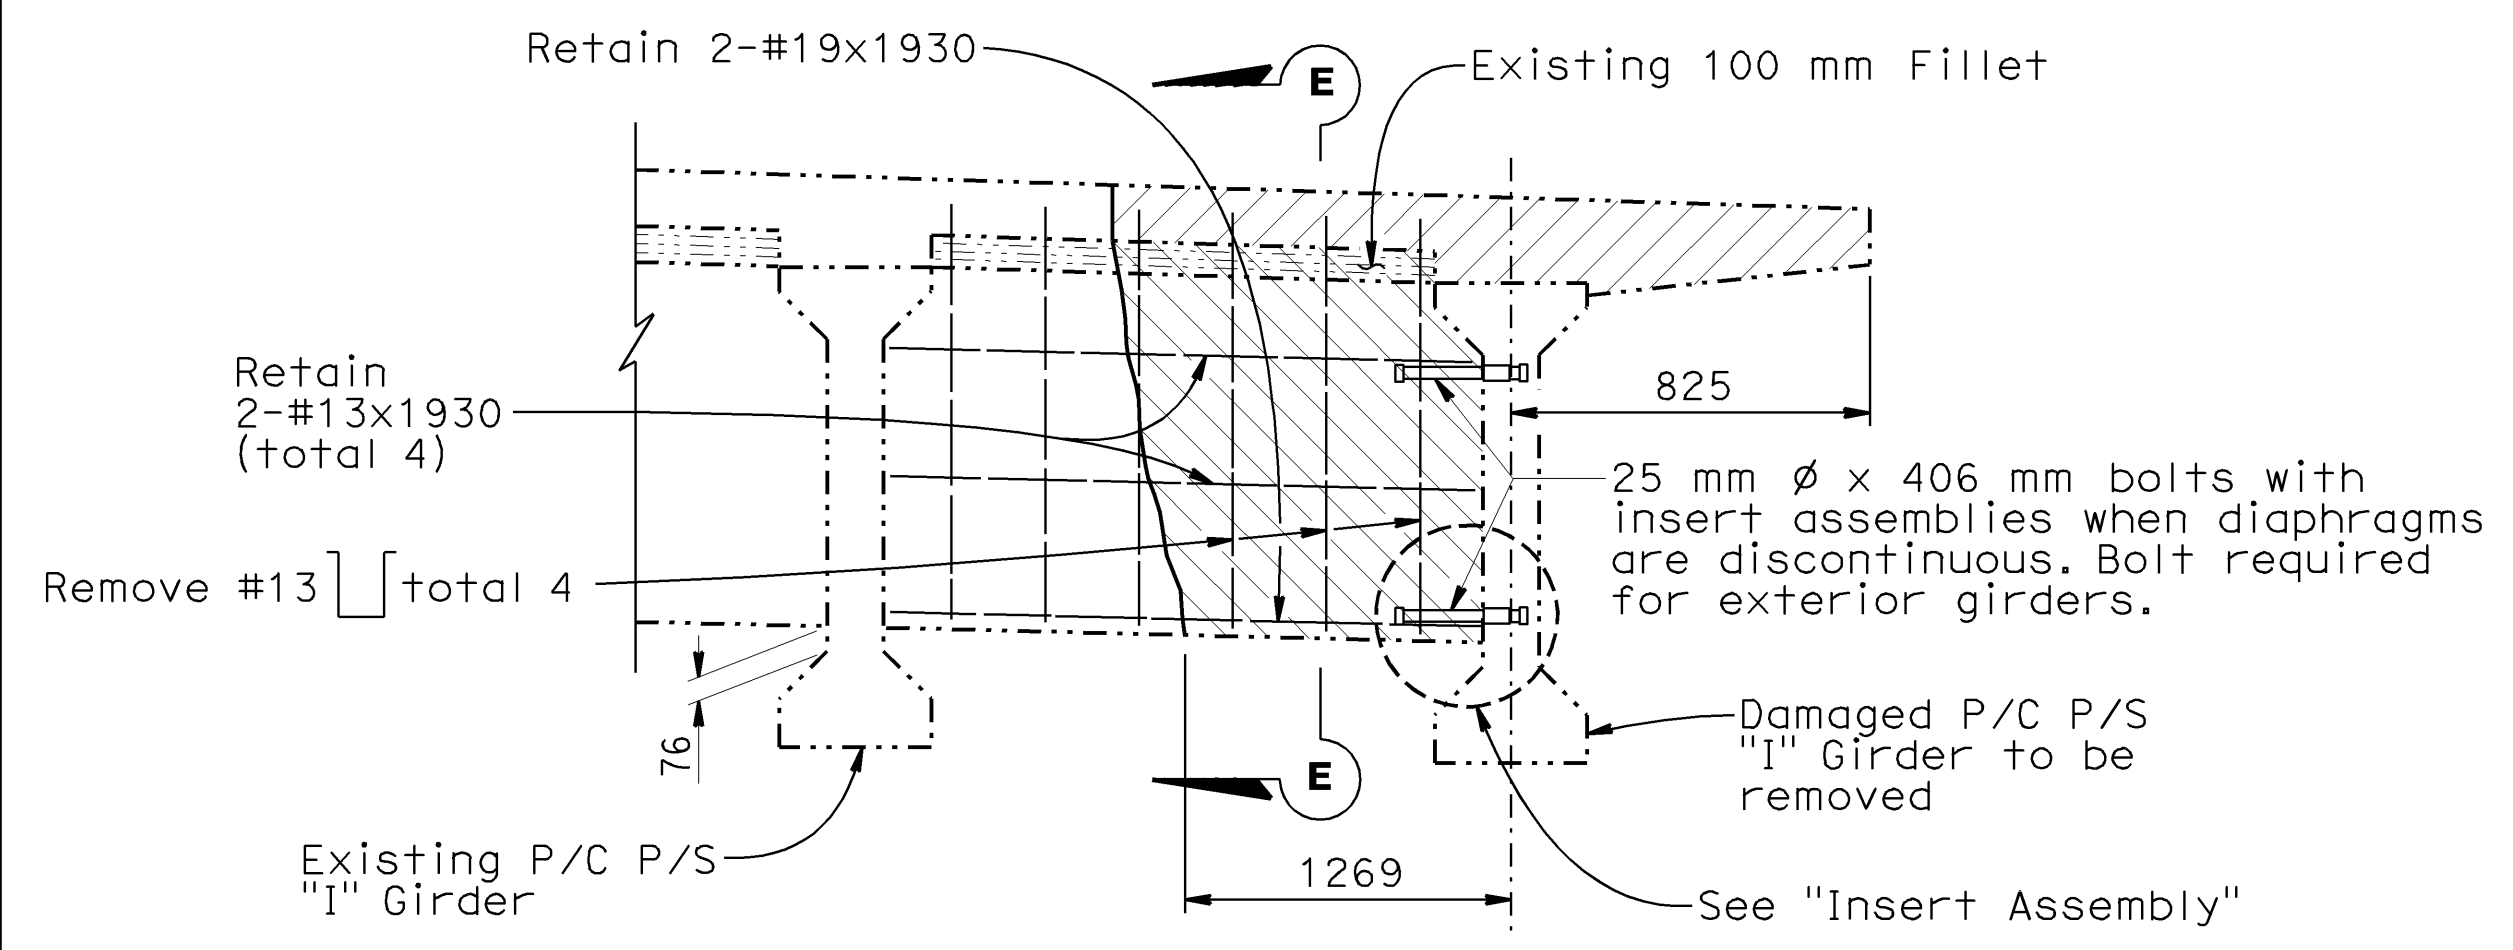


**EXISTING INTERMEDIATE DIAPHRAGM**  
No Scale

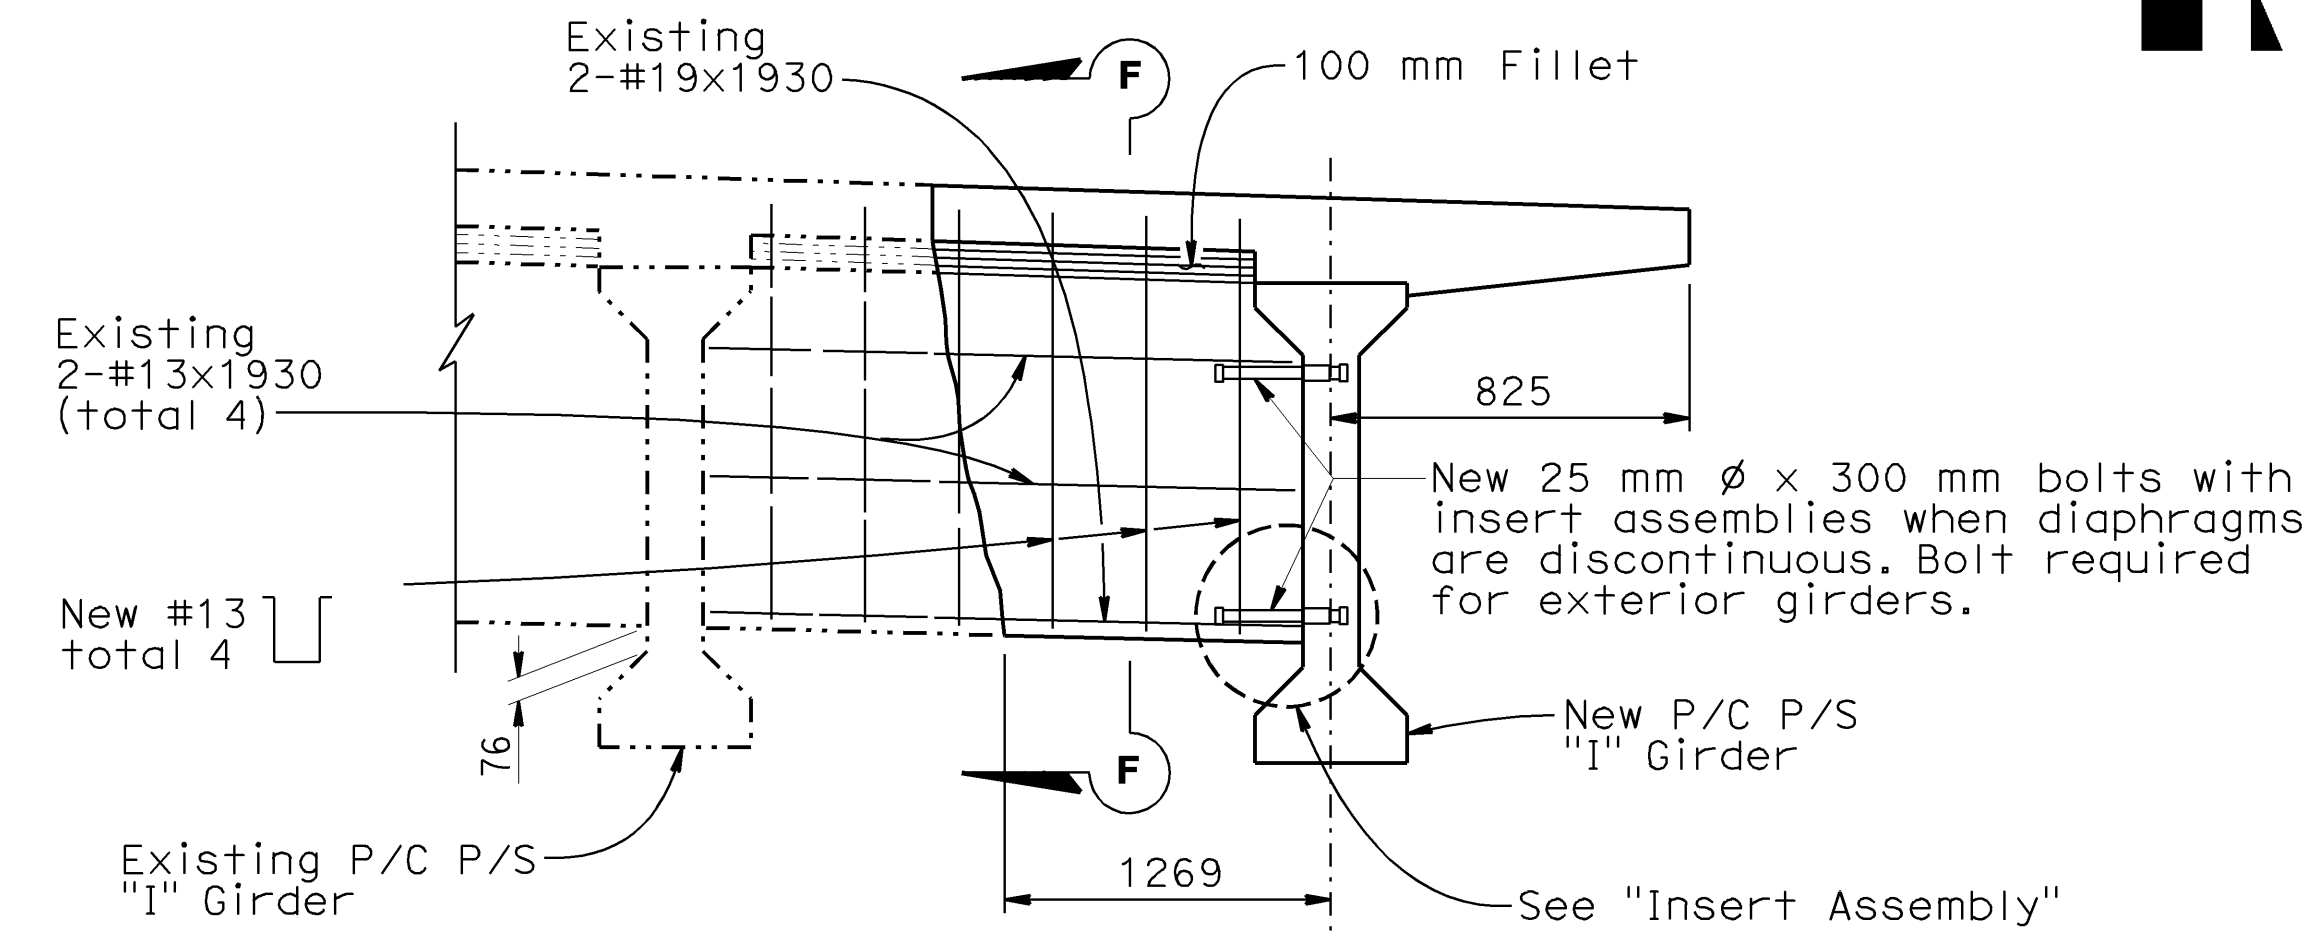


**RECONSTRUCTED INTERMEDIATE DIAPHRAGM**  
No Scale

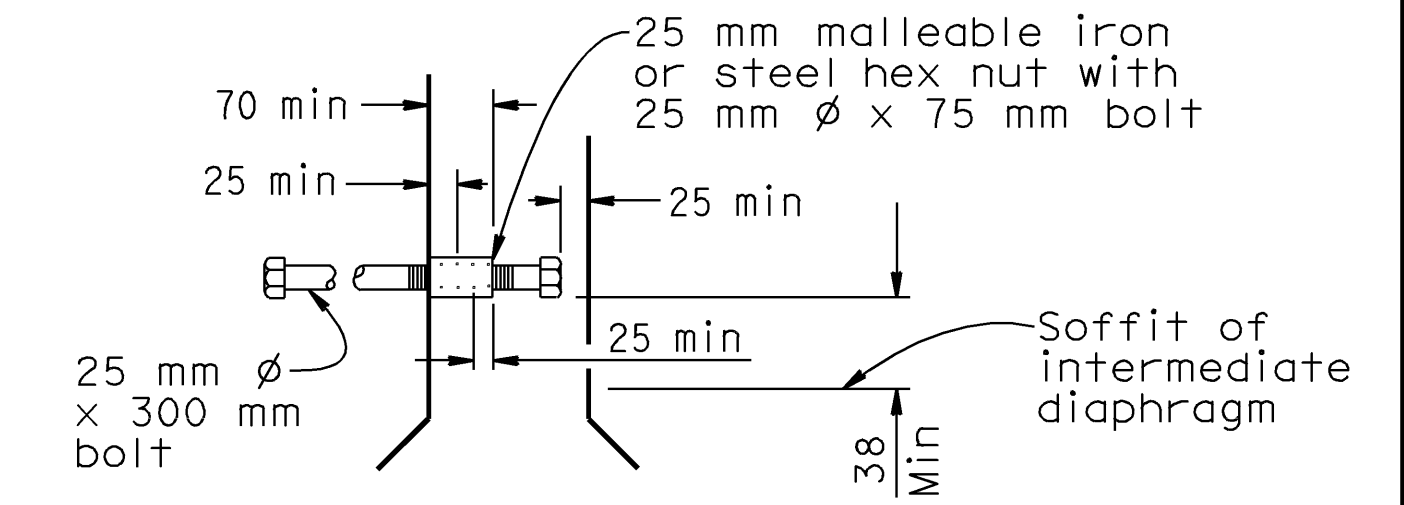


**INSERT ASSEMBLY**  
No Scale

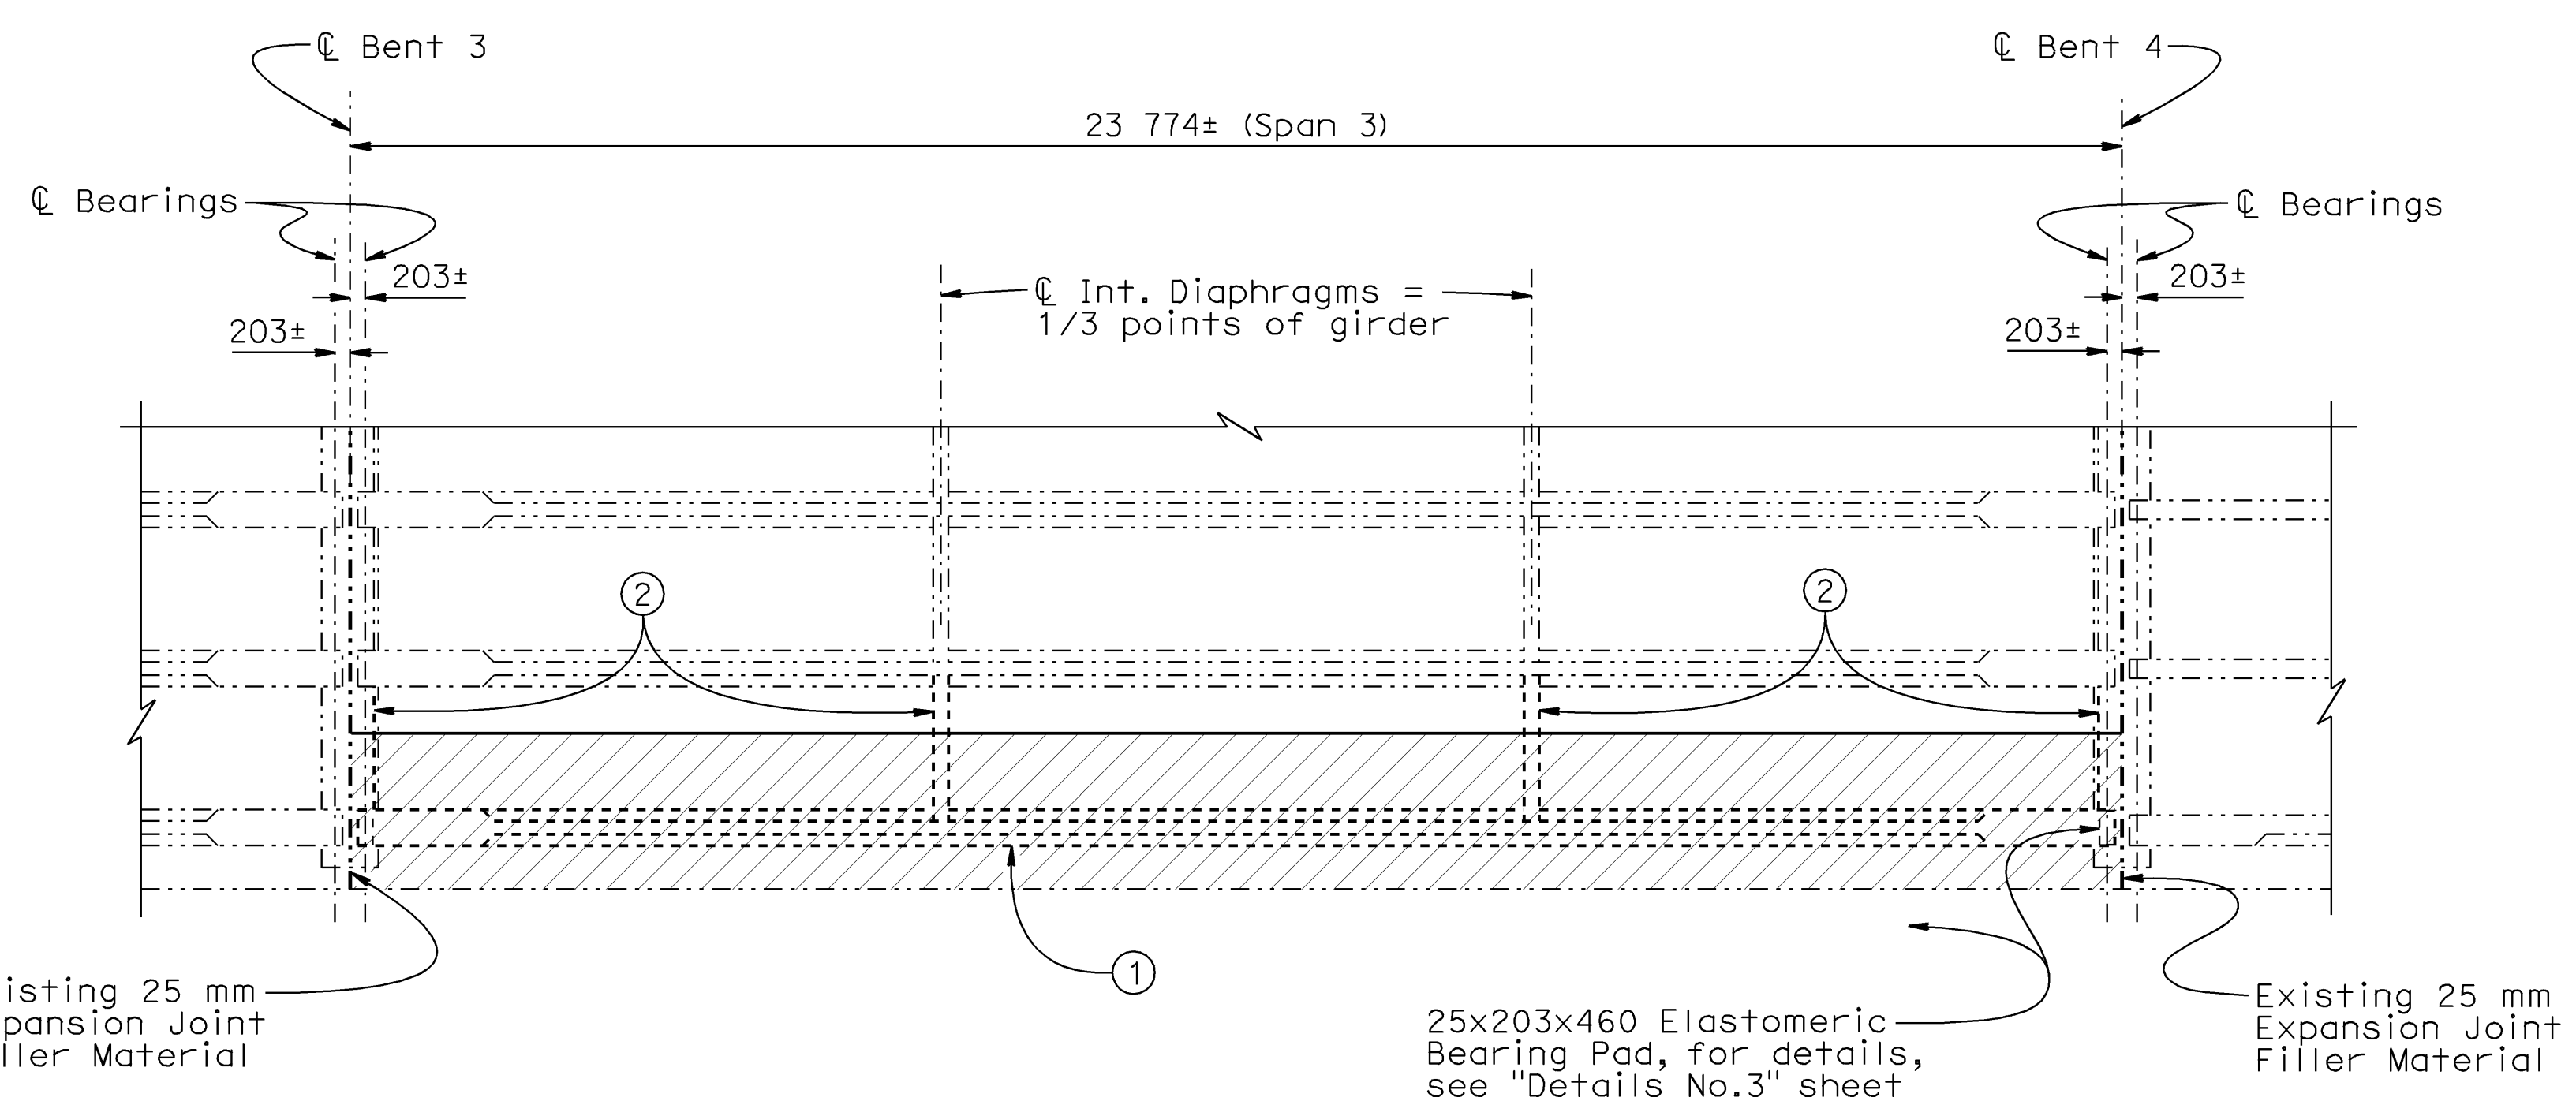

**PARTIAL PLAN - GIRDER LAYOUT (SPAN 3)**  
1:80

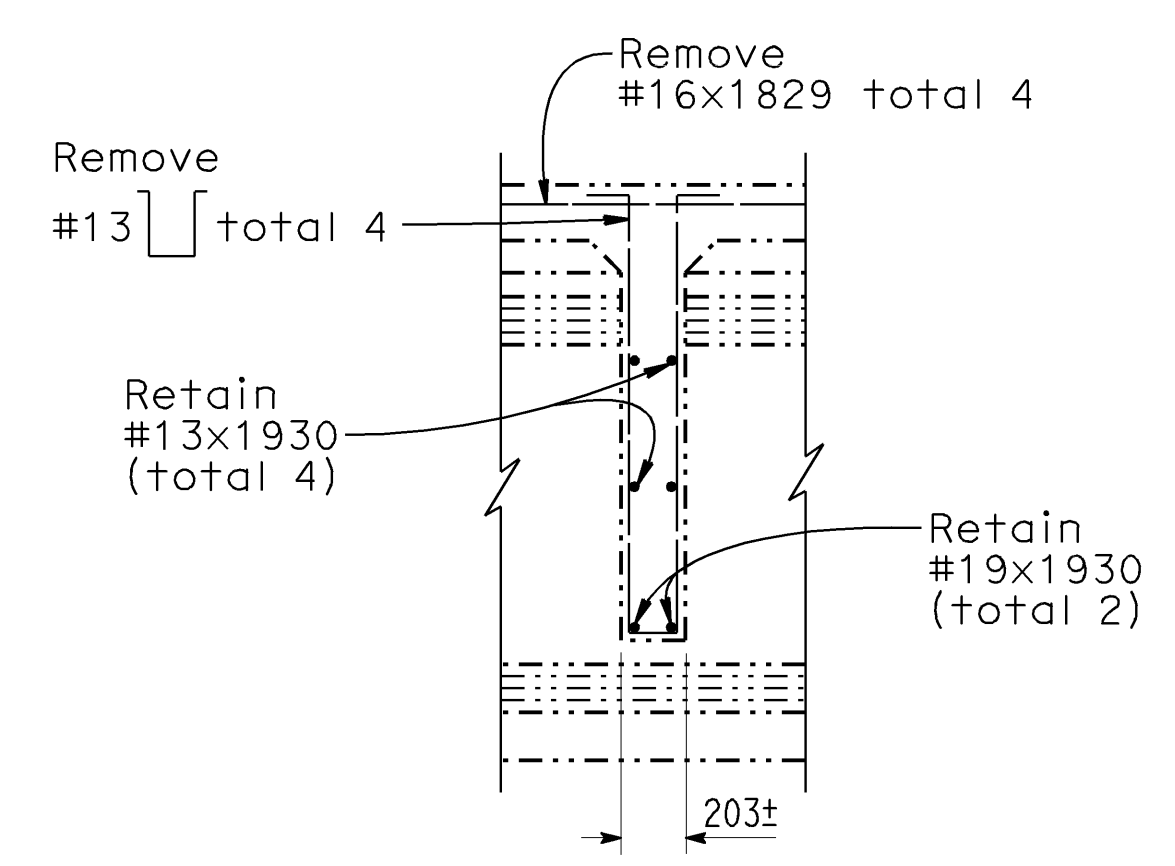

**SECTION E-E**  
No Scale

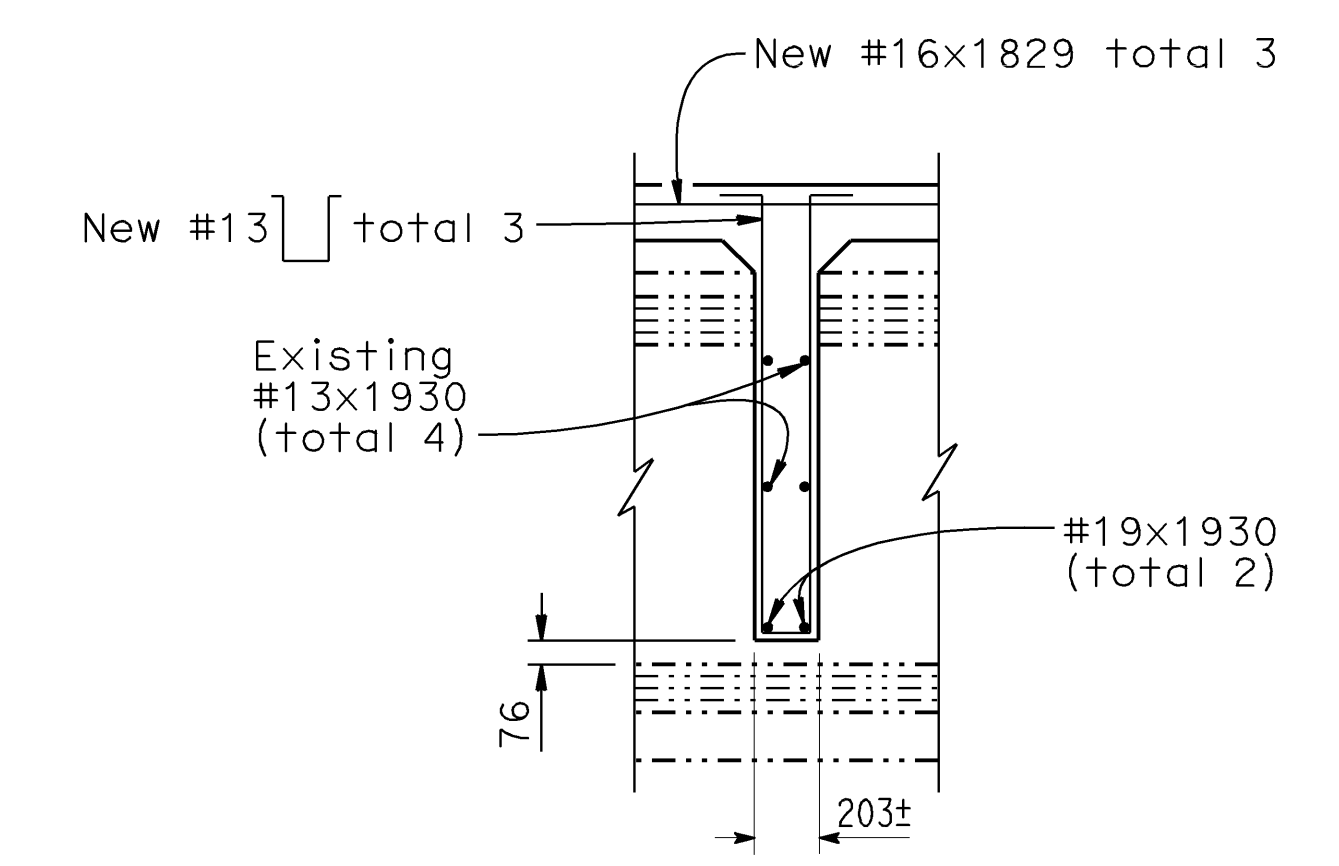

**SECTION F-F**  
No Scale

- Notes:**
- ① - Remove existing damaged Precast P/S Concrete "I" Girder and install new Precast P/S Concrete "I" Girder.
  - ② - Remove existing concrete diaphragm prior to removal of existing damaged girder and reconstruct concrete diaphragm after new girder is placed.
  - ▨ - Indicates Limits of Remove Concrete Deck.
  - ▩ - Indicates Limits of Remove Existing Concrete.

**NOTE:**  
THE CONTRACTOR SHALL VERIFY ALL CONTROLLING FIELD DIMENSIONS BEFORE ORDERING OR FABRICATING ANY MATERIAL.

ALL DIMENSIONS ARE IN MILLIMETERS UNLESS OTHERWISE SHOWN

DESIGN BY R. Amir	CHECKED A. Frank	<b>STATE OF CALIFORNIA</b> DEPARTMENT OF TRANSPORTATION	<b>DIVISION OF MAINTENANCE</b> STRUCTURE MAINTENANCE DESIGN	BRIDGE NO. 53-1678	<b>PALO COMADO OC</b> <b>DETAILS NO.2</b>
DETAILS BY D. Pato	CHECKED A. Frank			KILOMETER POST 54.2	
QUANTITIES BY R. Amir	CHECKED A. Frank				
ORIGINAL SCALE IN MILLIMETERS FOR REDUCED PLANS			CU 07 EA 4K3801	DISREGARD PRINTS BEARING EARLIER REVISION DATES	REVISION DATES (PRELIMINARY STAGE ONLY)
0 10 20 30 40 50 60 70 80 90 100			7-22-05	8-23-05	10-03-05
			FILE => 074k38003de#2.dgn		SHEET 3 OF 7



CONTRACT NO: 07-4K3804  
 TRANSFER DATE: 07-15-2007  
 FIELD CORRECTION DATE: 11-15-2006  
 CORRECTIONS TRANSFERRED BY: BEM  
 FIELD CORRECTIONS BY: A. Amoye  
**NO AS BUILT CORRECTIONS**  
 NO SCALE  
 ALL DIMENSIONS ARE IN MILLIMETERS UNLESS OTHERWISE SHOWN  
 NO AS BUILT CORRECTIONS

**Caltrans**  
**Metric**

DIST	COUNTY	ROUTE	KILOMETER TOTAL PROJECT	POST TOTAL PROJECT	SHEET No	TOTAL SHEETS
07	LA	101	54.2		17	19

*Michael J. Lee*  
REGISTERED CIVIL ENGINEER  
No. C 42447  
Exp. 3-31-08  
CIVIL  
STATE OF CALIFORNIA




3-20-06  
PLANS APPROVAL DATE

*The State of California or its officers or agents shall not be responsible for the accuracy or completeness of electronic copies of this plan sheet.*

Caltrans now has a web site! To get to this site, go to: <http://www.dot.ca.gov>

### CLEARANCES FOR PRETENSIONED STRANDS

1. Strands may be bundled in groups consisting of 3 vertically 2 horizontally, and separated at the ends.
2. The min distance "S" between groups or individual strands is 40 mm for 9.5 mm strands, 45 mm for 11 and 13 mm strands and 50 mm for 15 mm strands.
3. "S" is measured between centers of adjacent strands.
4. Approval of Engineer is required for deviation.

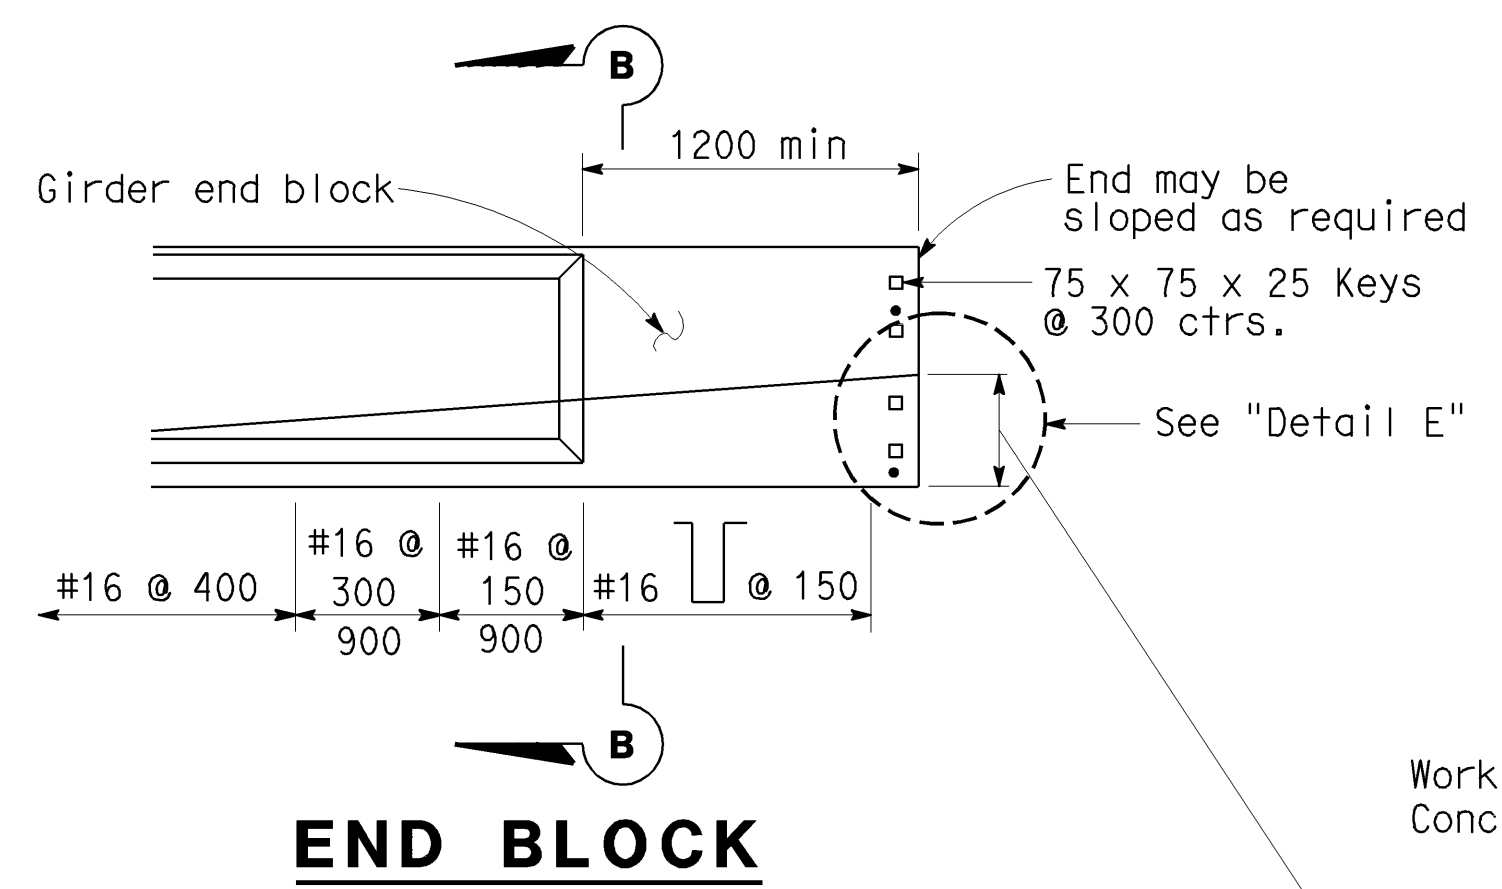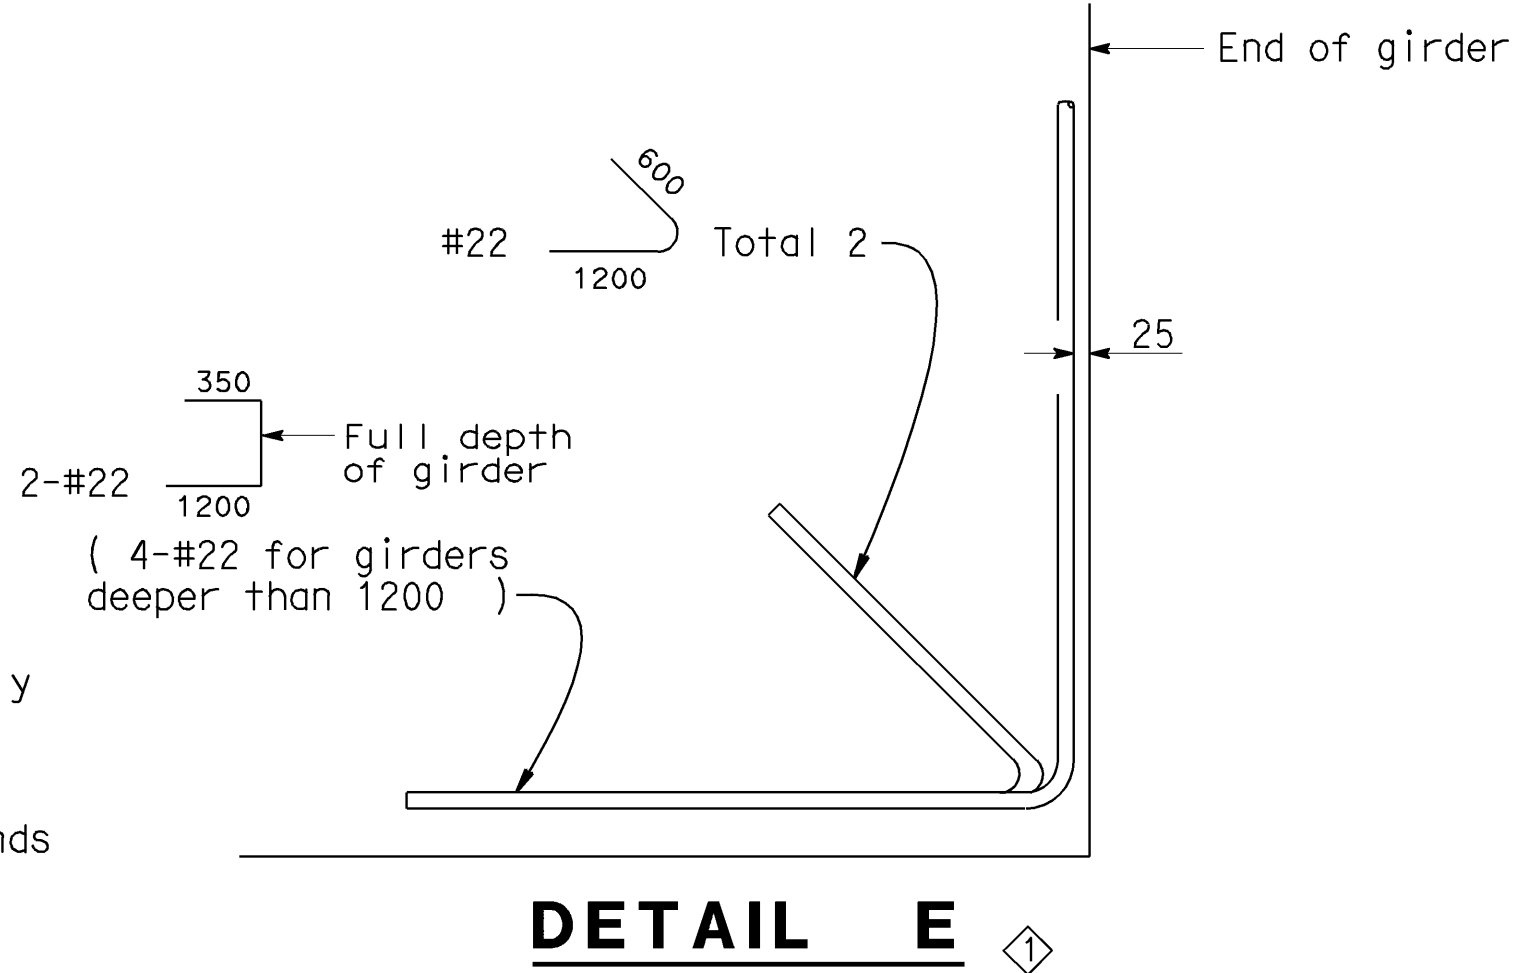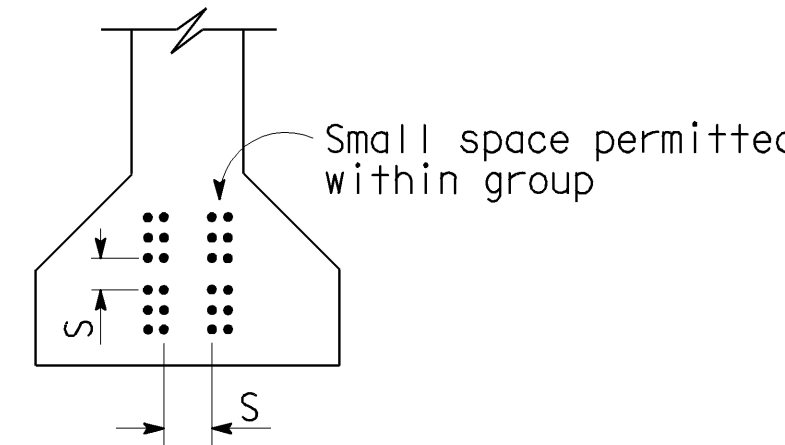


### PRESTRESSING NOTES

Working force : The force required at center of span after all losses.  
 Concrete strength :  $f'_{ci}$  is at time of initial stressing,  $f'_c$  is at 28 days, MPa.  
 Deflection components : Informational - to be used in setting screed line elevations.

Screed line elevations for deck concrete will be determined by the Engineer.





The Contractor may interpolate "P" and "X" values between limits shown, as approved by the Engineer.

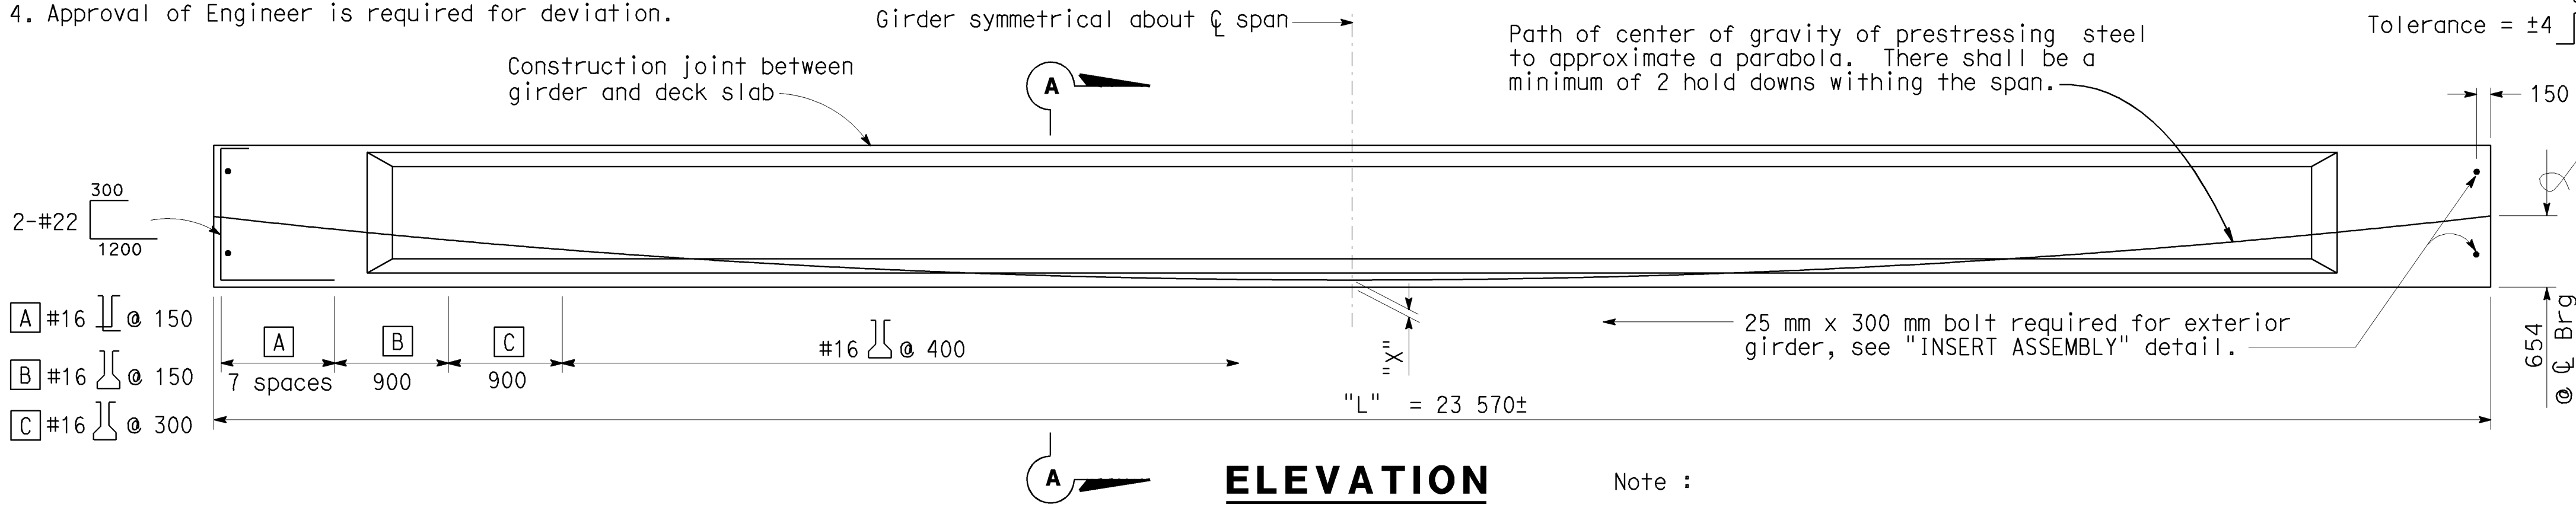

Girder location or designation and length	P = Working force in ( kN ) "X"	Concrete Strength		Deflection Components ( mm )	
		$f'_{ci}$	$f'_c$	① Deck DL	② Rail DL
23.57± m	76 1973	27.6	27.6	15.0	3.3
23.57± m	114 2060	27.6	27.6	15.0	3.3
23.57± m	152 2155	27.6	27.6	15.0	3.3

Note :  
 Details shown are for pretensioned girders. The Contractor may submit details for post-tensioning which shall meet the approval of the Engineer.

② - Deleted Detail

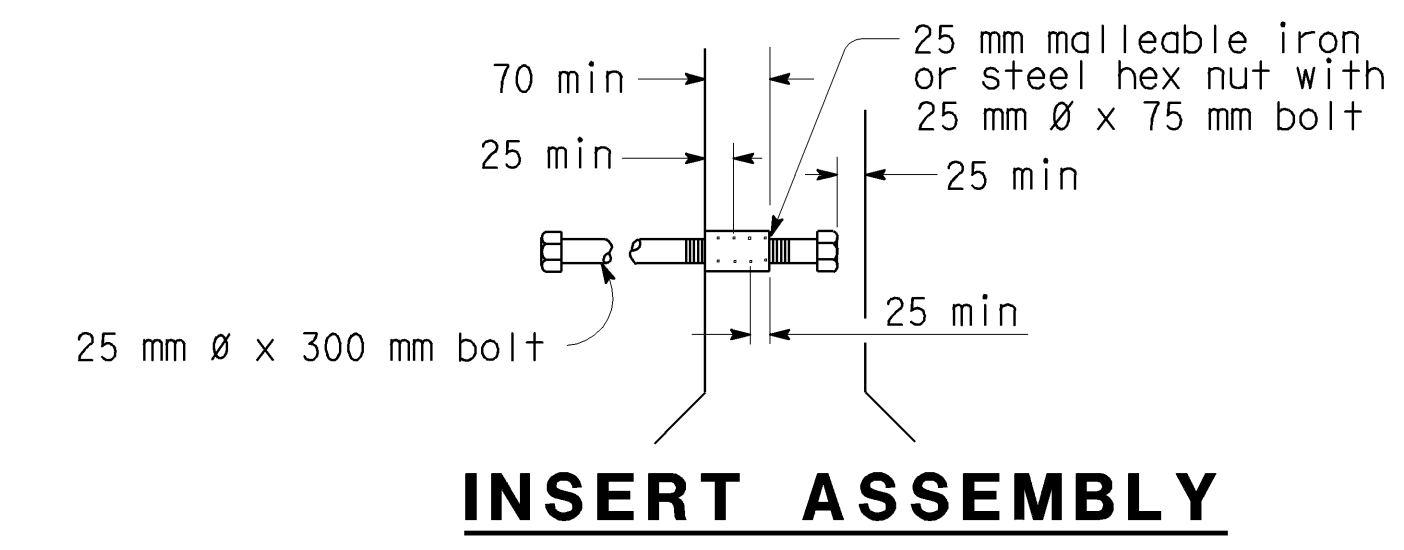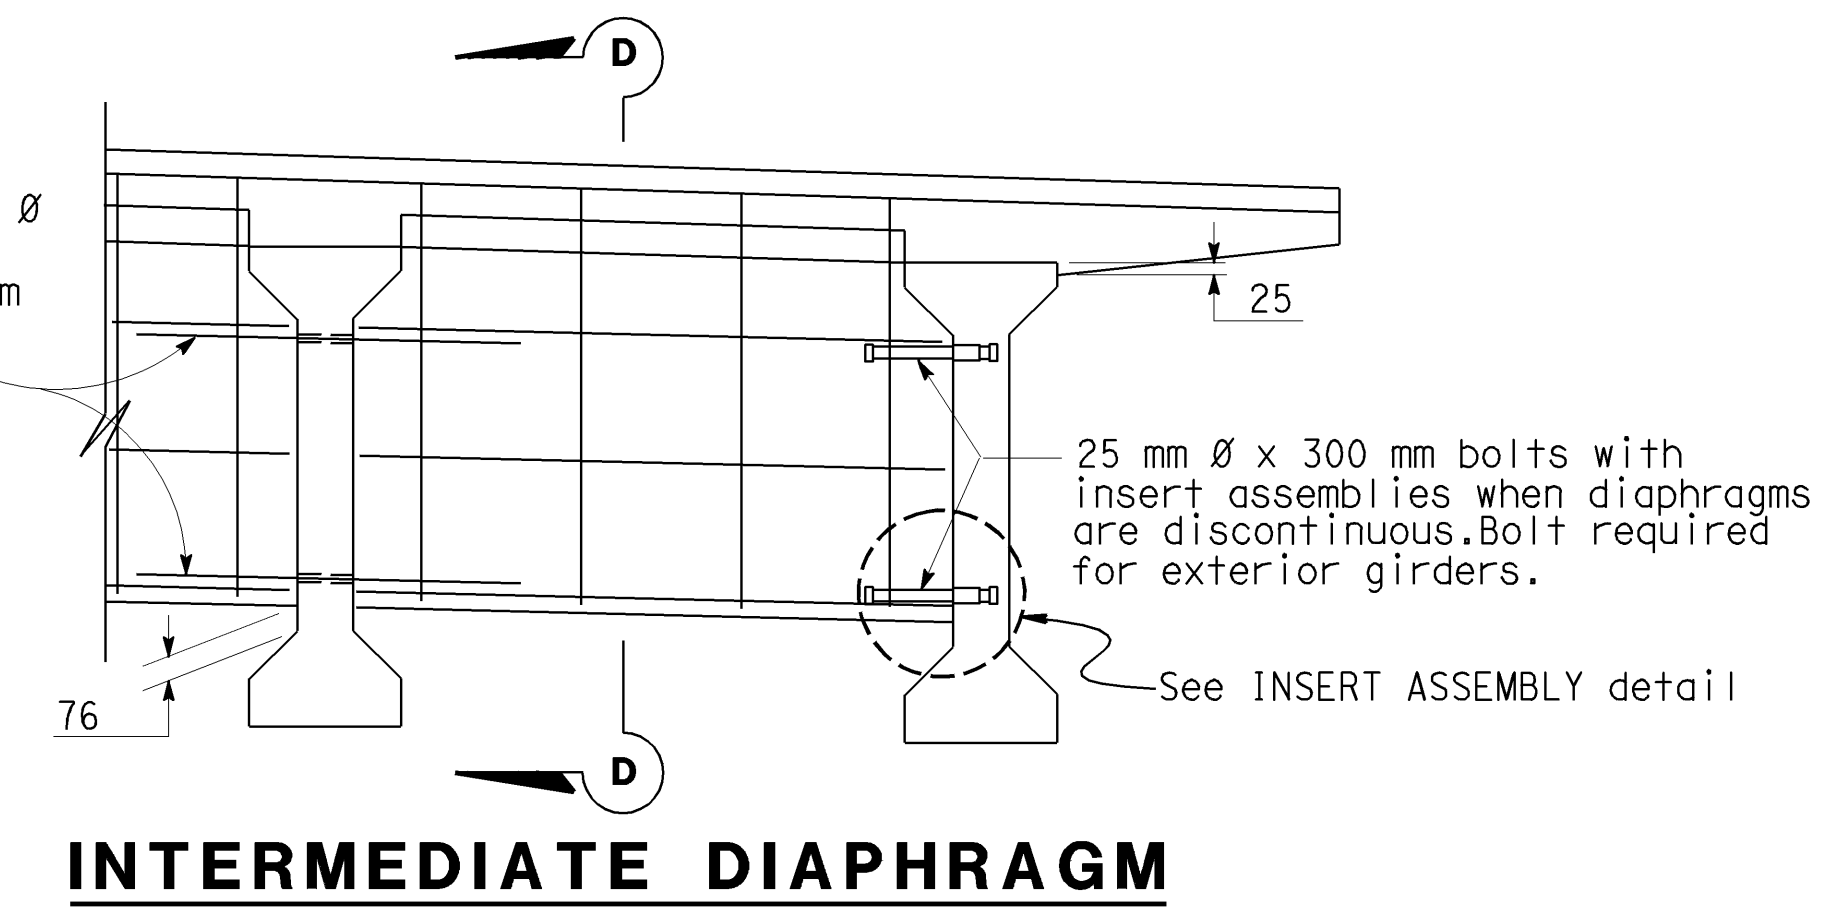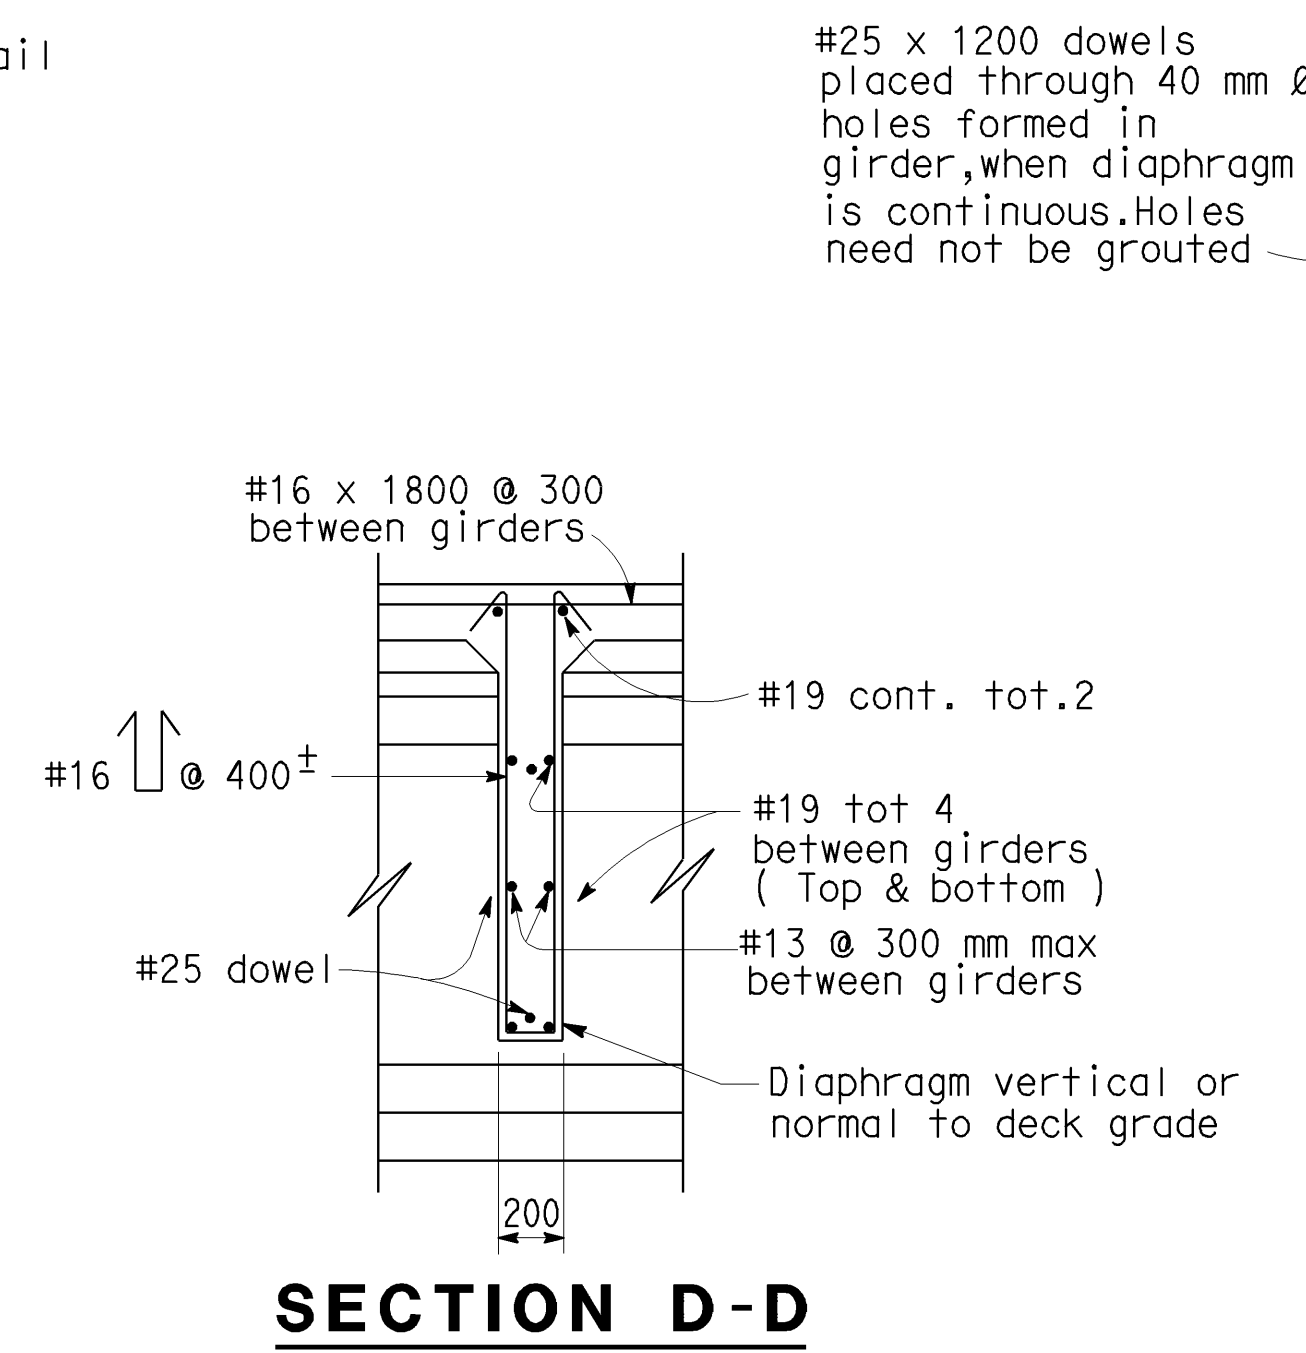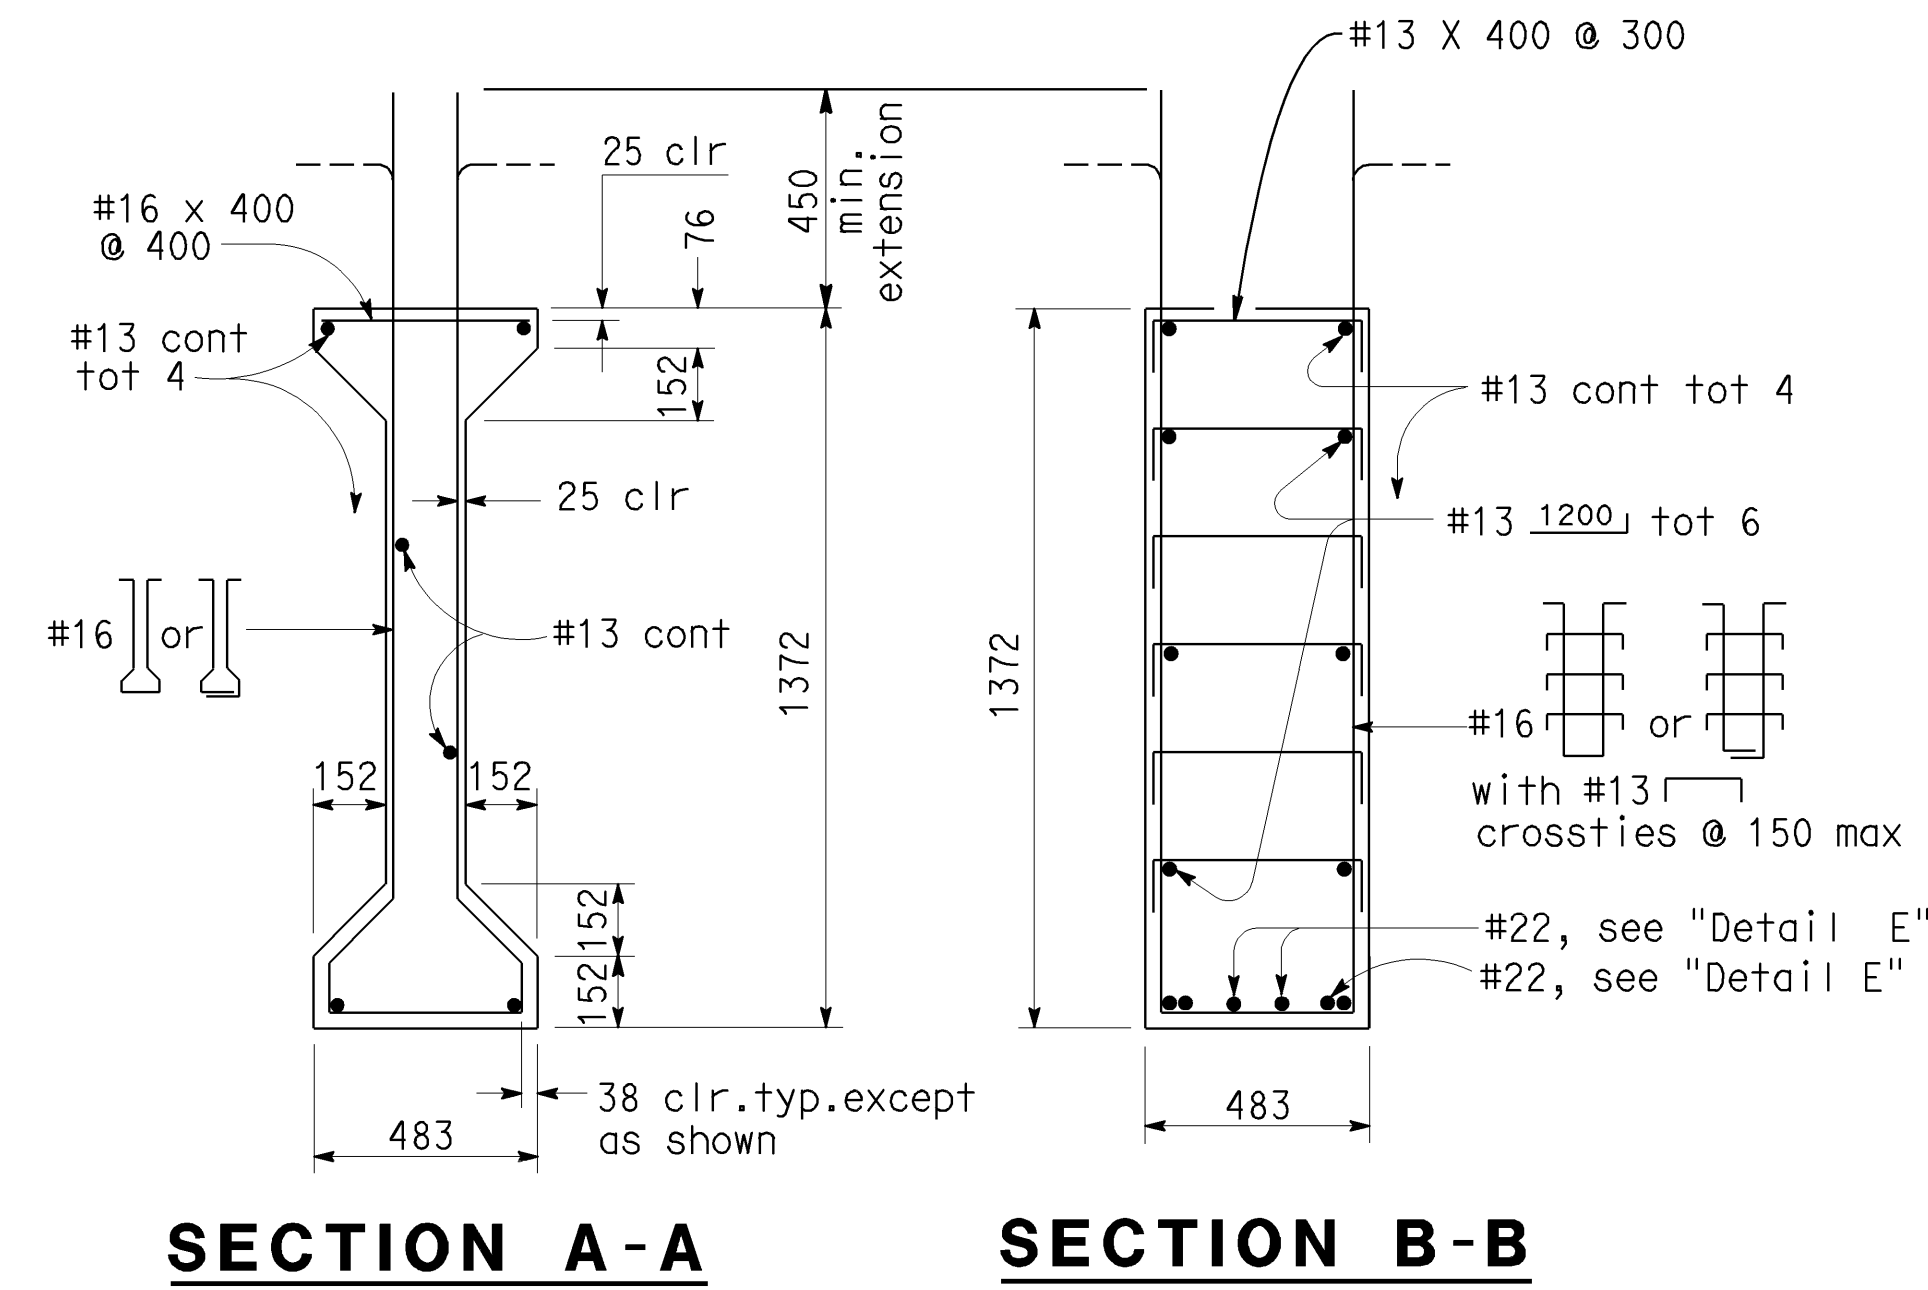

NOTE:  
 THE CONTRACTOR SHALL VERIFY ALL CONTROLLING FIELD DIMENSIONS BEFORE ORDERING OR FABRICATING ANY MATERIAL.

NO SCALE  
 ALL DIMENSIONS ARE IN MILLIMETERS UNLESS OTHERWISE SHOWN

DESIGN	BY Rangina Amir	CHECKED Arlene Frank	STATE OF CALIFORNIA DEPARTMENT OF TRANSPORTATION	DIVISION OF MAINTENANCE STRUCTURE MAINTENANCE DESIGN	BRIDGE NO.	PALO COMADO OC PRESTRESSED I GIRDER
DETAILS	BY Roelina Martinez	CHECKED Arlene Frank			53-1678	
QUANTITIES	BY Rangina Amir	CHECKED Arlene Frank			KILOMETER POST 54.2	

ORIGINAL SCALE IN MILLIMETERS FOR REDUCED PLANS

CU 07  
EA 4K3801

DISREGARD PRINTS BEARING EARLIER REVISION DATES

REVISION DATES (PRELIMINARY STAGE ONLY)

8-1-05	8-23-05	10-03-05	10-03-05	10-05-05
--------	---------	----------	----------	----------

SHEET 5 OF 7

CONTRACT NO: 07-4K3804  
 TRANSFER DATE: 07-15-2007  
 FIELD CORRECTION DATE: 11-15-2006

CORRECTIONS TRANSFERRED BY: BEM  
 A. Amboye  
 FIELD CORRECTIONS BY:

**NO AS BUILT CORRECTIONS**




DIST	COUNTY	ROUTE	KILOMETER POST TOTAL PROJECT	SHEET No	TOTAL SHEETS
07	LA	101	54.2	18	19

Michael J. Lee  
 REGISTERED CIVIL ENGINEER  
 3-20-06  
 PLANS APPROVAL DATE  
 No. C 42447  
 Exp. 3-31-08  
 CIVIL  
 STATE OF CALIFORNIA


The State of California or its officers or agents shall not be responsible for the accuracy or completeness of electronic copies of this plan sheet.

Caltrans now has a web site! To get to this site, go to: <http://www.dot.ca.gov>

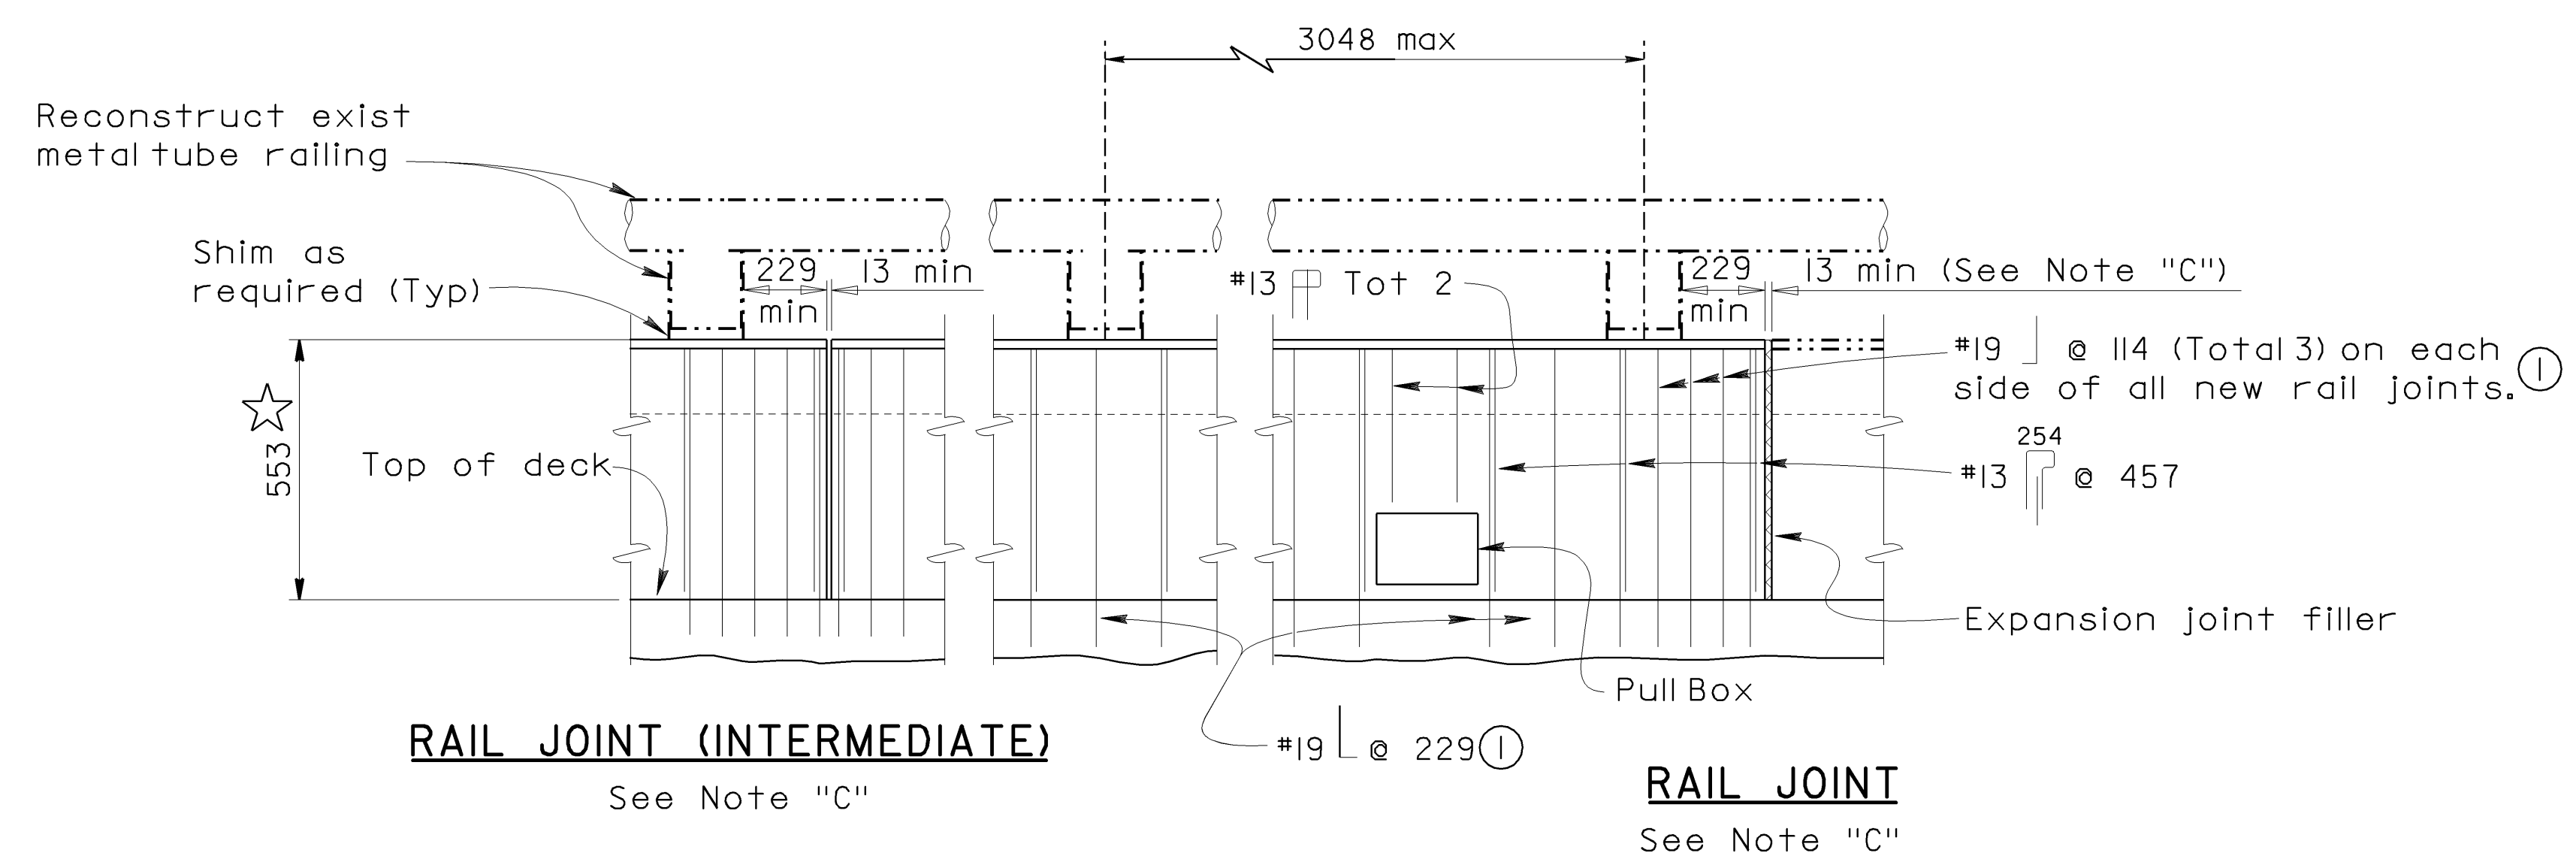


**BARRIER RAILING ELEVATION**  
NO SCALE


- NOTES: (Notes apply to this sheet only)
- A. Railing shall conform to horizontal and vertical alignment.
  - B. Posts shall be normal to railing.
  - C. New rail joint locations shall be similar to the existing locations (12 m max spacing). Joint size to be 6 mm min and increase to match deck joint + 6mm.
  - D. Dimension will vary with cross-slope of deck (match existing dimensions).
  - E. Clearance to reinforcing steel in curb and railing to be 25 mm. Longitudinal railing reinforcement to stop at all joints in the railing.
- ① Reinforcing to be in place before deck concrete is placed.
- ☆ Indicates match existing dimensions.

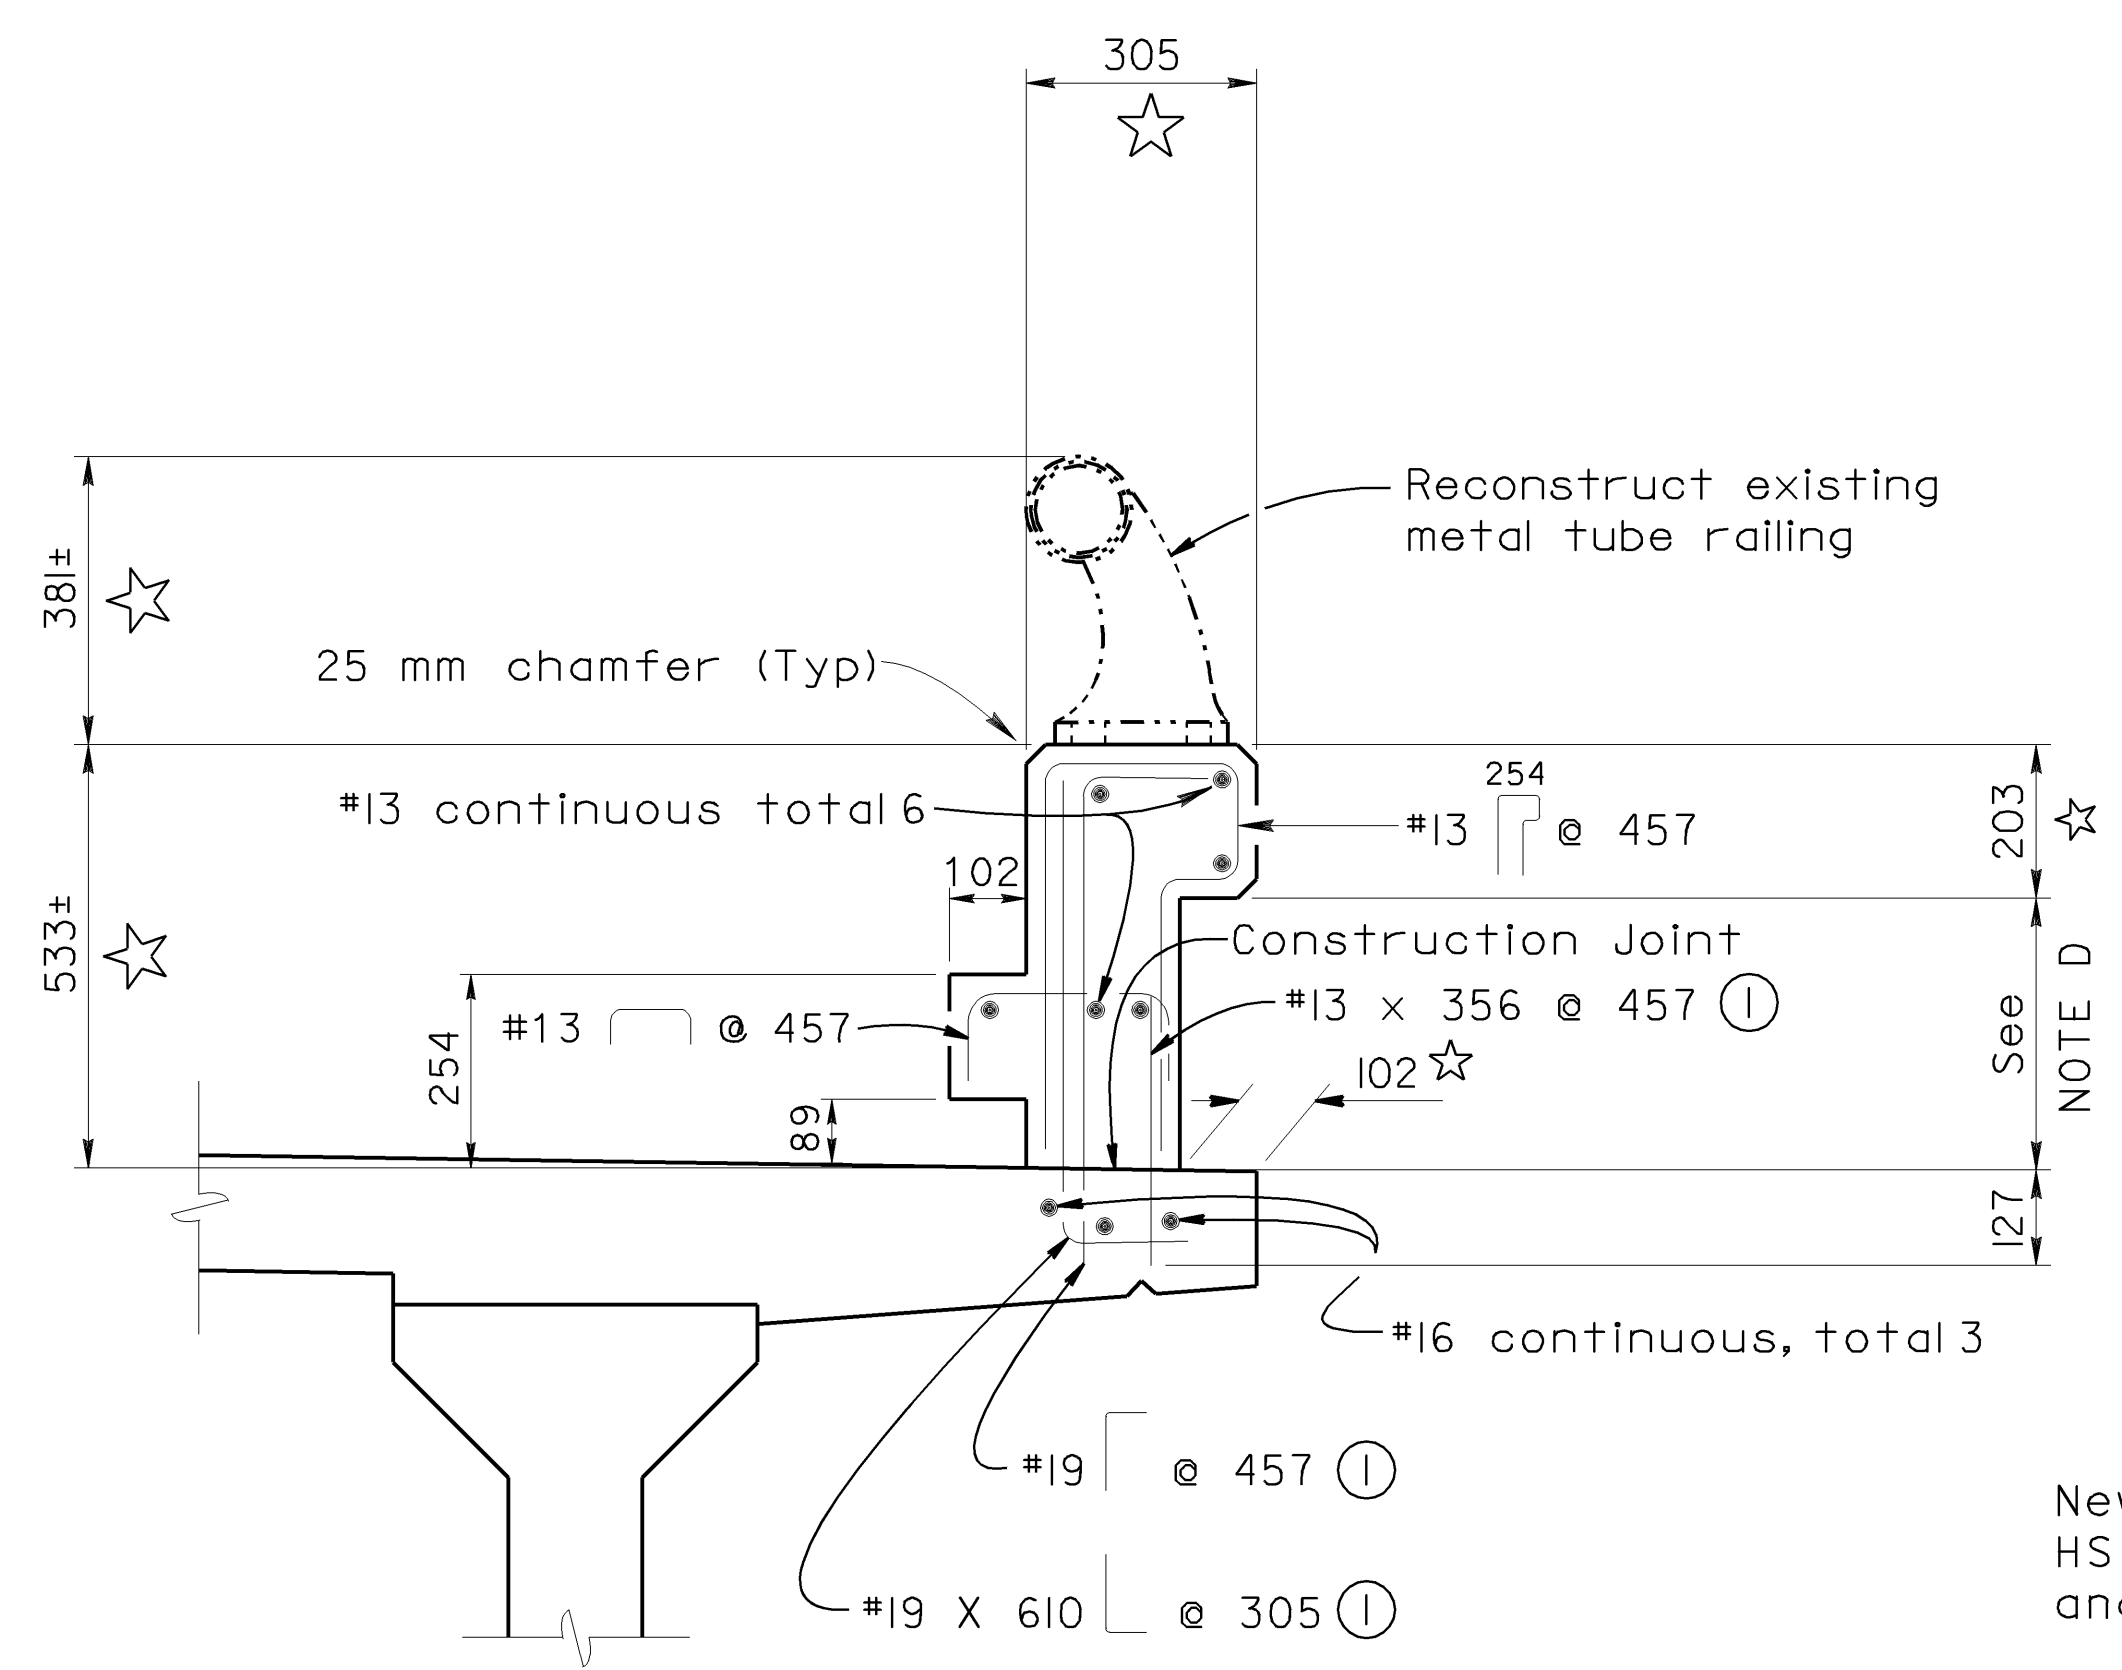

**BARRIER RAILING SECTION**  
NO SCALE

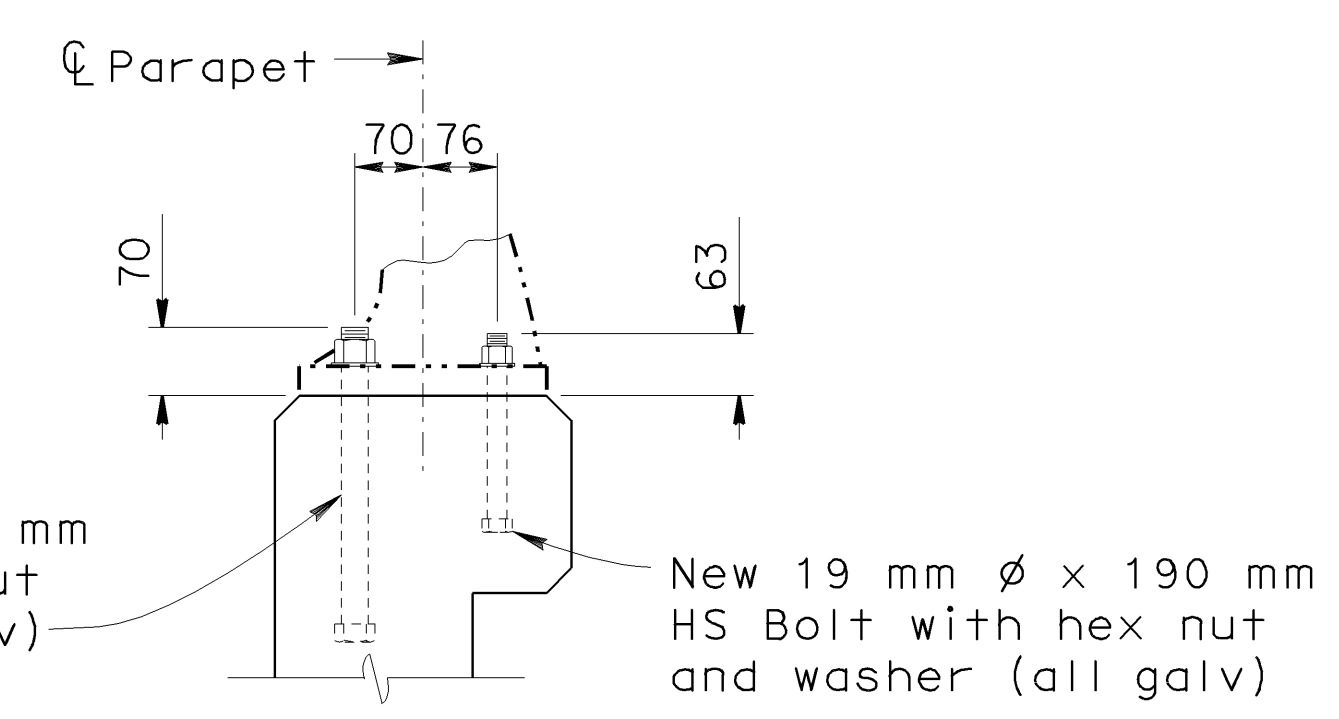

**RAIL POST ANCHOR BOLT DETAIL**  
NO SCALE

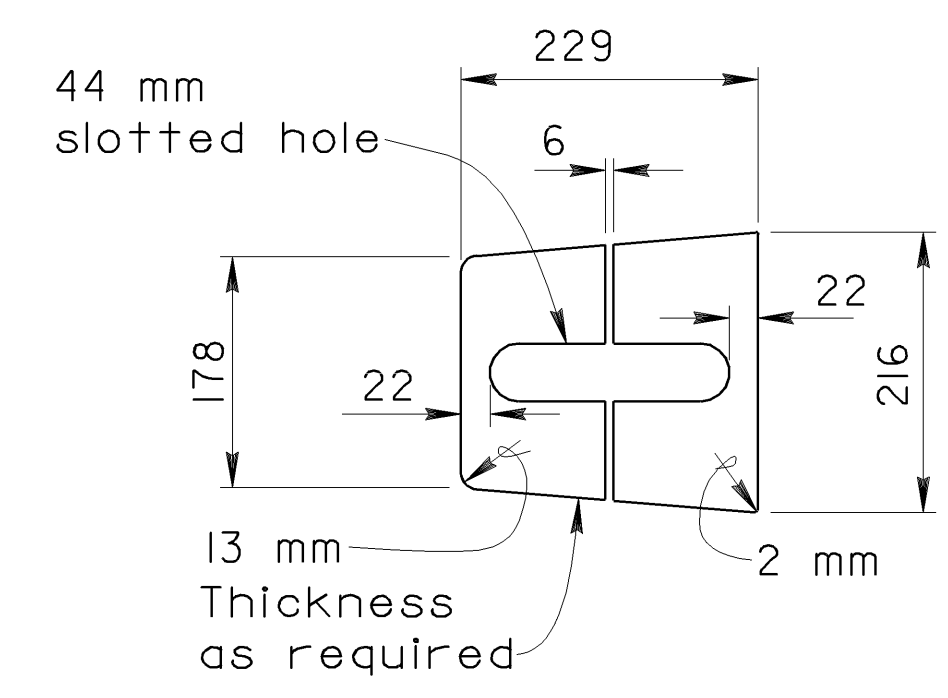

**SHIM DETAIL**  
NO SCALE

NOTE:  
 THE CONTRACTOR SHALL VERIFY ALL CONTROLLING FIELD DIMENSIONS BEFORE ORDERING OR FABRICATING ANY MATERIAL.

ALL DIMENSIONS ARE IN MILLIMETERS UNLESS OTHERWISE SHOWN

DESIGN BY Rangina Amir	CHECKED Arlene Frank	STATE OF CALIFORNIA DEPARTMENT OF TRANSPORTATION	DIVISION OF MAINTENANCE STRUCTURE MAINTENANCE DESIGN	BRIDGE NO. 53-1678	PALO COMADO OC CONCRETE BARRIER (TYPE 1) DETAILS
DETAILS BY Roelina Martinez	CHECKED Arlene Frank		KILOMETER POST 54.2		
QUANTITIES BY Rangina Amir	CHECKED Arlene Frank				

ORIGINAL SCALE IN MILLIMETERS FOR REDUCED PLANS

0 10 20 30 40 50 60 70 80 90 100

CU 07  
EA 4K3801


DISREGARD PRINTS BEARING EARLIER REVISION DATES

REVISION DATES (PRELIMINARY STAGE ONLY)

7-27-05	10-03-05								
---------	----------	--	--	--	--	--	--	--	--

SHEET 6 OF 7

DATE PLOTTED => 26-JUL-2007  
 USERNAME => bml11er

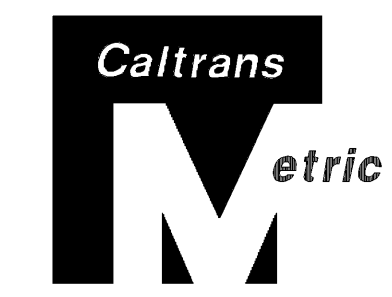

DIST	COUNTY	ROUTE	KILOMETER POST TOTAL PROJECT	SHEET No	TOTAL SHEETS
07	LA	101	54.2	19	19

Michael J. Lee  
 REGISTERED CIVIL ENGINEER

3-20-06  
 PLANS APPROVAL DATE


No. C 42447  
 Exp. 3-31-08  
 CIVIL  
 STATE OF CALIFORNIA

*The State of California or its officers or agents shall not be responsible for the accuracy or completeness of electronic copies of this plan sheet.*


Caltrans now has a web site! To get to this site, go to: <http://www.dot.ca.gov>

NOTES: (APPLY TO THIS SHEET ONLY)

- ① Remove and reinstall existing structure mounted sign and all brackets and hardware except where shown otherwise and as directed by the Engineer.
  - ② New 15.9 mm  $\phi$  non-corrodible expansion anchor with hex head nut and washer; with 127 mm embedment. Pull out value 26.7 kN per anchor.
  - ③ New 2 - 15.9 mm  $\phi$  non-corrodible expansion anchors with hex head nuts and washers; with 127 mm embedment. Pull out value 26.7 kN per anchor.
  - ④ Existing 38 mm x 19 mm slotted hole for new expansion anchor.
  - ⑤ Existing 76 mm x 15.9 mm slotted hole for existing 12.7 mm  $\phi$  hex head bolt, nut, flat washer and lock washer.
  - ⑥ Existing 51 mm x 19 mm slotted hole for new expansion anchor.
  - ⑦ Existing hole for existing 15.9 mm  $\phi$  hex head bolt with nut and lockwasher.
- For PC/PS I Girder and deck reinforcement placement notes, see **B0-5**

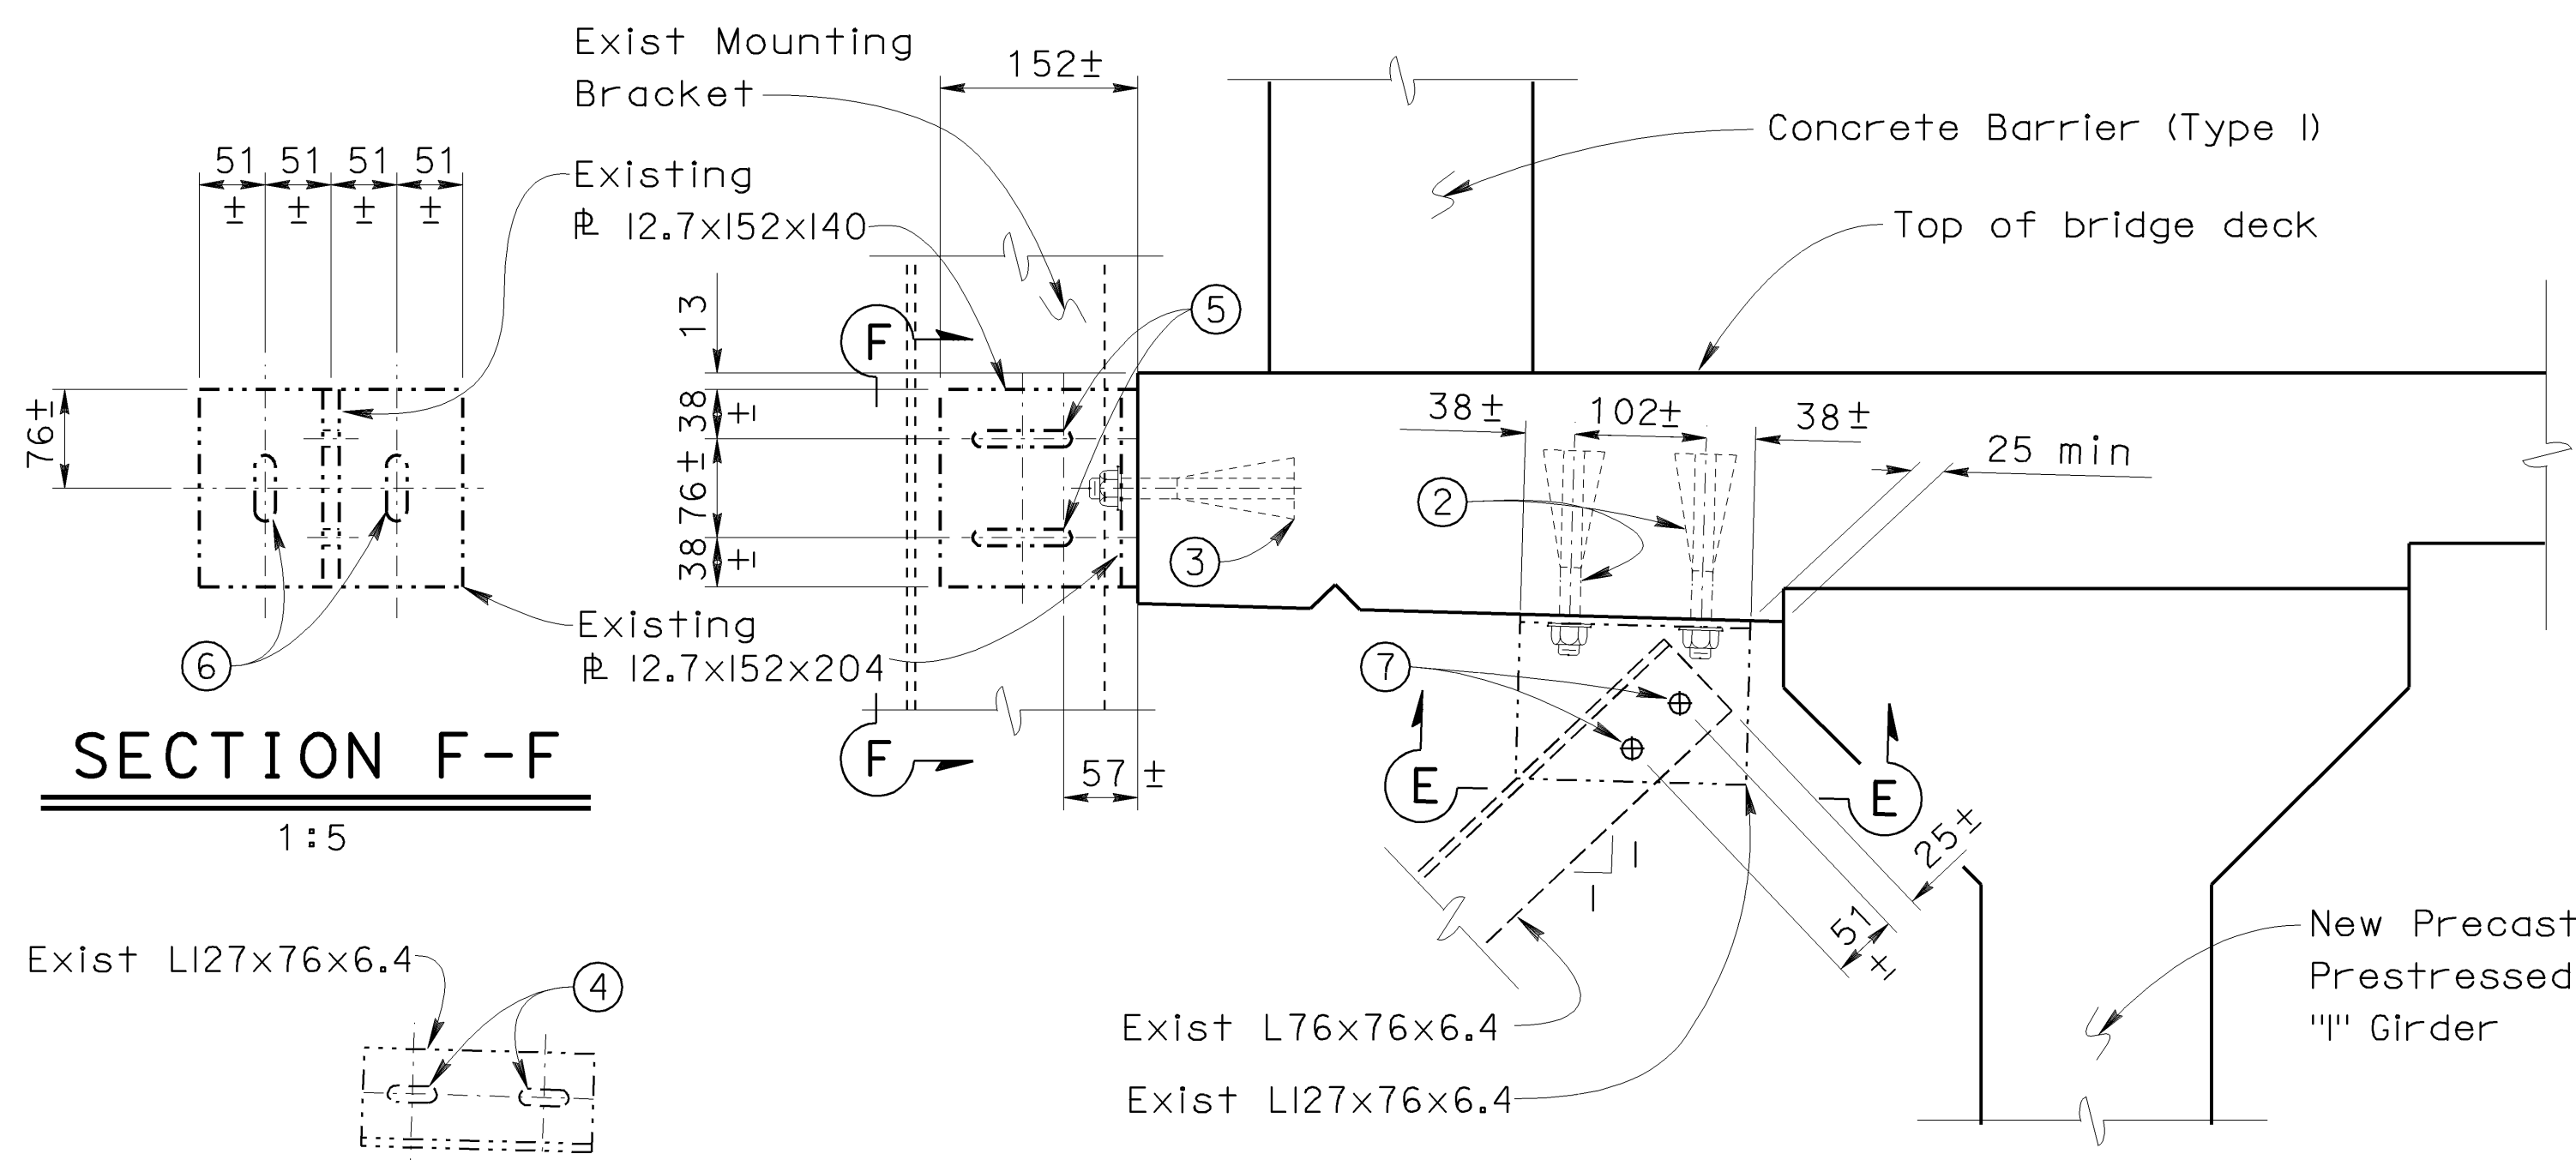


**SECTION F-F**  
 1:5

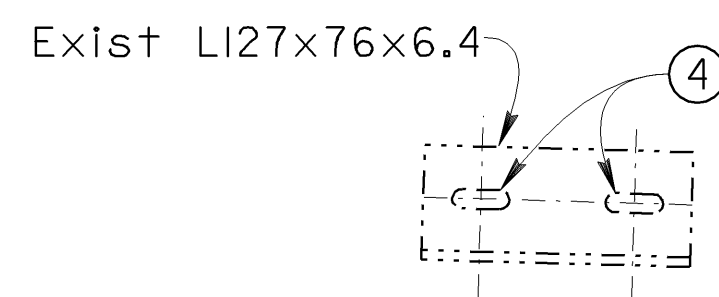

**SECTION E-E**  
 1:5

**EXISTING STRUCTURE MOUNTED SIGN ANCHORAGE DETAIL**  
 NO SCALE

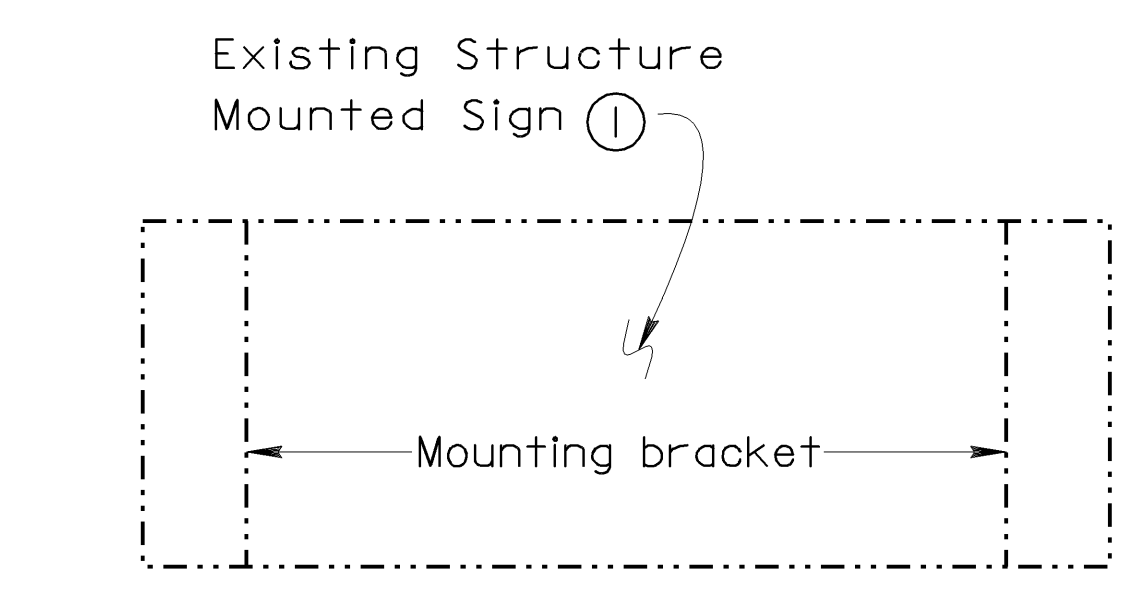

**EXISTING STRUCTURE MOUNTED SIGN MOUNTING BRACKET LOCATIONS (TOTAL 2)**  
 NO SCALE

NOTE:  
 THE CONTRACTOR SHALL VERIFY ALL CONTROLLING FIELD DIMENSIONS BEFORE ORDERING OR FABRICATING ANY MATERIAL.

ALL DIMENSIONS ARE IN MILLIMETERS UNLESS OTHERWISE SHOWN

DESIGN BY Rangina Amir	CHECKED Arlene Frank	STATE OF CALIFORNIA DEPARTMENT OF TRANSPORTATION	DIVISION OF MAINTENANCE STRUCTURE MAINTENANCE DESIGN	BRIDGE NO. 53-1678	PALO COMADO OC SIGN DETAILS
DETAILS BY Roelina Martinez	CHECKED Arlene Frank			KILOMETER POST 54.2	
QUANTITIES BY Rangina Amir	CHECKED Arlene Frank				

ORIGINAL SCALE IN MILLIMETERS FOR REDUCED PLANS: 0 10 20 30 40 50 60 70 80 90 100

CU 07  
 EA 4K3801

DISREGARD PRINTS BEARING EARLIER REVISION DATES

REVISION DATES (PRELIMINARY STAGE ONLY)	SHEET	OF
8-24-05 10-05-05	7	7

FILE => 074k38007sign.dgn



*APPENDIX C*  
*CALTRANS COMMENTS AND RESPONSES*

---



Certified MBE

Geotechnical Engineering

Geology

Hydrogeology

Earthquake Engineering

Materials Testing &  
Inspection

Forensic Services

February 5, 2008

Parsons Transportation Group  
2201 Dupont Drive Suite 200  
Irvine, CA 92612

Attention: Mr. Thomas E. Sardo

Subject: Response to Caltrans Review Comments  
Preliminary Foundation Report dated 02/02/08  
Palo Comado OC a.k.a. Chesebro Rd OC (Widen)  
Bridge No. 53-1678  
07-LA-101-PM 33.69  
Agoura Hills, California  
GDC Project No. L-783

Dear Mr. Sardo:

Group Delta Consultants is pleased to submit our responses to Caltrans comments on our Preliminary Foundation Report dated January 2, 2008. The comments are included as Attachment 1, and are addressed in order below.

### 1. Section 4.3 Ground Motion

- Please verify deterministic PBA value for MMR fault with Reverse/Oblique. The PBA calculated using Sadigh (1997) should be 0.43g instead of 0.47g

We concur with the reviewer. We used Sadigh (1997) relationship for Reverse/Thrust fault which gives 0.47g. We have modified the report using Geomatrix / Sadigh (1997) for Reverse/Oblique, which gives 0.43g. We still recommend the same ARS curve.

### 2. Section 5.2.1 Axial Pile Capacities

- Please verify the minimum spacing requirement for group action. The spacing may vary depending on pile types such as driven pile or CIDH pile, and soil types.

The CIDH piles are tipped in Bedrock, estimated friction is likely conservative, and end bearing is ignored. Therefore, it is our opinion that no reduction in axial capacity is necessary for group action with minimum 2.5 diameter spacing.

This response is attached to the revised report as Appendix C. The following is attached and completes our response:

Attachment 1 Caltrans Comments dated January 13, 2009

We appreciate the opportunity to be a part of your design team for this project. If you have any questions or require additional information, please give us a call at (949) 609-1020.

Sincerely,  
**GROUP DELTA CONSULTANTS, INC.**



Curt Scheyhing, P.E., G.E.  
Senior Geotechnical Engineer



Kul Bhushan, Ph.D., G.E.  
Sr. Consulting Principal



Distribution: Addressee (1 electronic PDF file via e-mail)



*ATTACHMENT 1*  
*CALTRANS COMMENTS DATED JANUARY 13, 2009*

---



GEOTECHNICAL DESIGN REPORT REVIEW

DIVISION OF ENGINEERING SERVICES  
GEOTECHNICAL SERVICES

TO: RICHARD HARTZELL, P.E.  
Office of Special Funded Projects

DATE: January 13, 2009

FILE: 07 LA 110 33.69  
District County Route Post Mile

FDN REPORT BY: Group Delta Consultants DATED: Jan. 2, 2008 Palo Comado Canyon Rd. OC (Widen)  
Structure Name

GENERAL PLAN DATED: FDN PLAN DATED: 07-25720K 53-1678  
EA Number Bridge Number

Submittal (Check One):  1<sup>st</sup>  2<sup>nd</sup>  3<sup>rd</sup>  4<sup>th</sup>  Other: \_\_\_\_\_

This Office has review the following item provided by Group Delta Consultants:

1. Preliminary Foundation Report, Palo Comado OC a.k.a. Chesebro Rd. OC (Widen), Los Angeles County, California, prepared by Group Delta Consultants, dated January 2, 2008.

The following are the review comments:

1. Section 4.3 Ground Motion
  - Please verify deterministic PBA value for MMR fault with **Reversre/Oblique**. The PBA calculated using Sadigh (1997) should be 0.43g instead of 0.47g
2. Section 5.2.1 Axial Pile Capacities
  - Please verify the minimum spacing requirement for group action. The spacing may vary depending on pile types such as driven pile or CIDH pile, and soil types.

The report should be revised based on the Foundation Review Comments and Responses, and all responses to Caltrans Foundation Review Comments should be attached to the final foundation report as an Appendix. The review is limited to the geotechnical engineering aspects of the project. Should you have any question and comment, please contact Seungwoon Han at (916) 227-4533.

Approval: approved with following conditions – OSFD should confirm the corrections to be made by the Consultant

Reviewer's Name Seungwoon Han, Ph.D., P.E.  
Office of Geotechnical Design South - 1

Office of Special Funded Projects